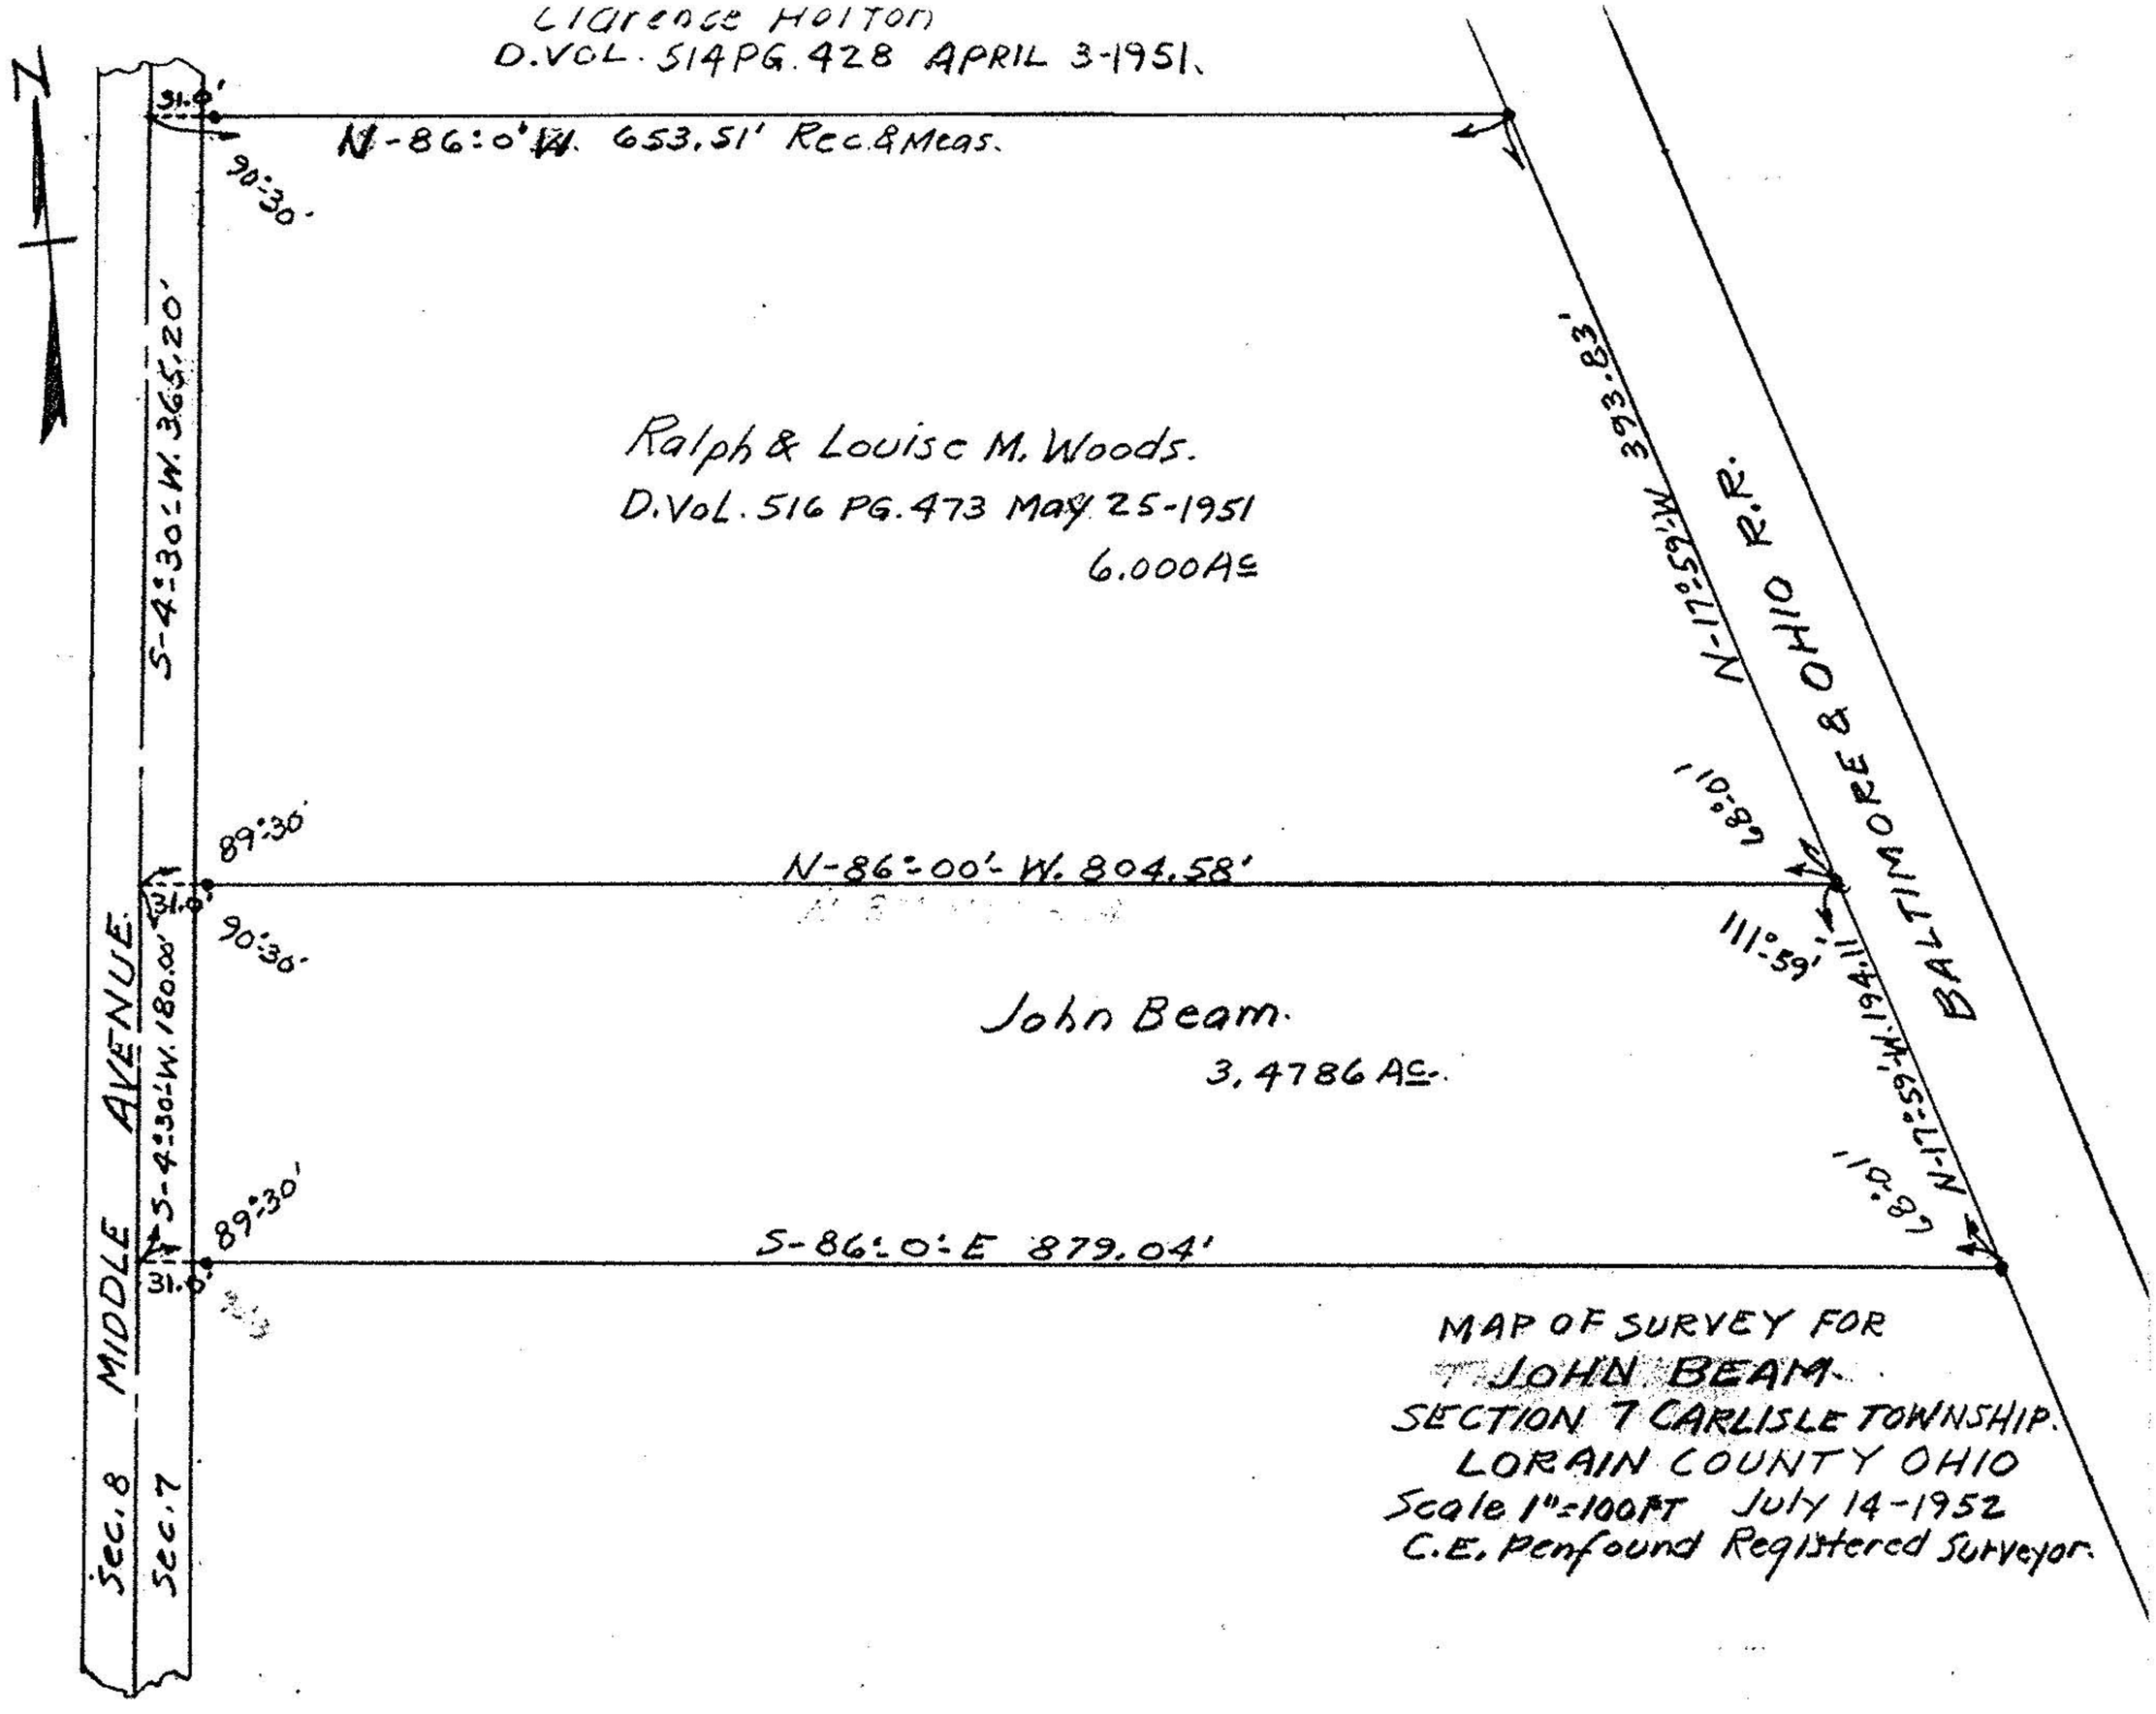
Clarence Holton
D.VOL. 514 PG. 428 APRIL 3-1951.
N
31.0'
N-86:0'W. 653.51' Rec.&Meas.
90°30'
S-4°30'-W. 365.20'
Ralph & Louise M. Woods.
D.Vol. 516 PG. 473 May 25-1951
6.000 Ac
N-17°59'-W 393.83'
BALTIMORE & OHIO R.R.
68°01'
89°30'
N-86°00'-W. 804.58'
31.0'
90°30'
111°59'
John Beam.
3.4786 Ac.
S-4°30'-W. 180.00'
N-17°59'-W. 194.11'
68°01'
89°30'
S-86°0'-E 879.04'
31.0'
MIDDLE AVENUE
Sec. 8
Sec. 7
MAP OF SURVEY FOR
JOHN BEAM
SECTION 7 CARLISLE TOWNSHIP.
LORAIN COUNTY OHIO
Scale 1"=100FT July 14-1952
C.E. Penfound Registered Surveyor.