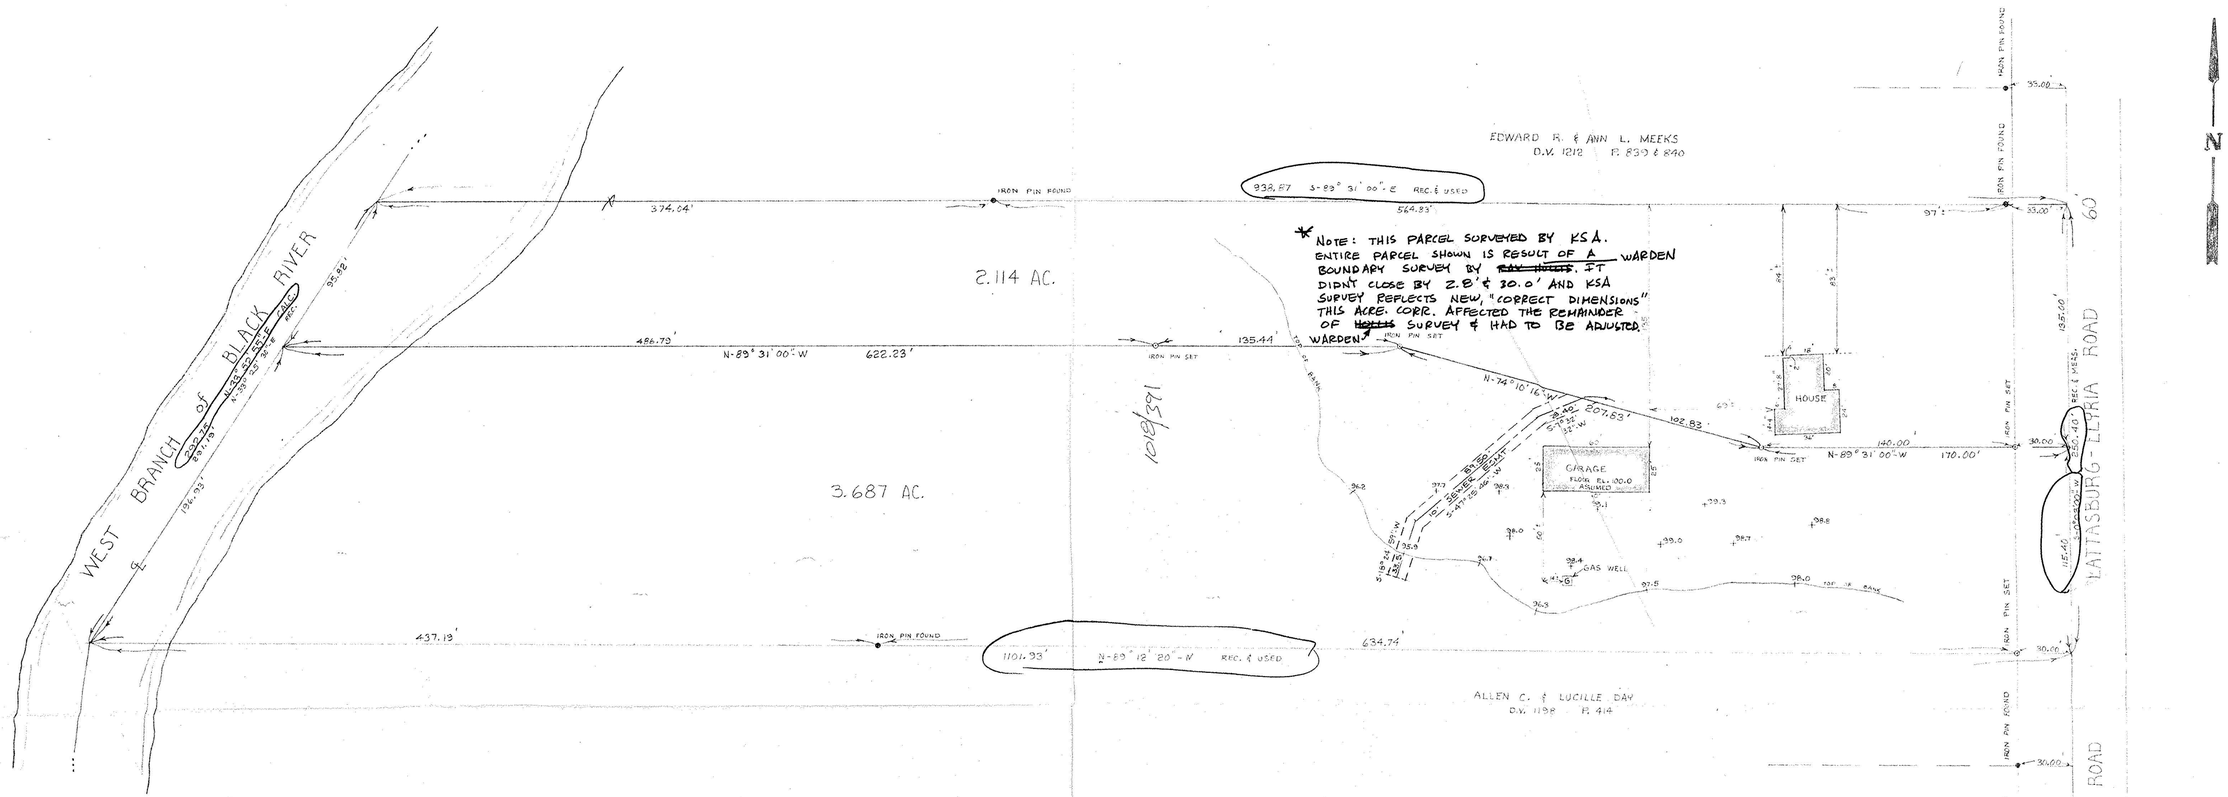

SURVEY MAP

of

PART of CARLISLE TOWNSHIP
SECTION NUMBER 8

IN

TOWNSHIP of CARLISLE, COUNTY of LORAIN, STATE of OHIO

SCALE: 1" = 40'

DATE: 4-25-79
REV. TO SHOW PCL. SPLIT - 7-12-79 K.V.S.
REV. 4-21-86: SEWER ESMT.

PREPARED BY

KLEINOEDER-SCHMIDT & ASSOC.

CONSULTING ENGINEERS & SURVEYORS
424 MIDDLE AVE. ELYRIA, OHIO

PREPARED FOR

JOHN SARNOVSKY

* NOTE: THIS PARCEL SURVEYED BY KSA. ENTIRE PARCEL SHOWN IS RESULT OF A WARDEN BOUNDARY SURVEY BY ~~RAY HOLLS~~. IT DIDN'T CLOSE BY 2.8' & 30.0' AND KSA SURVEY REFLECTS NEW, "CORRECT DIMENSIONS" THIS ACRE. CORR. AFFECTED THE REMAINDER OF ~~HOLLS~~ SURVEY & HAD TO BE ADJUSTED. WARDEN

5.80 A. TOT.
- 2.11 A. EXCEPT.
3.69 A. REM.

#16789
APPROVED
LORAIN CO.
MAP DEPT.
DATE 6-19-86
PAGE 10-00-008-B
BY T. McNair
VOID AFTER

#16789
APPROVED
LORAIN CO.
MAP DEPT.
DATE 6-17-86
PAGE 10-00-008-B
BY T. McNair
VOID AFTER

77-392 K.V.S.