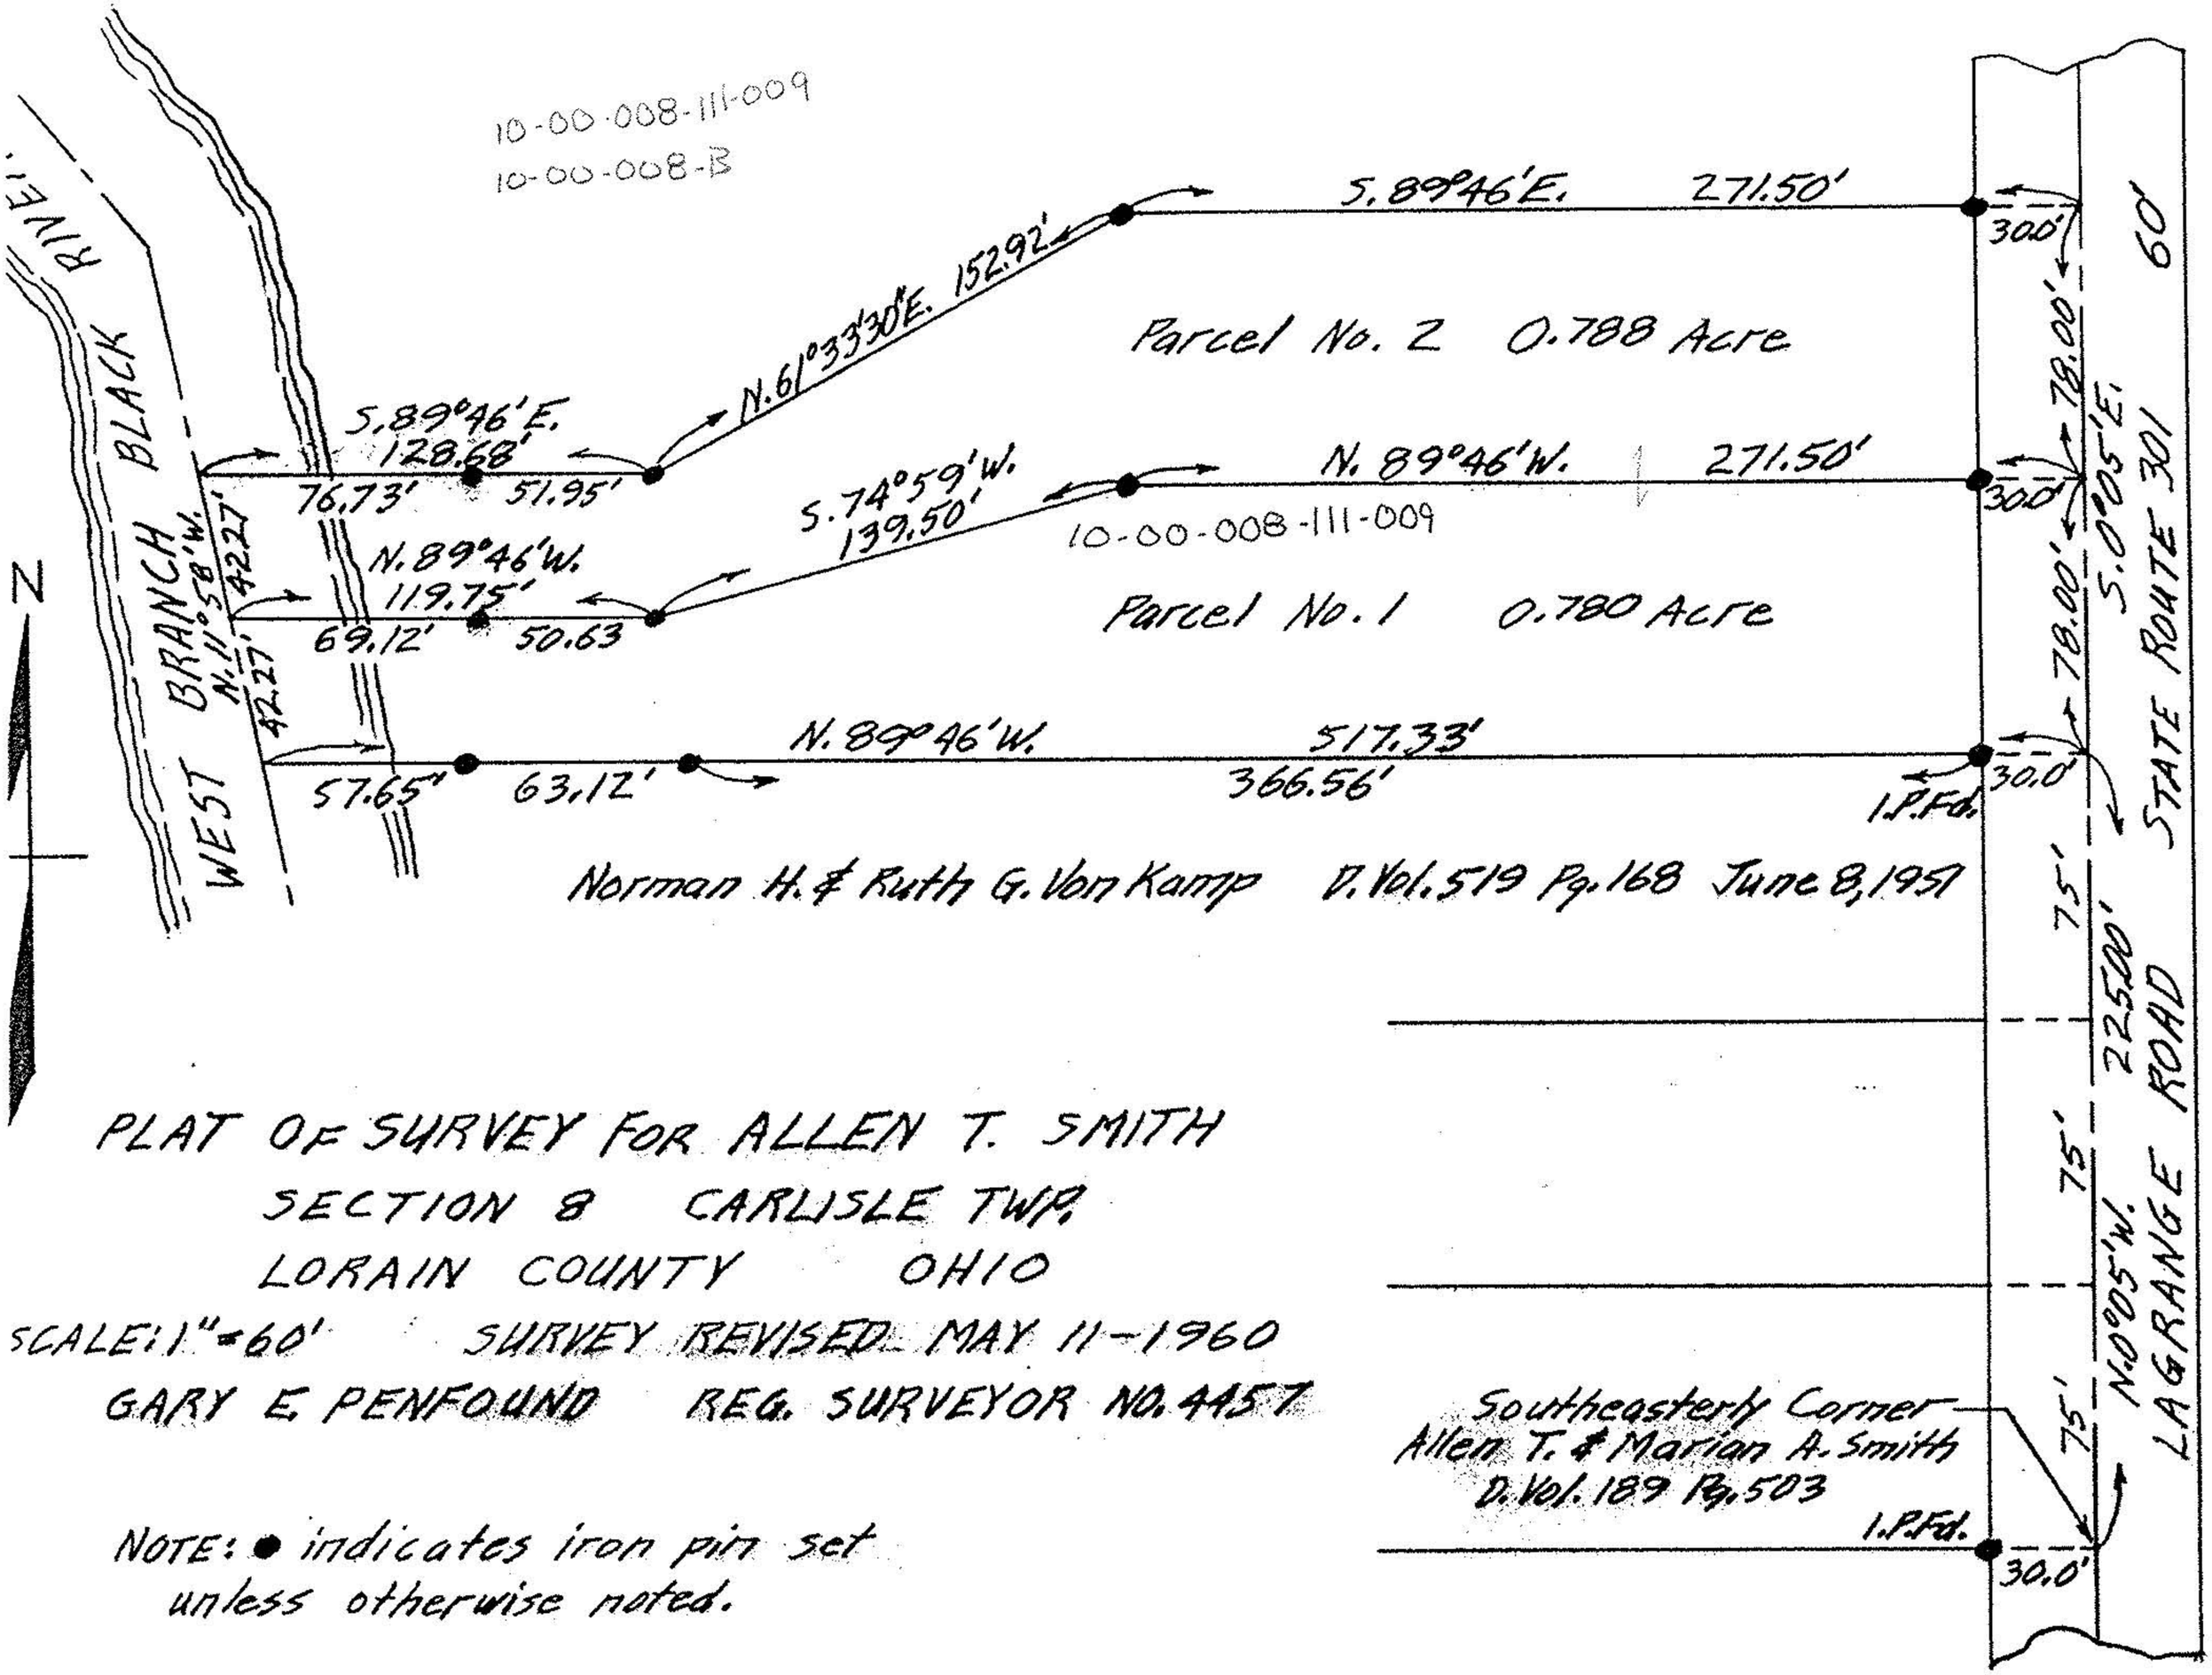

PLAT OF SURVEY FOR ALLEN T. SMITH
SECTION 8 CARLISLE TWP.
LORAIN COUNTY OHIO

SCALE: 1" = 60' SURVEY REVISED MAY 11-1960
GARY E. PENFOUND REG. SURVEYOR NO. 4457

NOTE: ● indicates iron pin set unless otherwise noted.