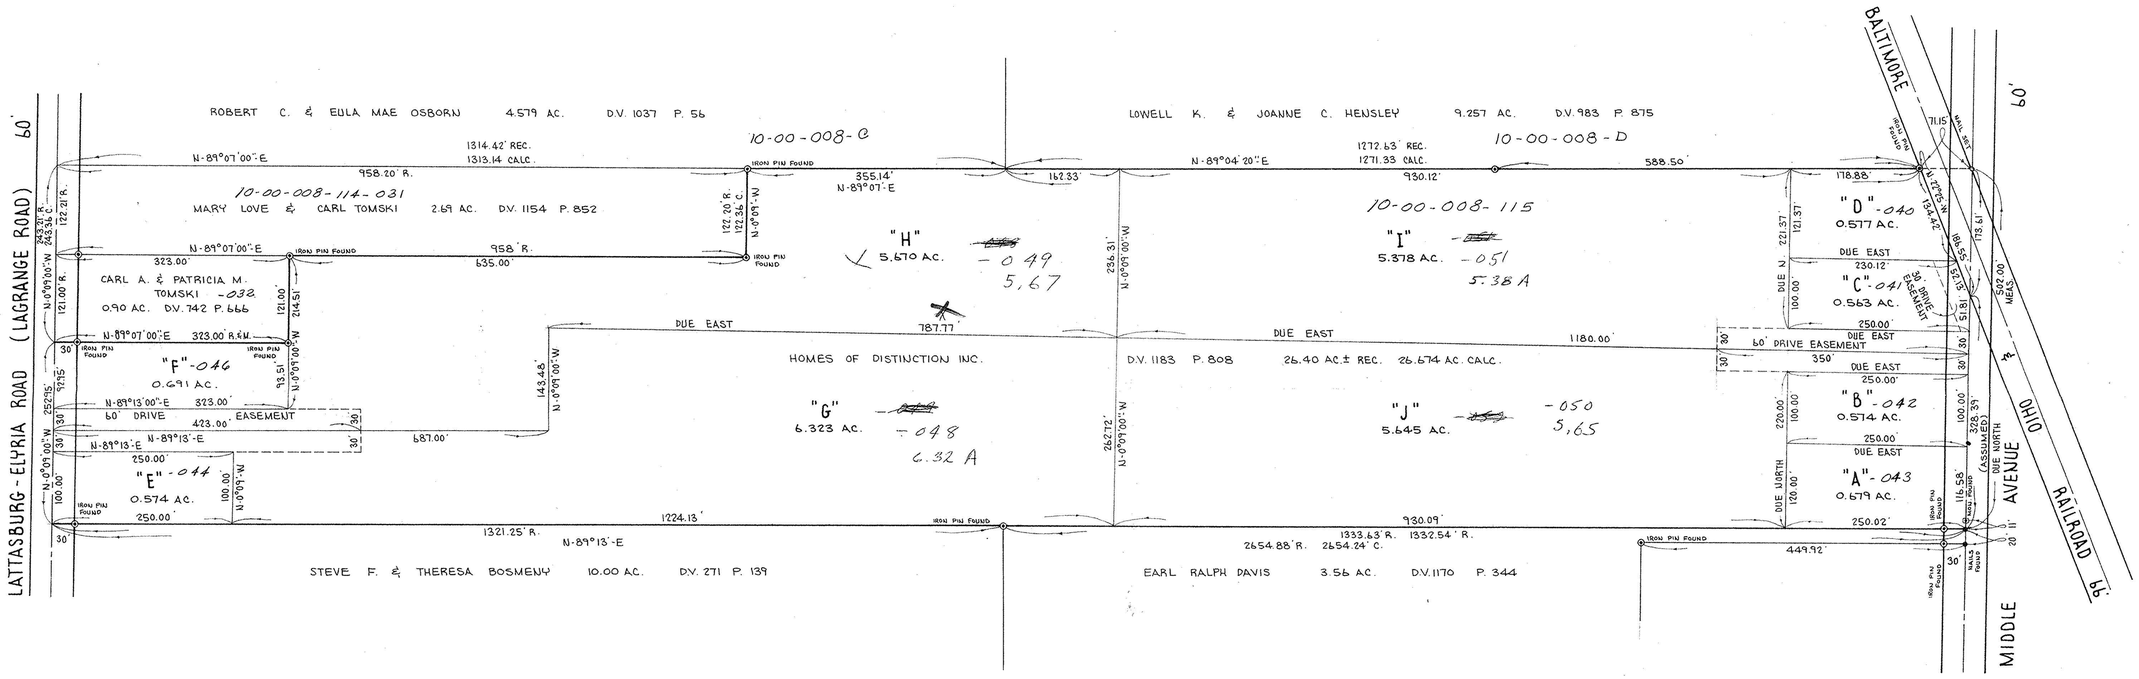

#11948

APPROVED
LORAIN CO.
MAP DEPT.
DATE 9-18-78
PAGE 10-00-008-C-D
BY Carolyn
VOID AFTER 11948

BOUNDARY SURVEY OF PART OF CARLISLE TOWNSHIP
SECTION Nº 8

TOWNSHIP OF CARLISLE COUNTY OF LORAIN STATE OF OHIO

SCALE: 1" = 100' SEPT. 6, 1978

PREPARED BY
KLEINOEDER-SCHMIDT & ASSOC.
CONSULTING ENGINEERS & SURVEYORS

77-260