PROPERTY OWNERS

-001 LEONARD G. OLDFIELD 1393/438
-010 HELENE V. BREUDIGAM 1233/70
-009 LISA CRIST 1345/139
-008 DAVID FLOYD & BARBARA SUE LEAR O.R. 51/382
-007 JOSEPH F. HODNEY & BRENDA C. HYLTON 1219/942
-005 JOHN A. KENSHA 1186/248
-003 TERRY L. & MARY K. BRUNGER 1343/362
-004 DOUGLAS D. & JEANETTE KENSHA WAHL 130/463

BENCH MARK —
COPPER WELD IRON PIN
IN MON. BOX
ELEV. = 755.09

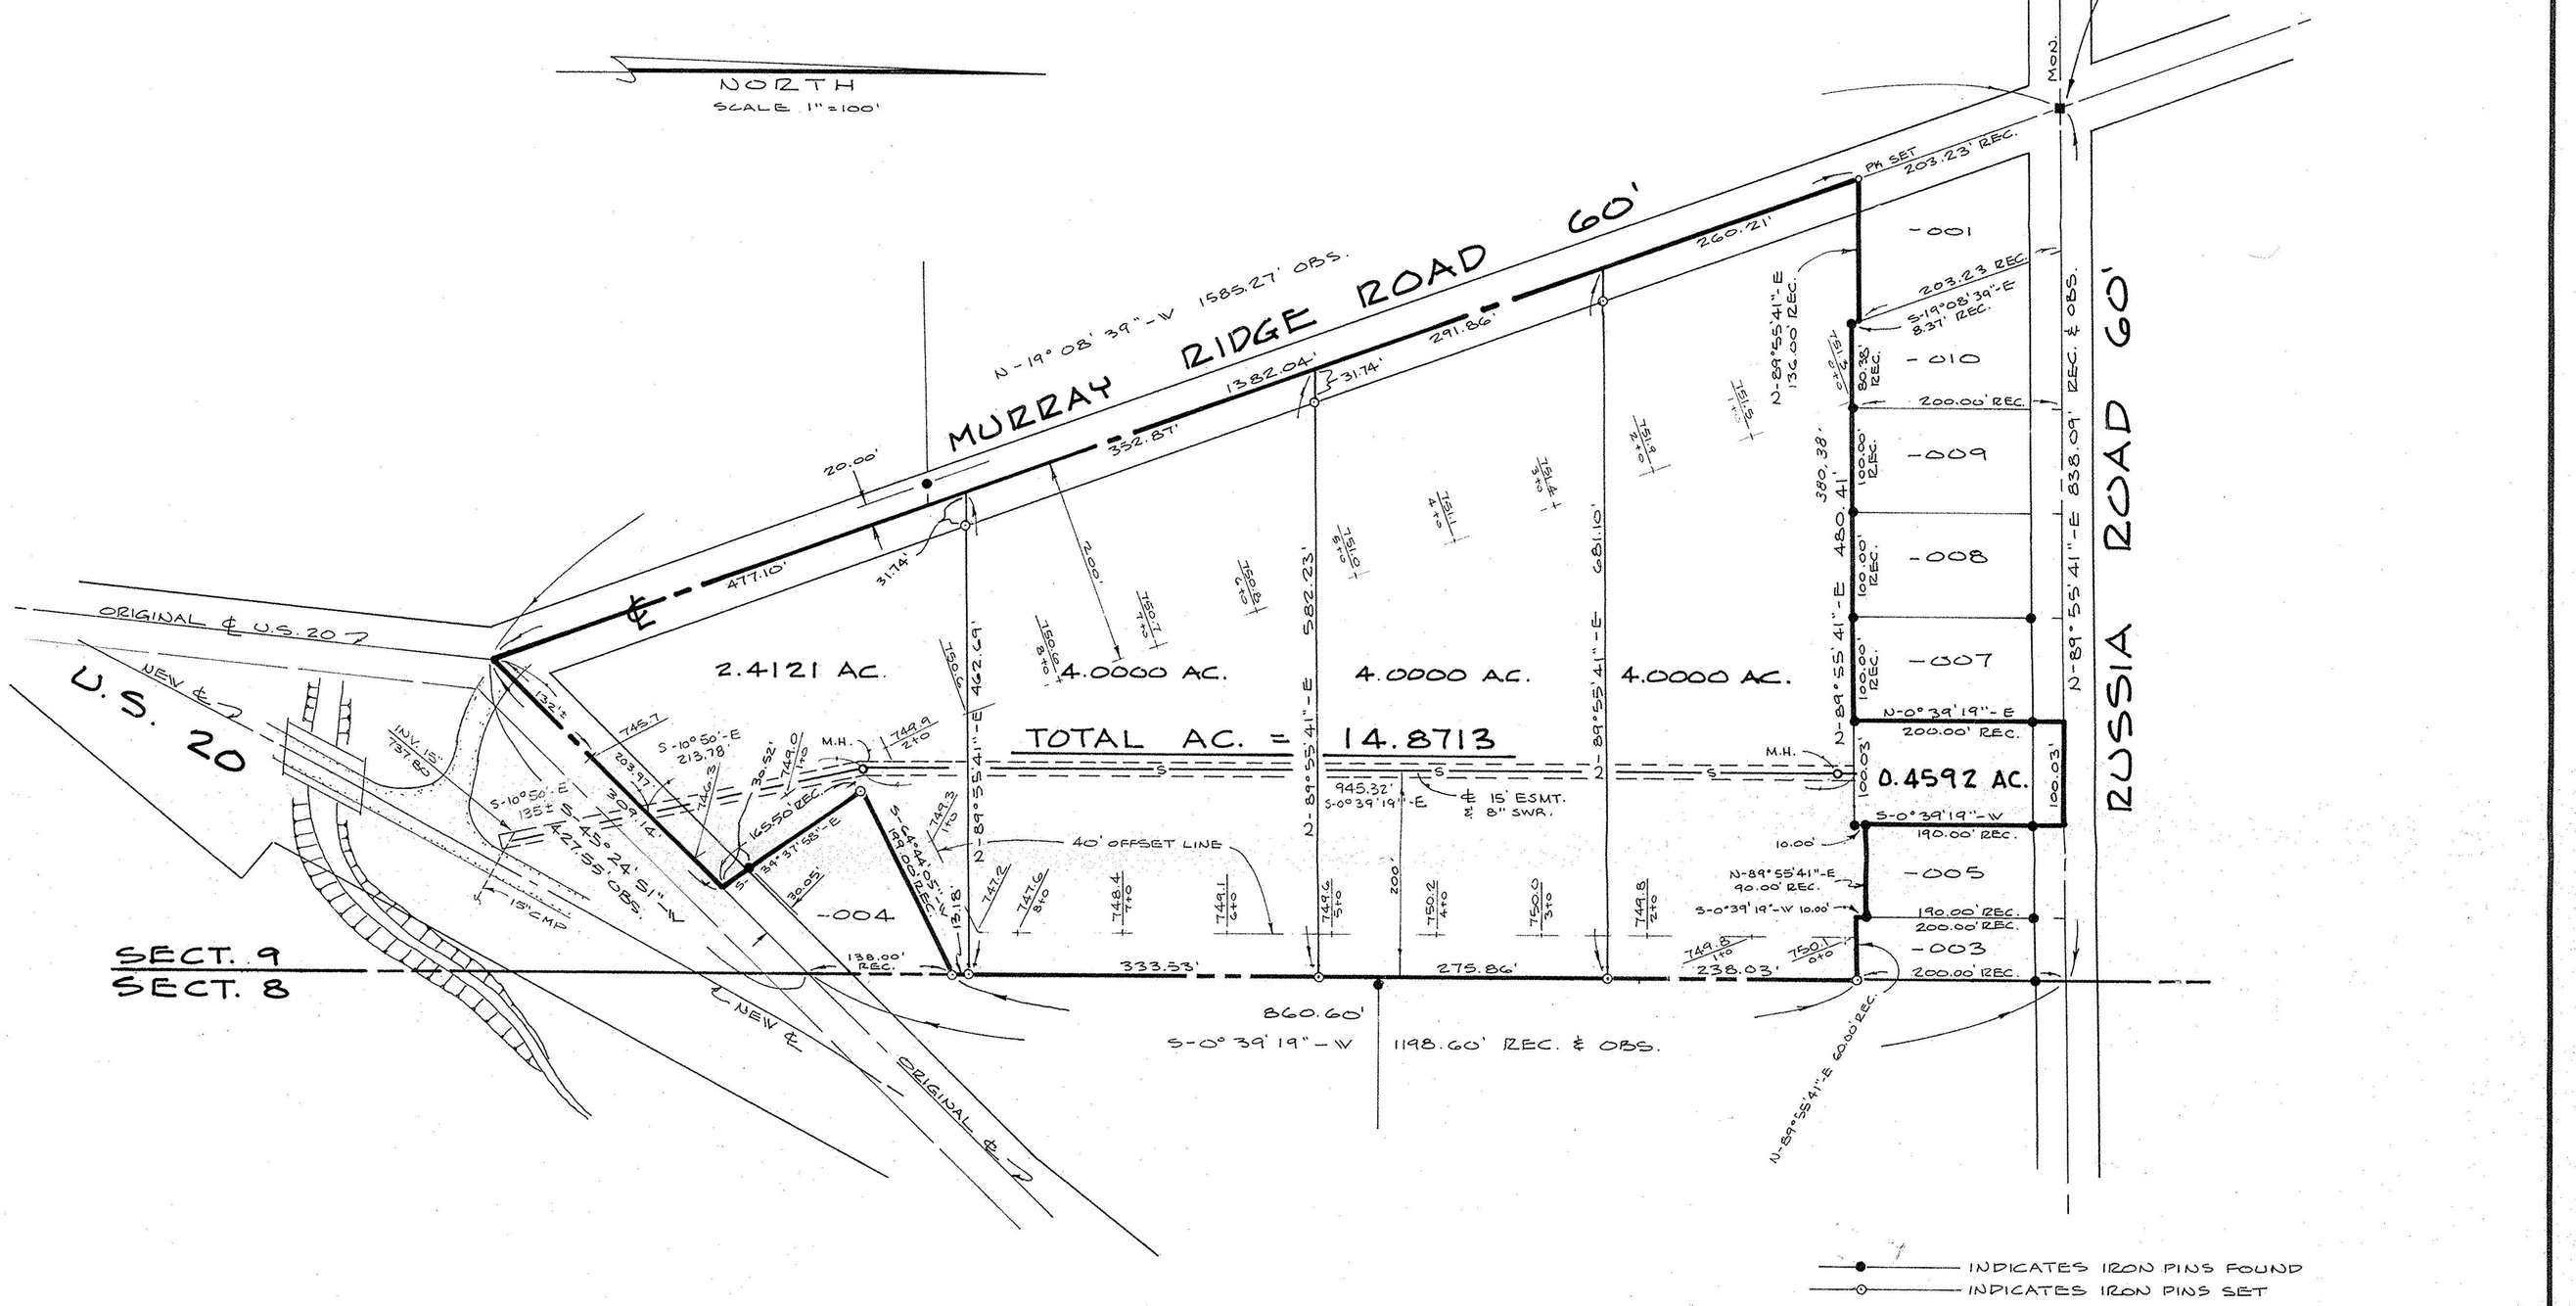

INDICATES IRON PINS FOUND
INDICATES IRON PINS SET

#00177-D

APPROVED
LORAIN CO.
MAP DEPT.
DATE 9/21/99
BY T. Dyke
00177-D

David L. Elwell
REG. SURVEYOR
JAN. 13, 1989

STATE OF OHIO
DAVID L. ELWELL
6333
REGISTERED SURVEYOR

REVISIONS	
3-6-89	TILE & ESMT. LOCATION DE.

BOUNDARY SURVEY & ELEVATIONS

PART OF
CARLISLE TOWNSHIP SECTION 9
COUNTY OF LORAIN - STATE OF OHIO

KS ASSOCIATES, INC.
ENGINEERS/SURVEYORS
424 Middle Avenue
P.O. Box 89
Elyria, Ohio 44036
Elyria *(216) 322-6317* • **Lorain** *(216) 244-5757*

ENGINEERS/SURVEYORS KS ASSOCIATES INCORPORATED

SHEET 1 OF 1
JOB NO. 88-127