


10-00-009-H

10-00-009-129-032

# 12588  
10-00-009-129

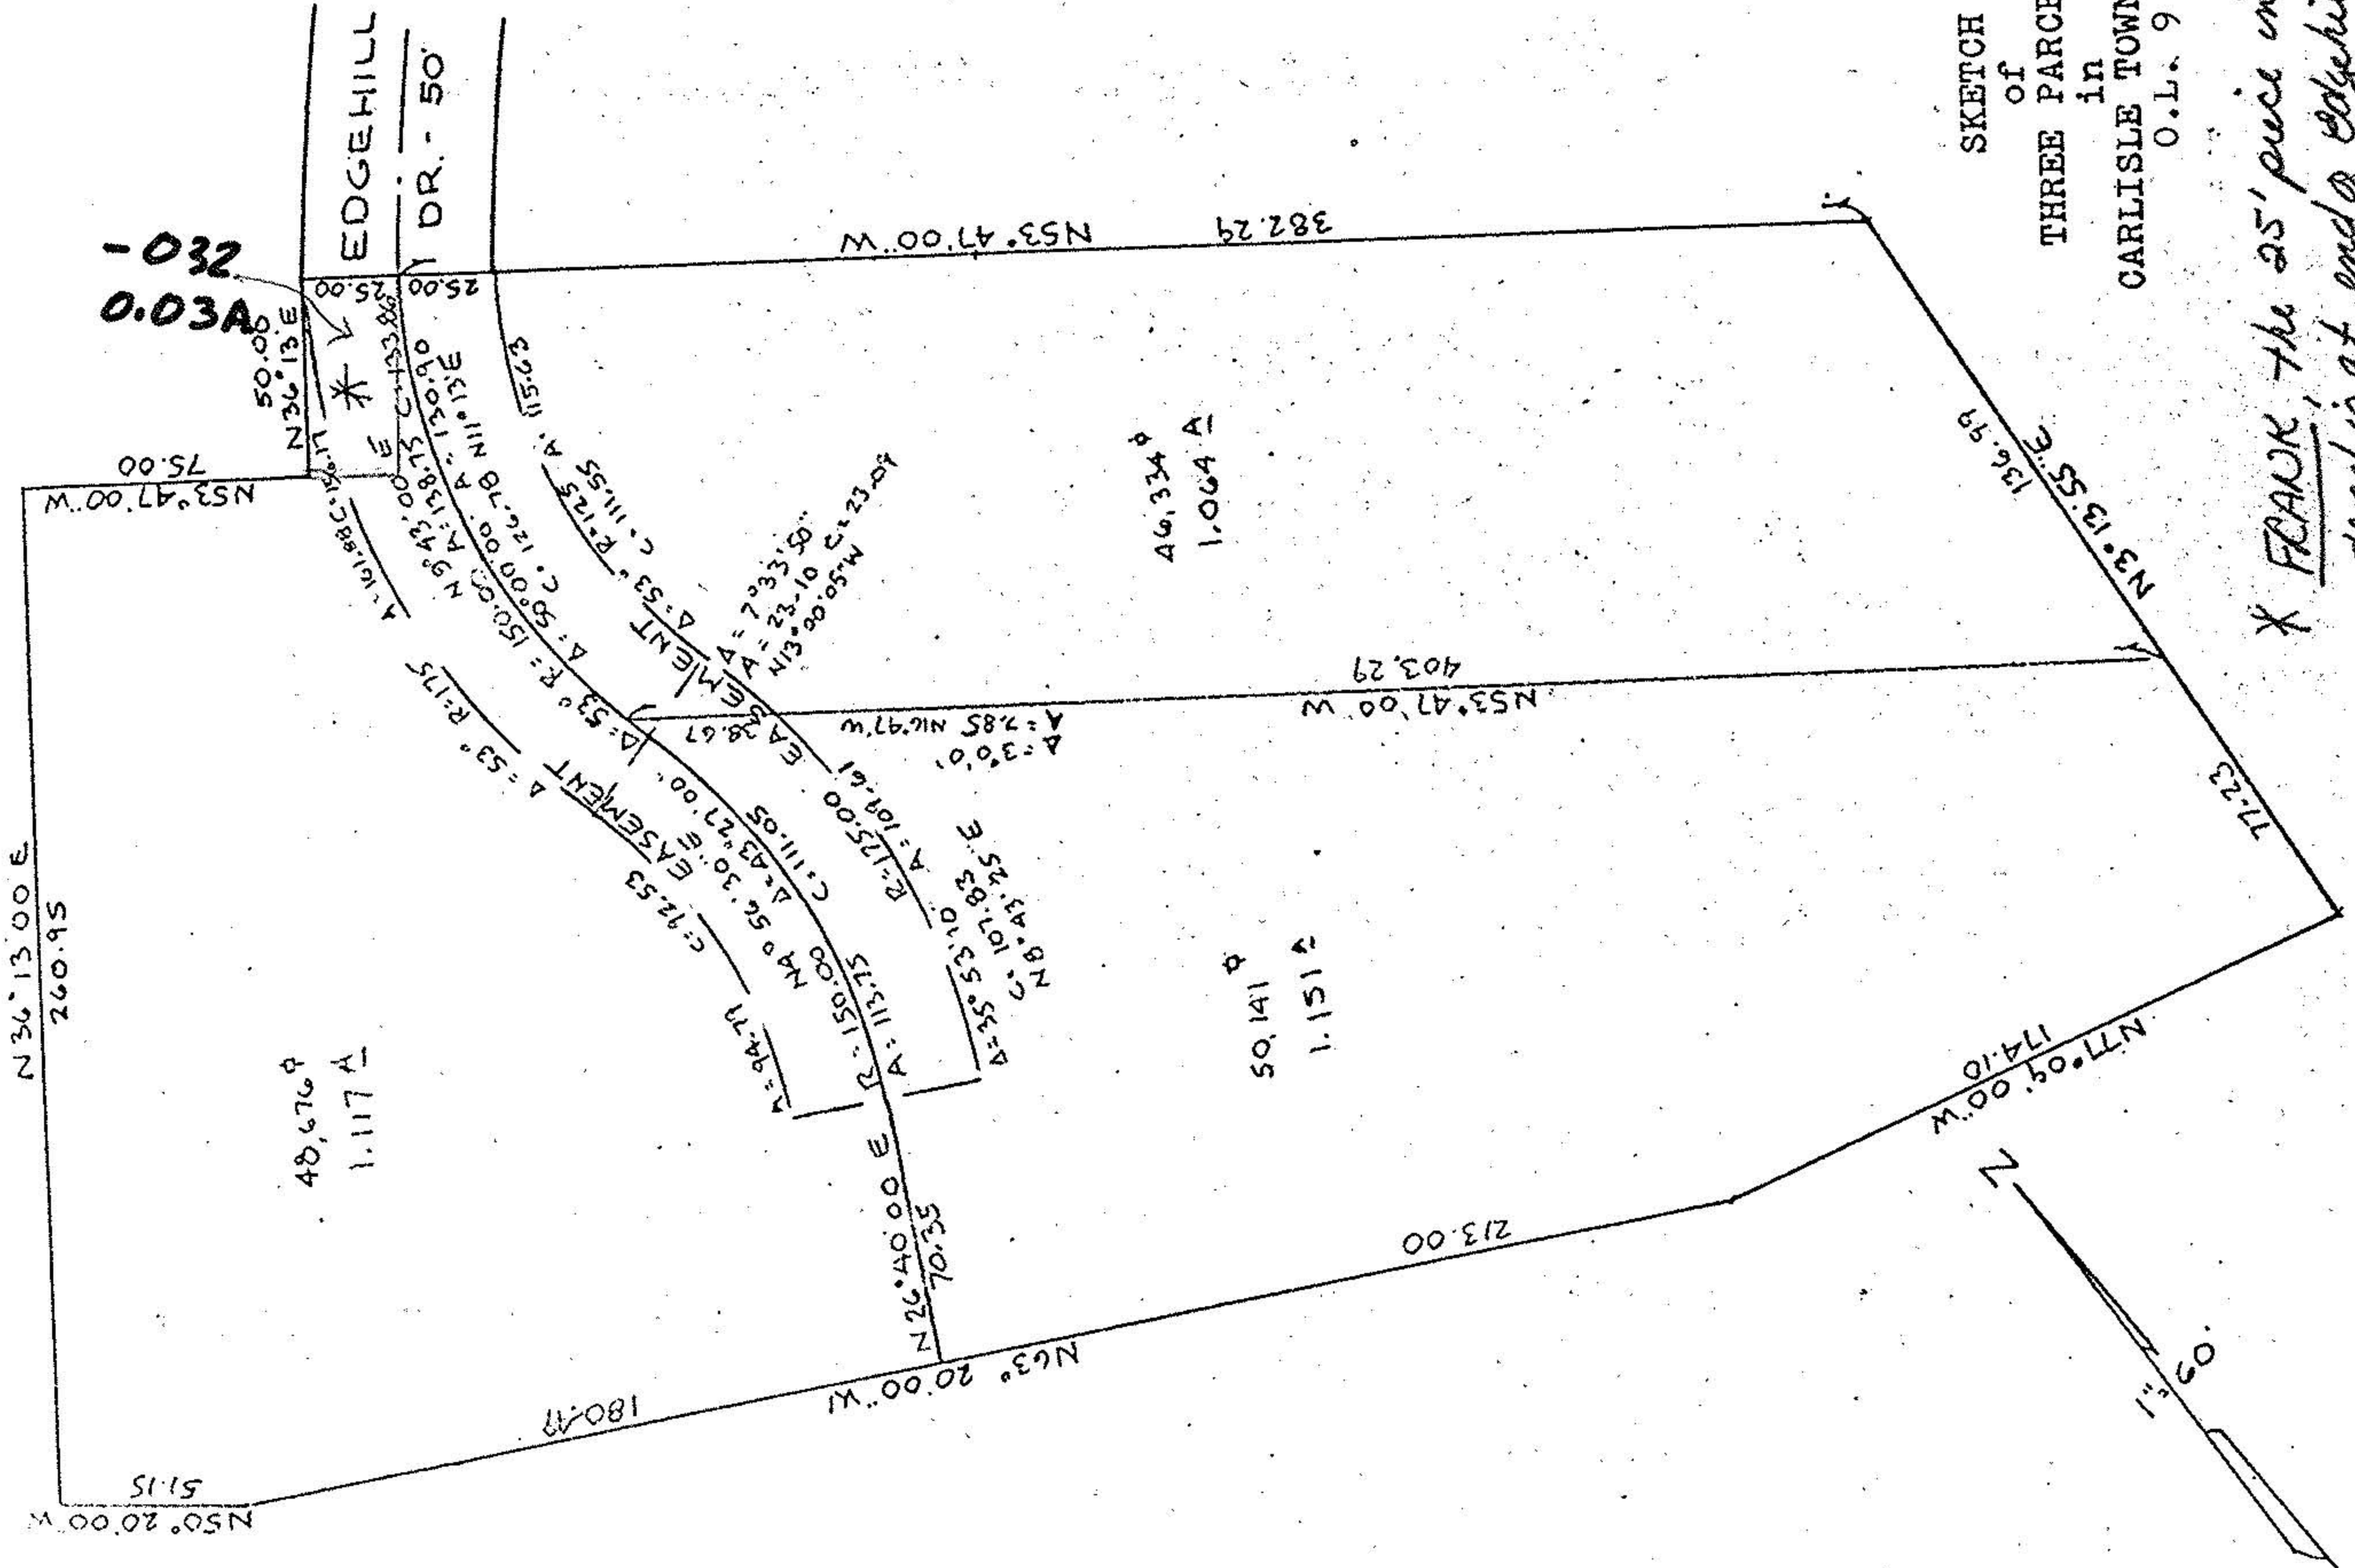

SKETCH  
of  
THREE PARCELS  
in  
CARLISLE TOWNSHIP  
O.L. 9


-032  
0.03A

48,676 P  
1.117 A

46,334 P  
1.064 A

50,141 P  
1.151 A

N  
1"=60'