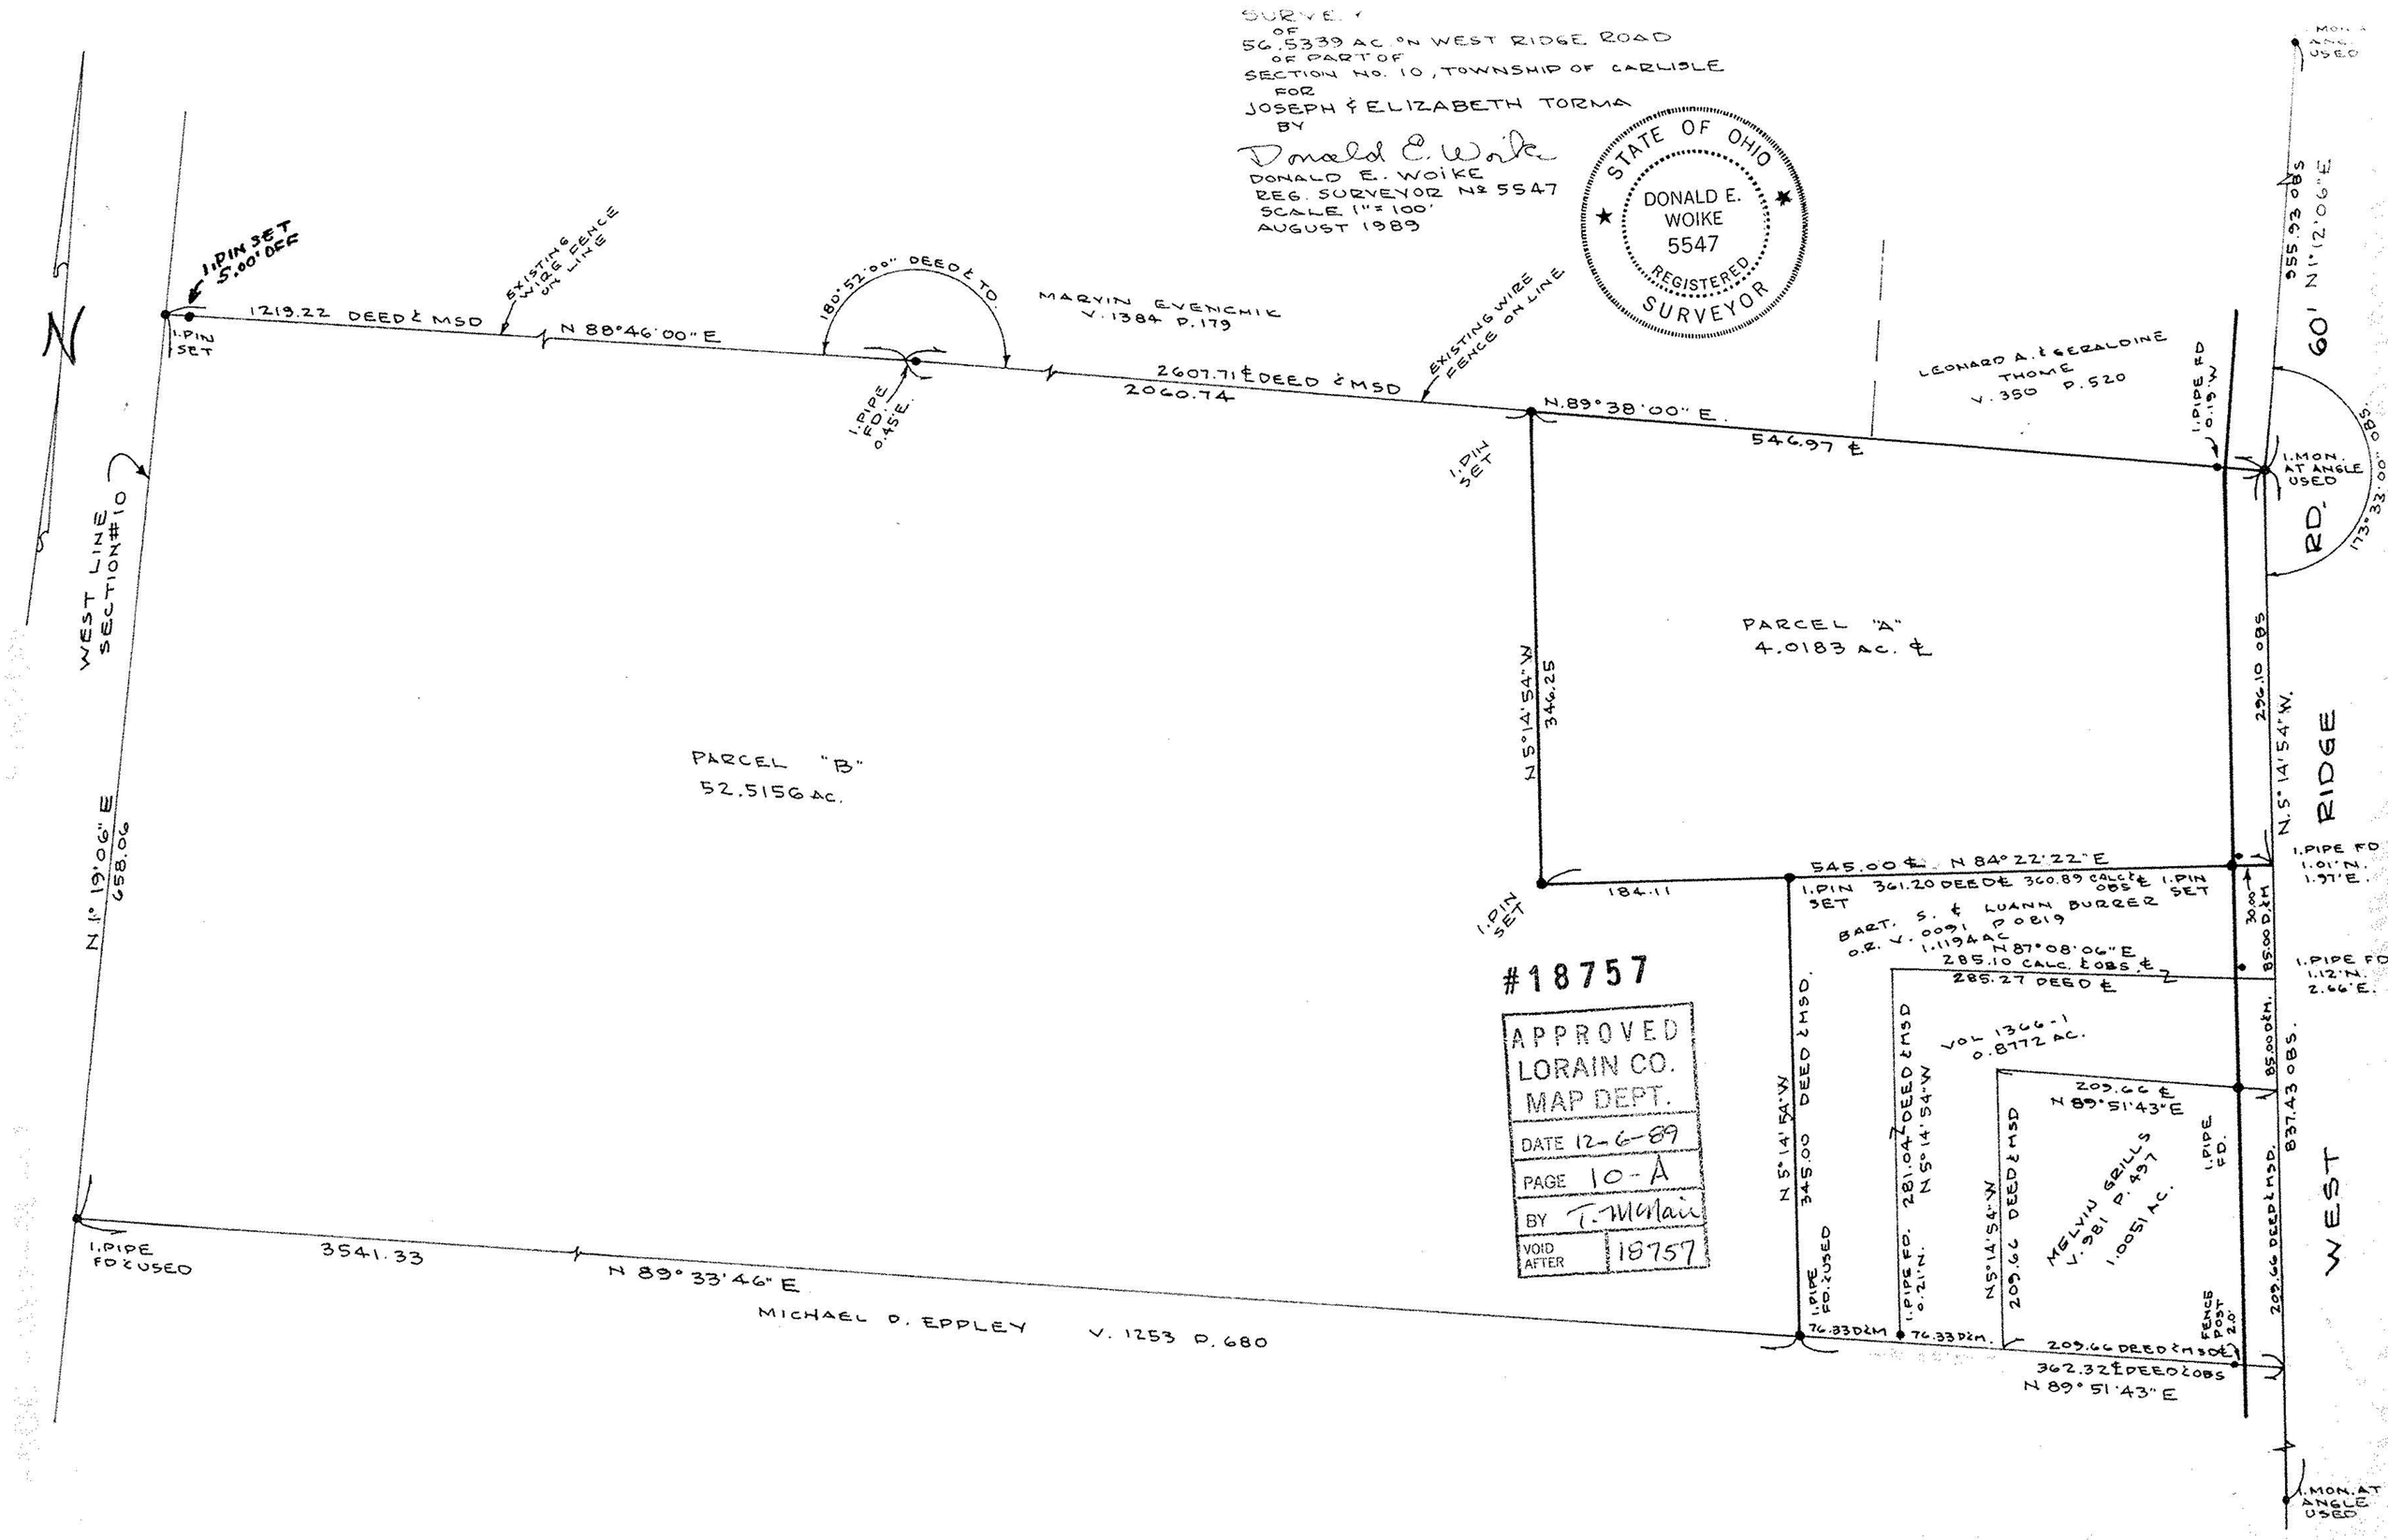
SURVEY
OF
56.5339 AC. ON WEST RIDGE ROAD
OF PART OF
SECTION NO. 10, TOWNSHIP OF CARLISLE
FOR
JOSEPH & ELIZABETH TORMA
BY
Donald E. Woike
DONALD E. WOIKE
REG. SURVEYOR No 5547
SCALE 1" = 100'
AUGUST 1989
STATE OF OHIO
DONALD E. WOIKE
5547
REGISTERED
SURVEYOR
N
1.PIN SET 5.00' OFF
1.PIN SET
1219.22 DEED & MSD
EXISTING WIRE FENCE ON LINE
N 88°46'00" E
180°52'00" DEED & TD.
1.PIPE FD. 0.45'E.
MARVIN EVENCHIK
V. 1384 P. 179
2607.71 ℄ DEED & MSD
2060.74
EXISTING WIRE FENCE ON LINE
N.89°38'00" E.
546.97 ℄
1.PIN SET
LEONARD A. & GERALDINE THOME
V. 350 P. 520
1.PIPE FD 0.19'W
1.MON. AT ANGLE USED
955.93 OBS
N 1°12'06" E
60'
RD.
173°33'00" OBS
WEST LINE SECTION #10
N 1° 19'06" E
658.06
PARCEL "B"
52.5156 AC.
PARCEL "A"
4.0183 AC. ℄
N 5°14'54" W
346.25
296.10 OBS
N. 5°14'54" W.
RIDGE
1.PIPE FD 1.01'N. 1.97'E.
545.00 ℄ N 84°22'22" E
1.PIN SET
361.20 DEED ℄ 360.89 CALC ℄ OBS ℄ 1.PIN SET
184.11
1.PIN SET
BART. S. & LUANN BURRER
O.R. V. 0091 P 0819
1.1194 AC
N 87°08'06" E
285.10 CALC. & OBS. ℄
285.27 DEED ℄
30.00
85.00 D&M
1.PIPE FD 1.12'N. 2.66'E.
#18757
APPROVED
LORAIN CO.
MAP DEPT.
DATE 12-6-89
PAGE 10-A
BY T. McNair
VOID AFTER 18757
N 5°14'54" W
345.00 DEED & MSD.
281.04 DEED & MSD
N 5°14'54" W
VOL 1366-1
0.8772 AC.
209.66 ℄
N 89°51'43" E
85.00 D&M.
837.43 OBS.
MELVIN GRILLS
V. 981 P. 497
1.0051 AC.
1.PIPE FD.
N 5°14'54" W
209.66 DEED & MSD
1.PIPE FD. & USED
1.PIPE FD. 0.21'N.
76.33 D&M
76.33 D&M.
FENCE POST 2.0'
209.66 DEED & MSD ℄
362.32 ℄ DEED & OBS
N 89°51'43" E
209.66 DEED & MSD.
WEST
1.PIPE FD & USED
3541.33
N 89°33'46" E
MICHAEL D. EPPLEY V. 1253 P. 680
1.MON. AT ANGLE USED