10-00-010-000

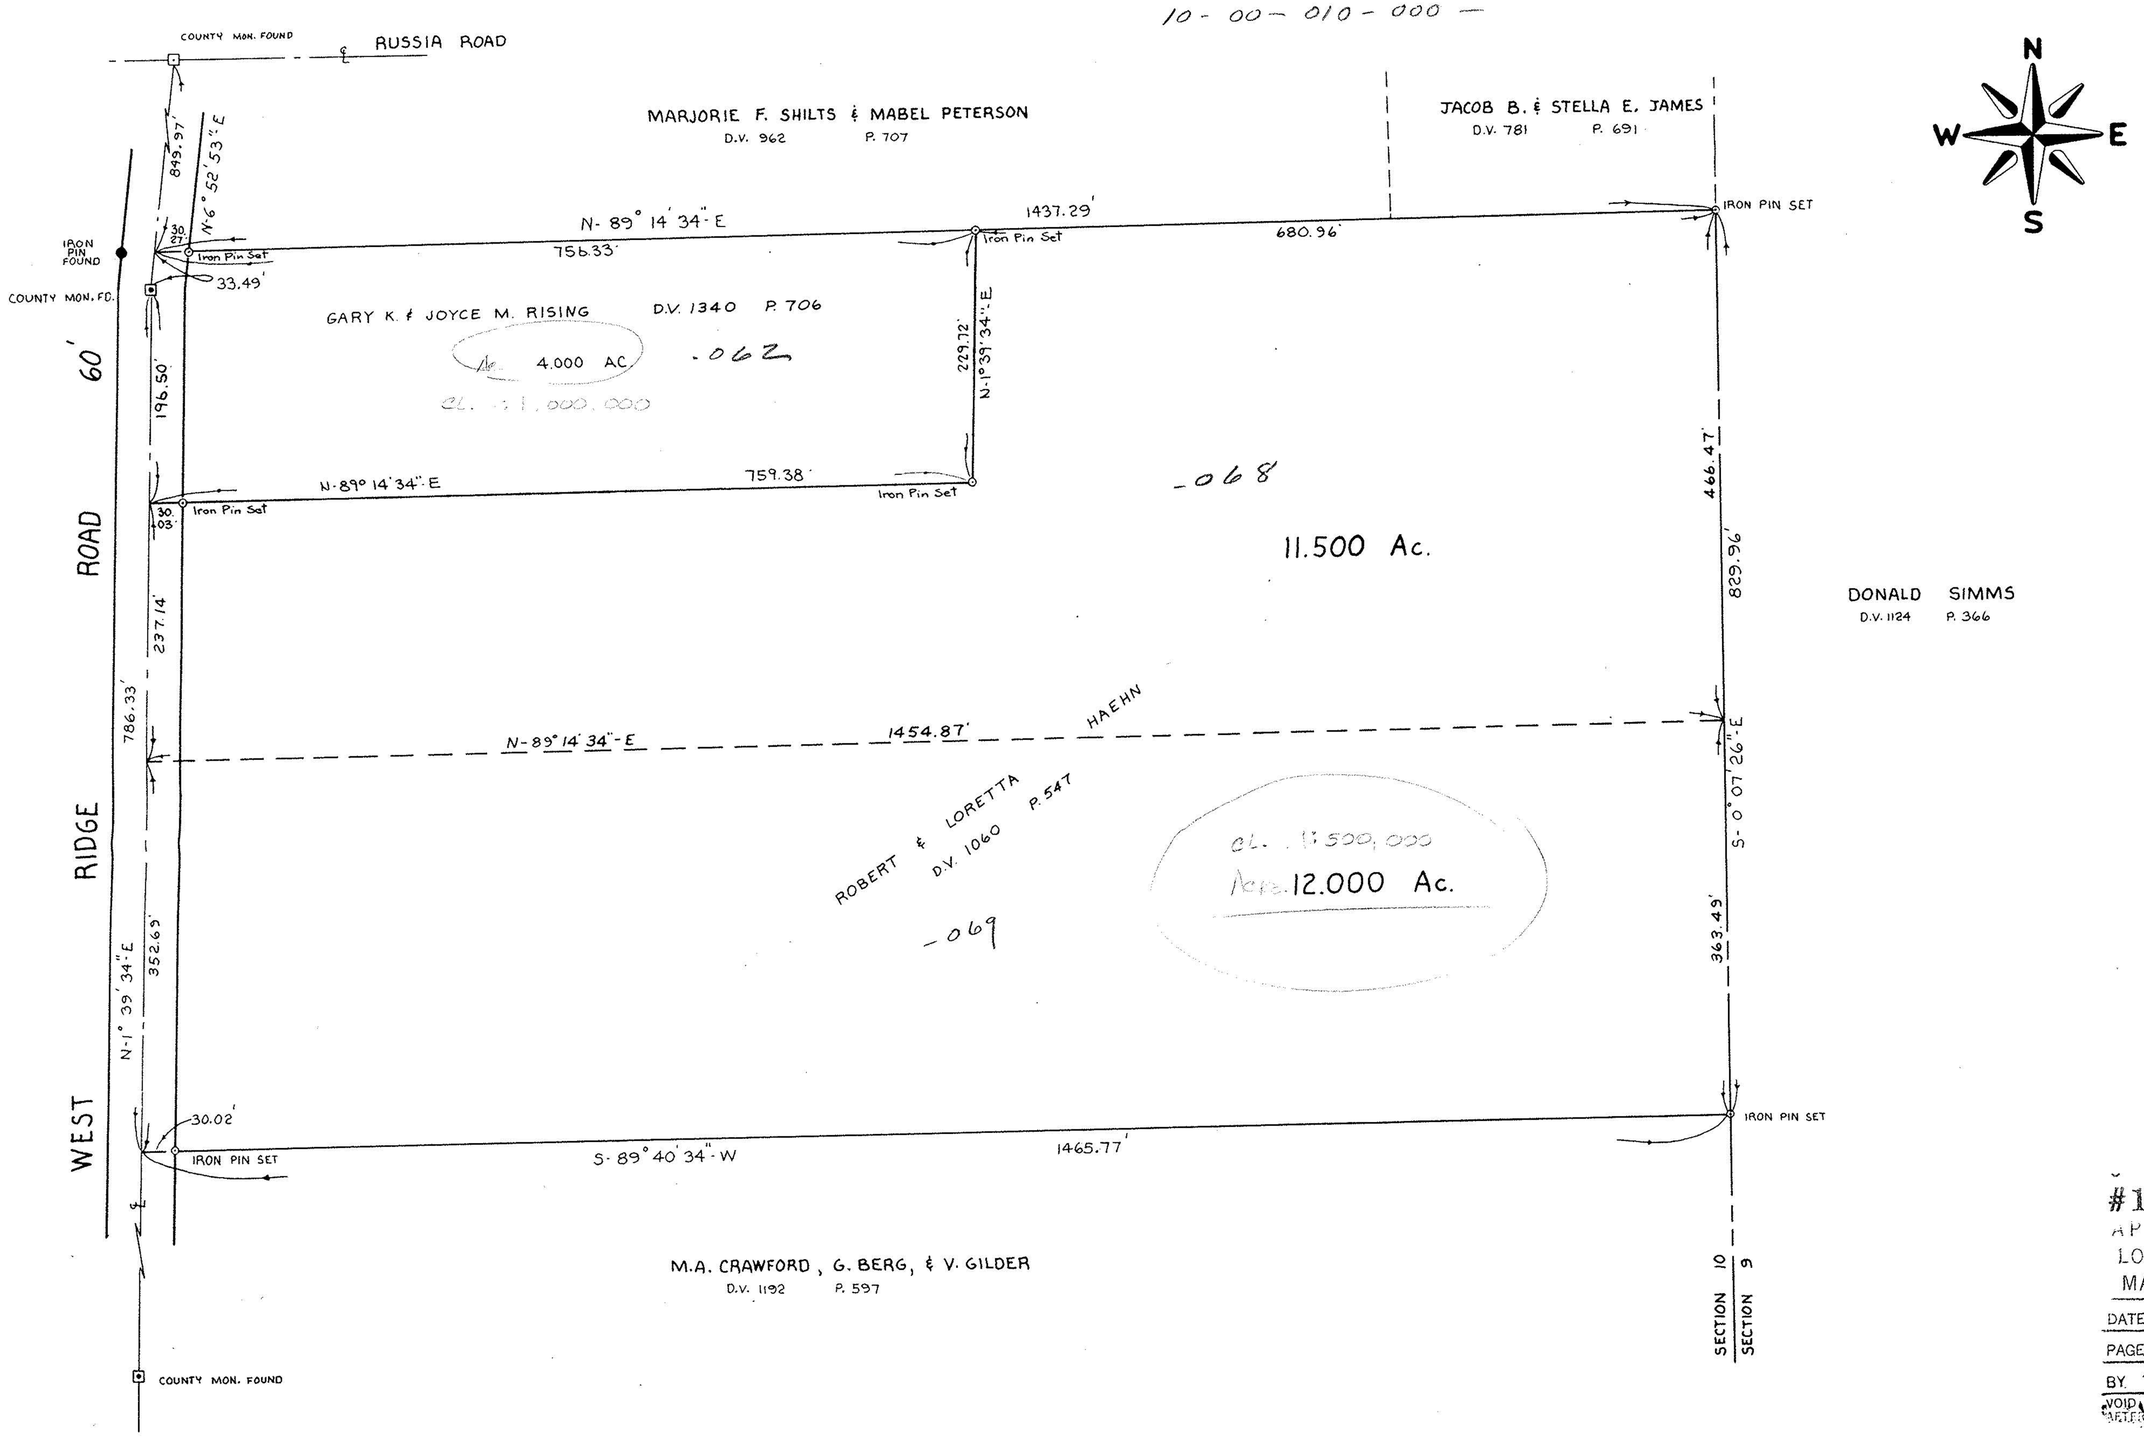

#16440
APPROVED
LORAIN CO.
MAP DEPT.
DATE 10-29-85
PAGE 10-A
BY T. McNair
VOID

PROJECT

SURVEY MAP

PART OF CARLISLE TOWNSHIP SECTION 10
TWP. OF CARLISLE, COUNTY OF LORAIN, STATE OF OHIO

Rev.
4-16-84
2-6-85

Prepared for: ROBERT HAEHN JR.
10712 WEST RIDGE ROAD
ELYRIA, OHIO

Drawn by: K.V.S
Checked by:
App. by:
Scale: 1" = 100'
Date: JUNE 28, 1979

KLEINOEDER · SCHMIDT and ASSOCIATES
ENGINEERS — SURVEYORS — CONSULTANTS in LAND PLANNING
ELYRIA - NORWALK - MEDINA OHIO

REFERENCES

SHEET NO. 1 of 1

JOB NO. 79-06