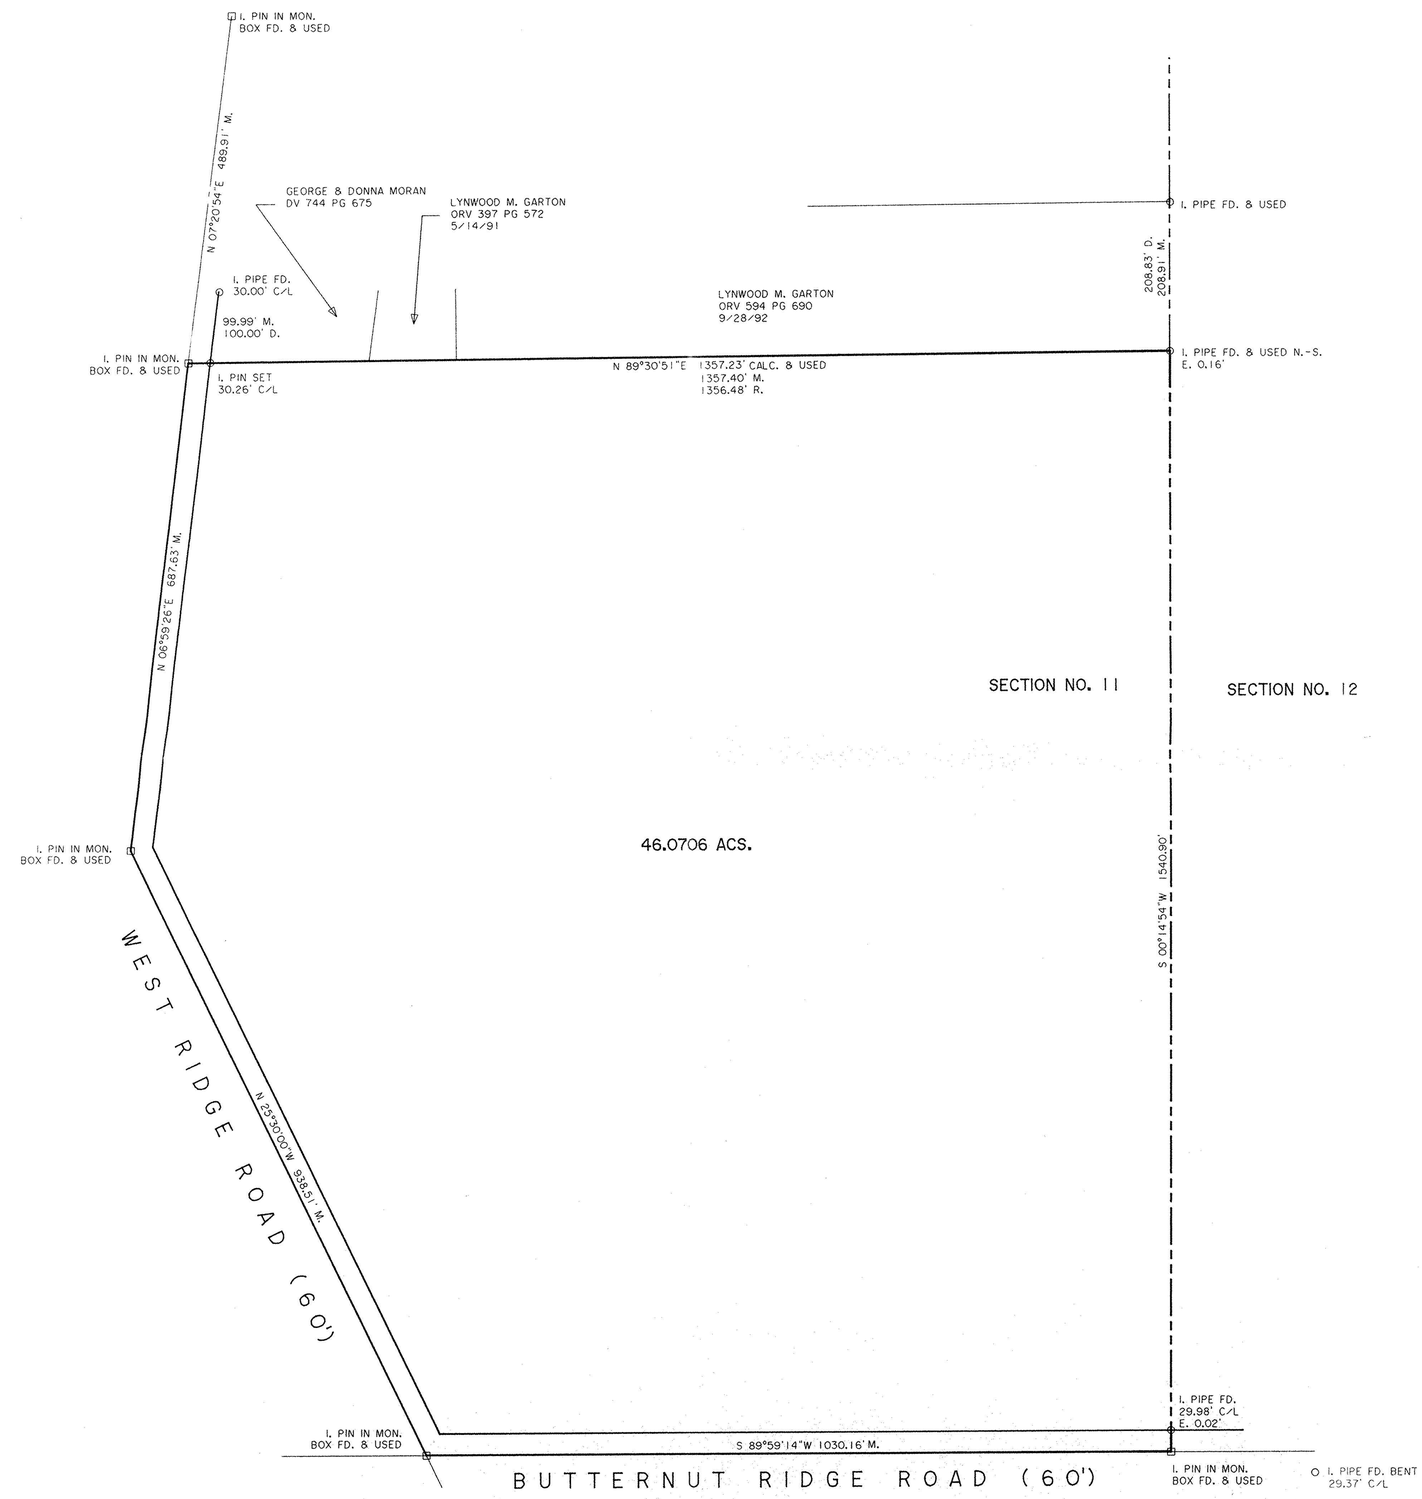

100 0 100 200 300
GRAPHIC SCALE - FEET

-N-

DIMENSIONS SHOWN ON THIS PLAT ARE EXPRESSED IN FEET AND DECIMAL PARTS THEREOF, ALL BEARINGS ARE TO AN ASSUMED MERIDIAN AND ARE USED TO INDICATE ANGLES ONLY. PERMANENT MONUMENTS WERE FOUND OR SET AT ALL POINTS INDICATED HEREON, ALL OF WHICH I CERTIFY TO BE CORRECT.

STATE OF OHIO
THOMAS A. SIMON
S-7775
REGISTERED
PROFESSIONAL SURVEYOR

THOMAS A. SIMON
REG. PROFESSIONAL SURVEYOR
NO. S-7775

BASIS OF BEARINGS IS THE CENTERLINE OF WEST RIDGE ROAD NORTH 25°30'00" WEST. IRON PINS SET ARE 5/8" DIAMETER 30" LONG WITH PLASTIC CAPS "T. SIMON, S-7775".

№ 00650-A
APPROVED
LORAIN CO.
MAP DEPT.
DATE 1-30-02
PAGE 10-A
BY R. MAINES
MAP NO. 02-000650-A

PLAT OF SURVEY

FOR

LAURA KLINECT TRUST
ROGER A. KLINECT, SUCCESSOR TRUSTEE

BEING KNOWN AS PART OF ORIGINAL CARLISLE TOWNSHIP
SECTION NO. 11

COUNTY OF LORAIN STATE OF OHIO
OCTOBER, 2001 SCALE: 1" = 100'

THOMAS SIMON & ASSOCIATES, INC.
PROFESSIONAL LAND SURVEYORS

COBBLESTONE CORNER PROFESSIONAL CENTER
39049 CENTER RIDGE ROAD
NORTH RIDGEVILLE, OHIO 44039
(440) 327-2925
FAX 327-2964

JOB NO. 2001-072