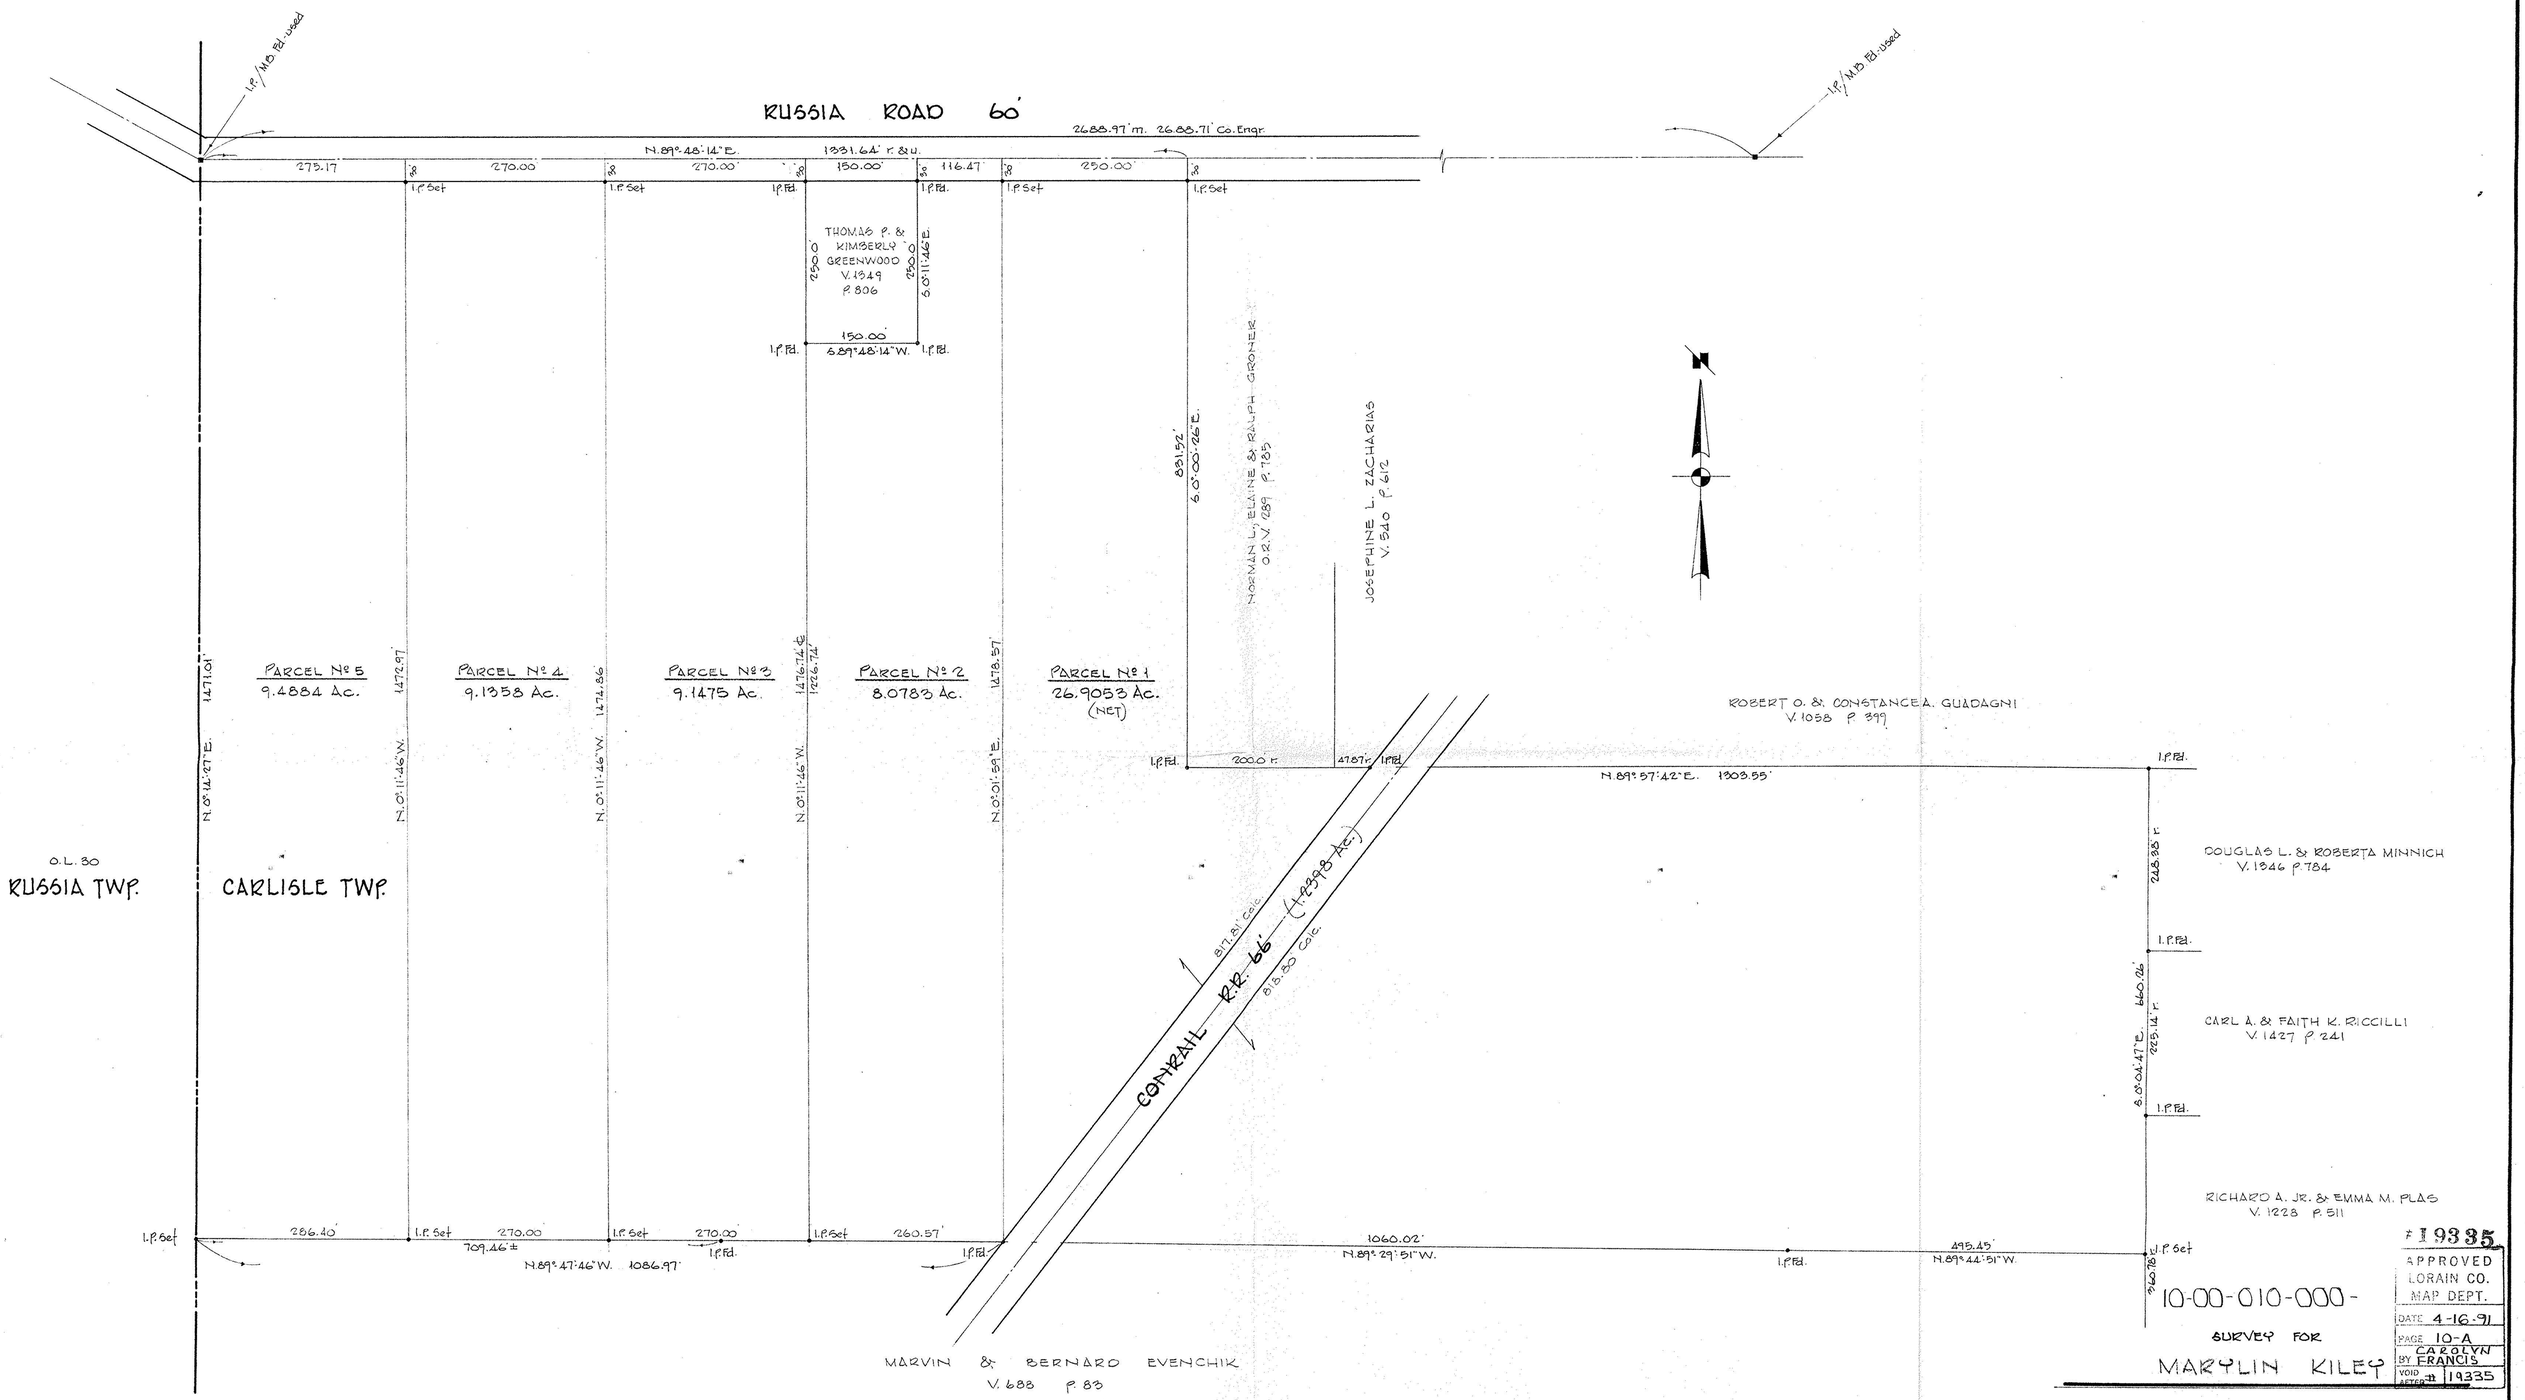

10-00-010-000-

SURVEY FOR

MARYLIN KILEY

#	19335
APPROVED	LORAIN CO. MAP DEPT.
DATE	4-16-91
PAGE	10-A
BY	CAROLYN FRANCIS
VOID AFTER #	19335

PART of ORIG. SEC. 10 — CARLISLE TOWNSHIP

LORAIN COUNTY — OHIO

SCALE 1" = 100' — JUNE, 1990

LAUNDON • SIMON • CAHL & ASSOC. INC.

ENGINEERS — SURVEYORS

0 50 100 200 300 400 500

JOB 90-1943

252