LAUNDON • SIMON • CAHL & ASSOC., INC.
CONSULTING ENGINEERS & SURVEYORS
110 MIDDLE AVE., ELYRIA, O. 44035

SURVEY FOR THE ESTATE OF MELVIN HURST
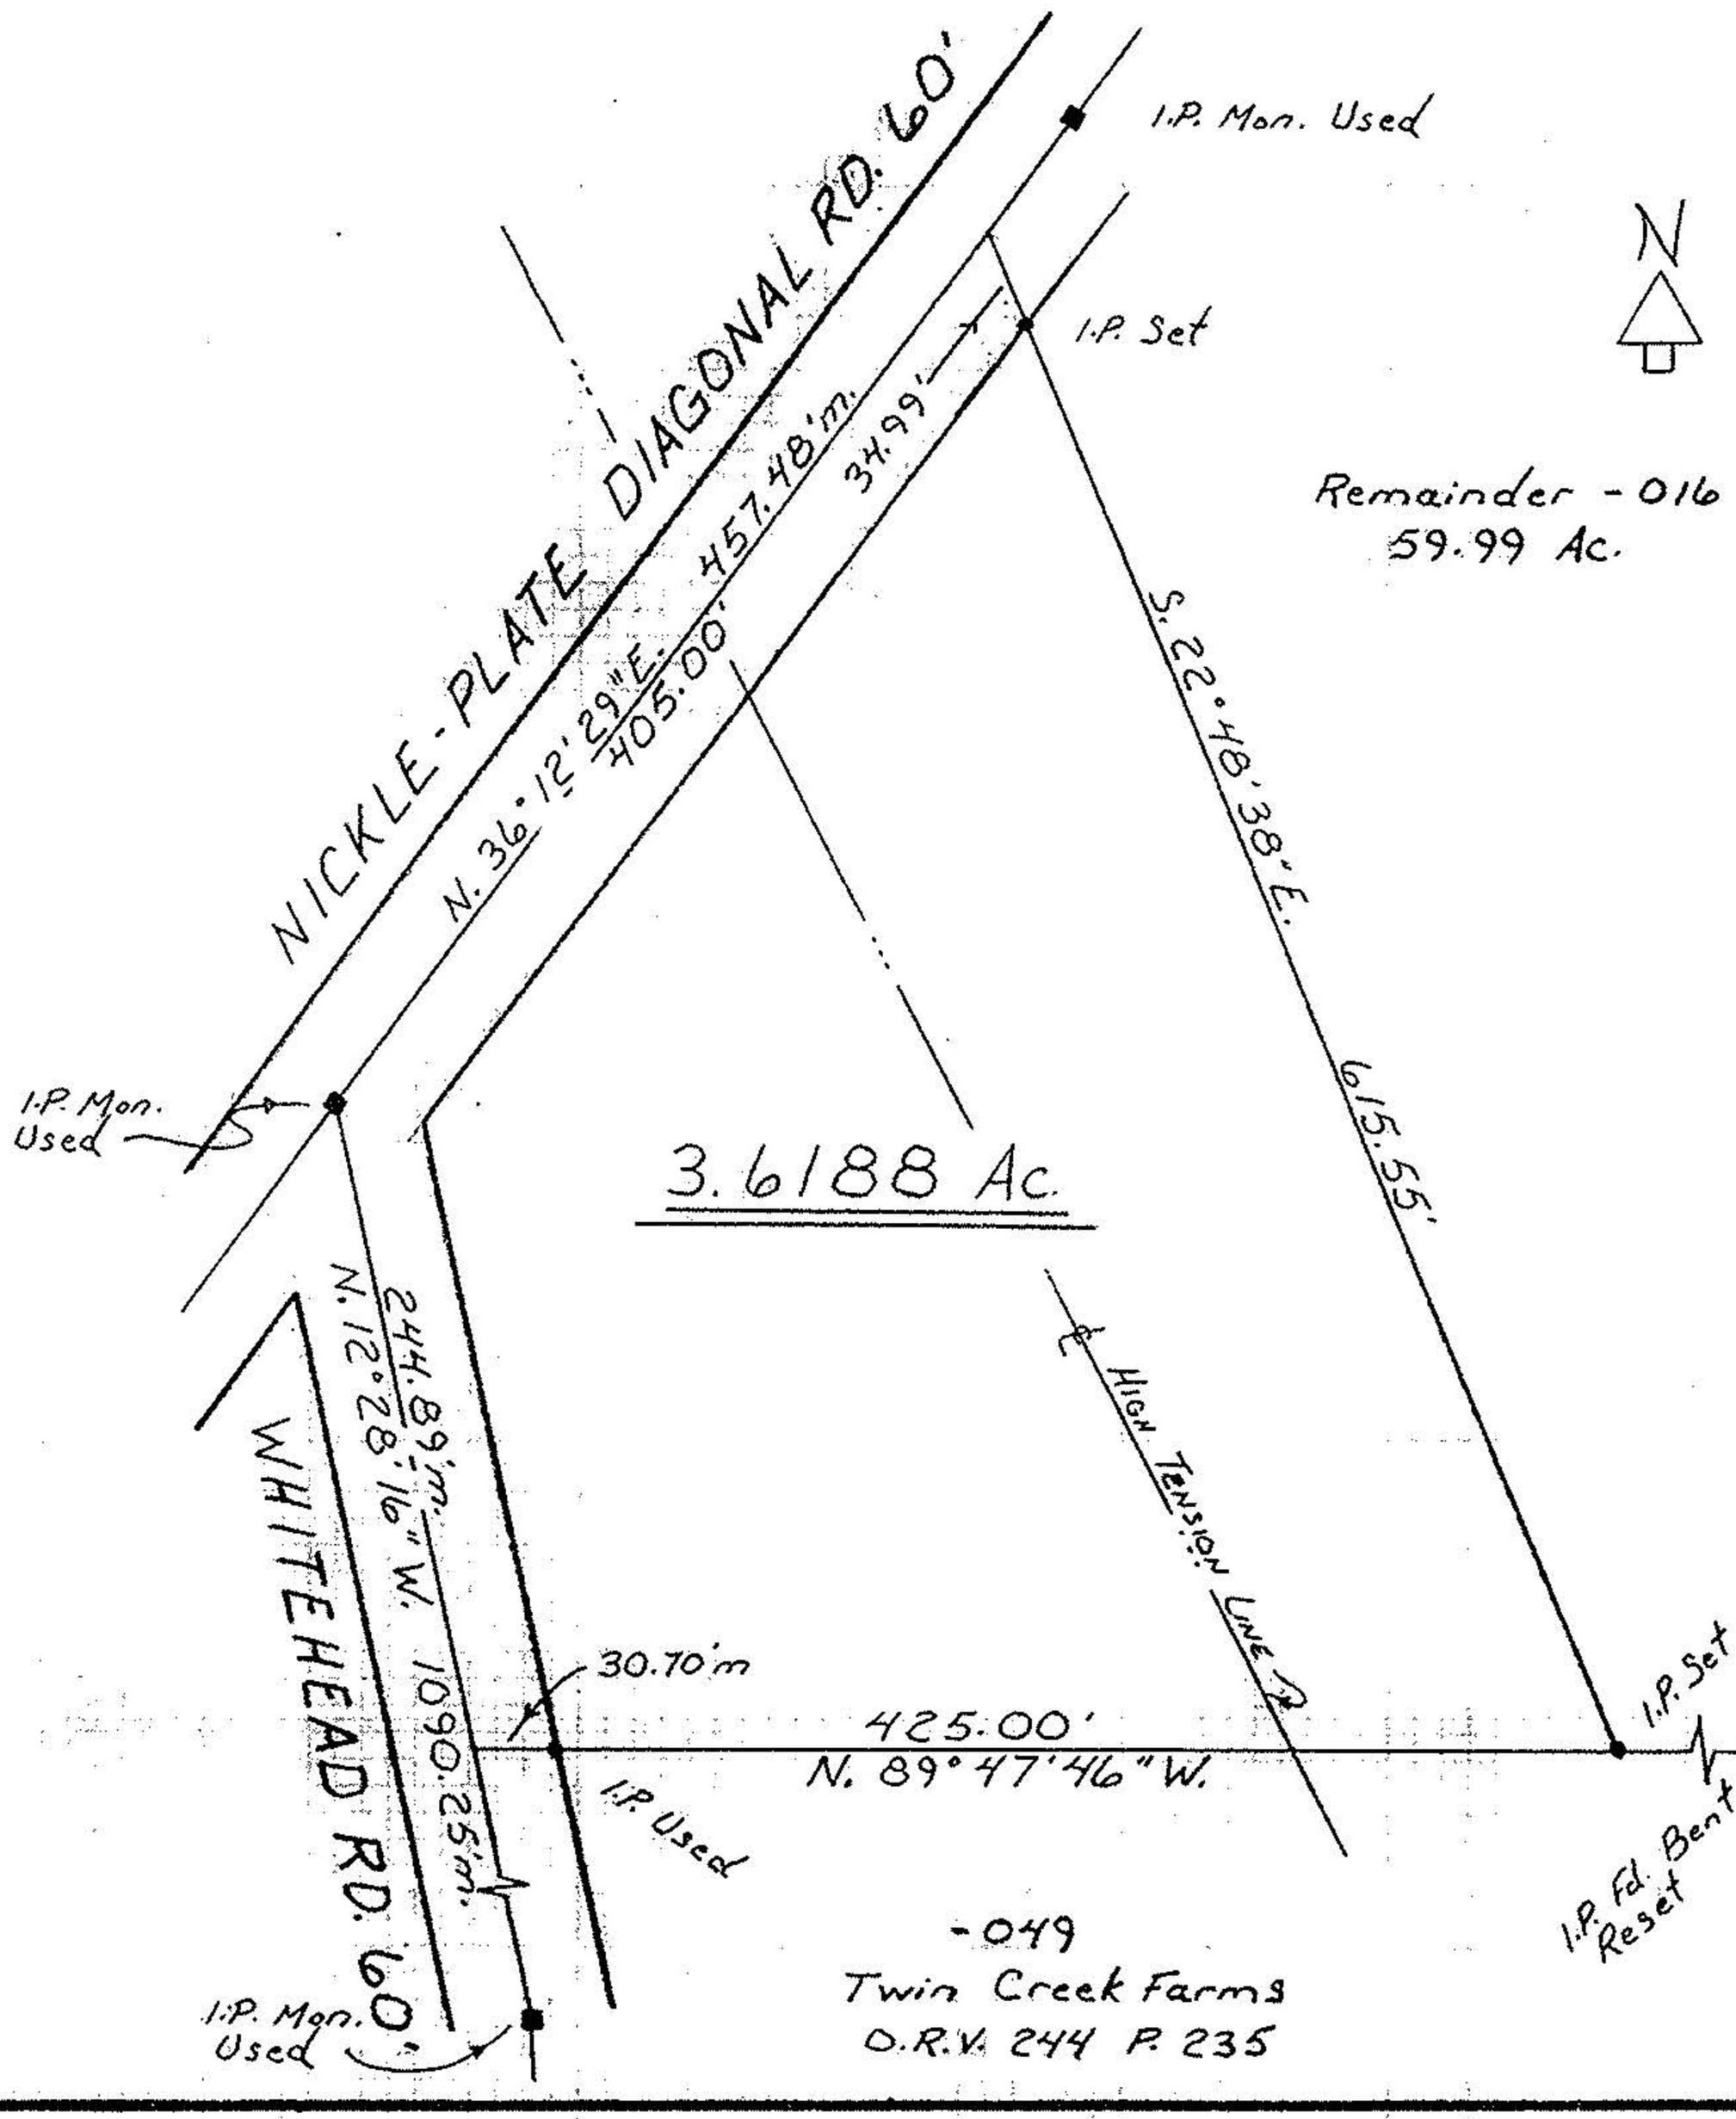
Orig. Lot 19	City of	Date April 1996 Scale 1"=100'
Orig. Sec	Village of	Dwn. by RC Chkd. by RS
Tract	County of Lorain	Job No. 96-2843 F.B. 238 P. 65
Township of Carlisle	State of Ohio	Printed