MAP OF SURVEY & LOT SPLIT

FOR

SHAMROCK DEVELOPMENT CO., GEN. PARTNERS

NORTH

1" = 50'

SITUATED IN THE TOWNSHIP OF EATON, COUNTY OF LORAIN, STATE OF OHIO AND BEING KNOWN AS PART OF ORIGINAL EATON TWP. LOT 98.

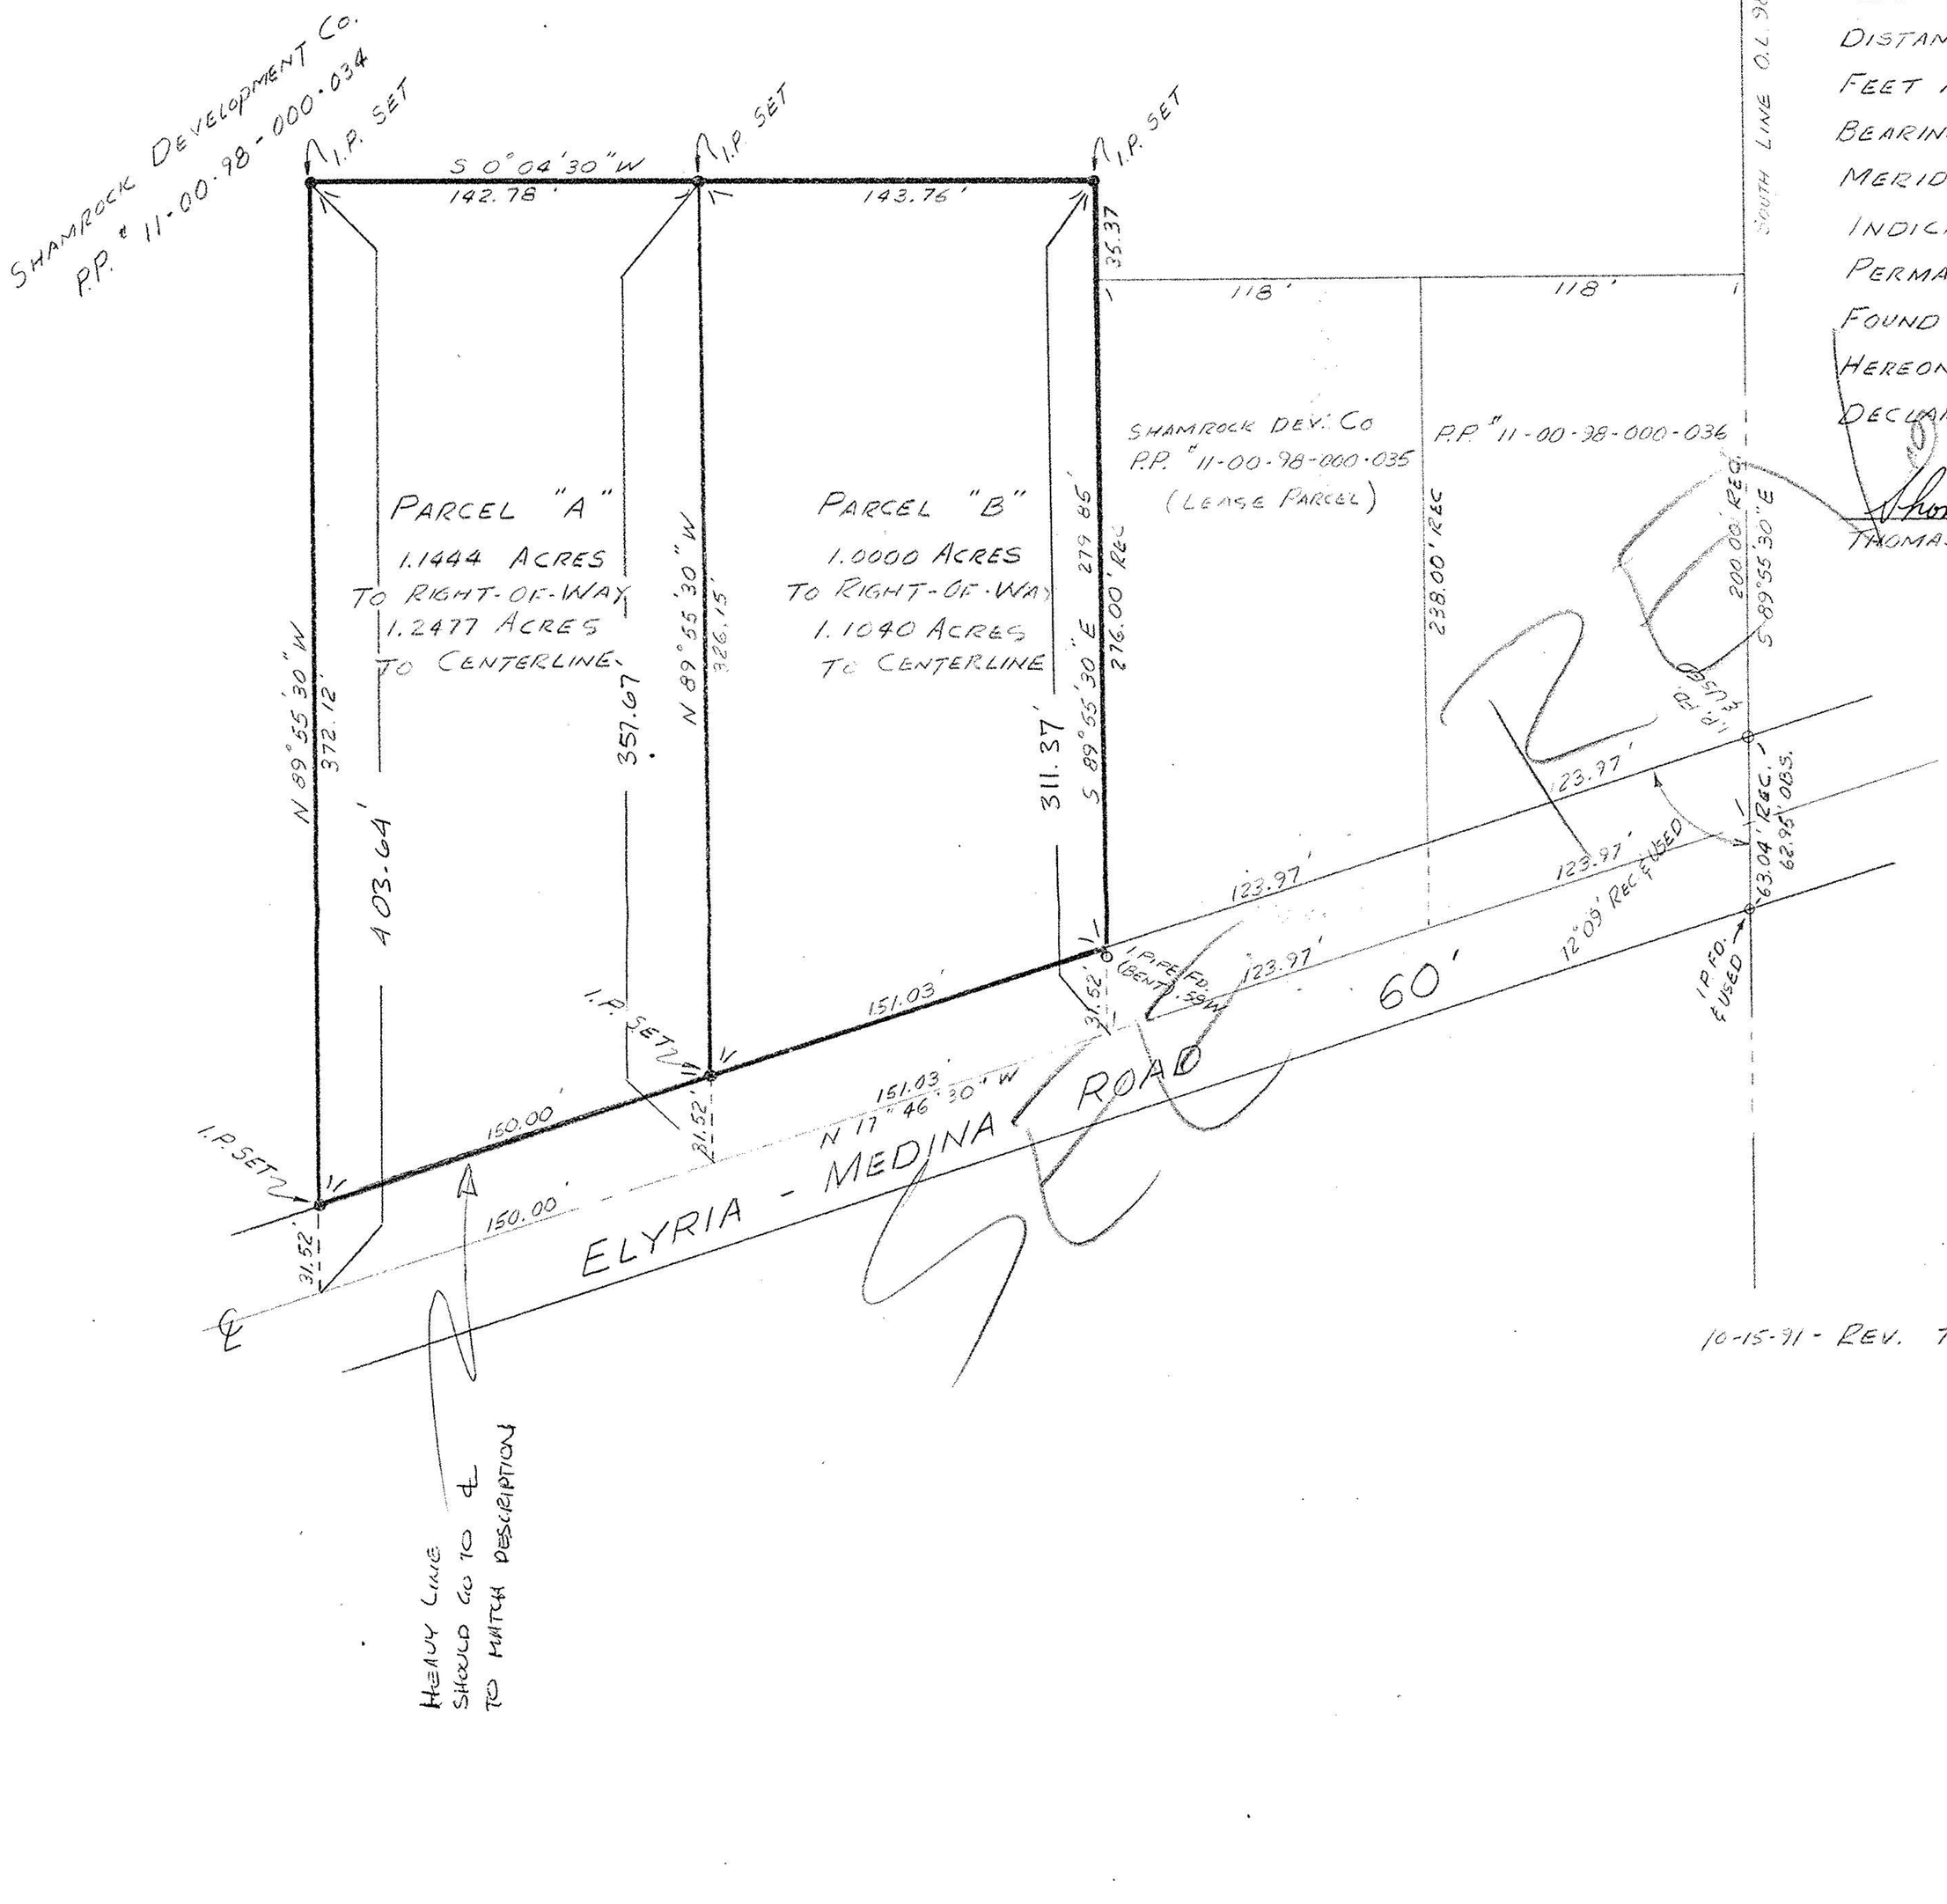

SURVEYOR'S STATEMENT

DISTANCES ARE EXPRESSED IN FEET AND DECIMAL PARTS THEREOF. BEARINGS ARE TO AN ASSUMED MERIDIAN AND ARE USED TO INDICATE ANGLES ONLY. PERMANENT MONUMENTS WERE FOUND OR SET AS INDICATED HEREON. ALL OF WHICH I DECLARE TO BE CORRECT.

Thomas M. Snezek 10-2-91

THOMAS M. SNEZEK - P.S. # 7051

10-15-91 - REV. TO ADD ACREGE TO CENTERLINE

11-00-098.-000

19625

APPROVED
LORAIN CO.
MAP DEPT.

DATE 10-24-91

PAGE 11-00098A 11-E SPT.

BY CAROLYN FRANCIS

VOID AFTER # 19625