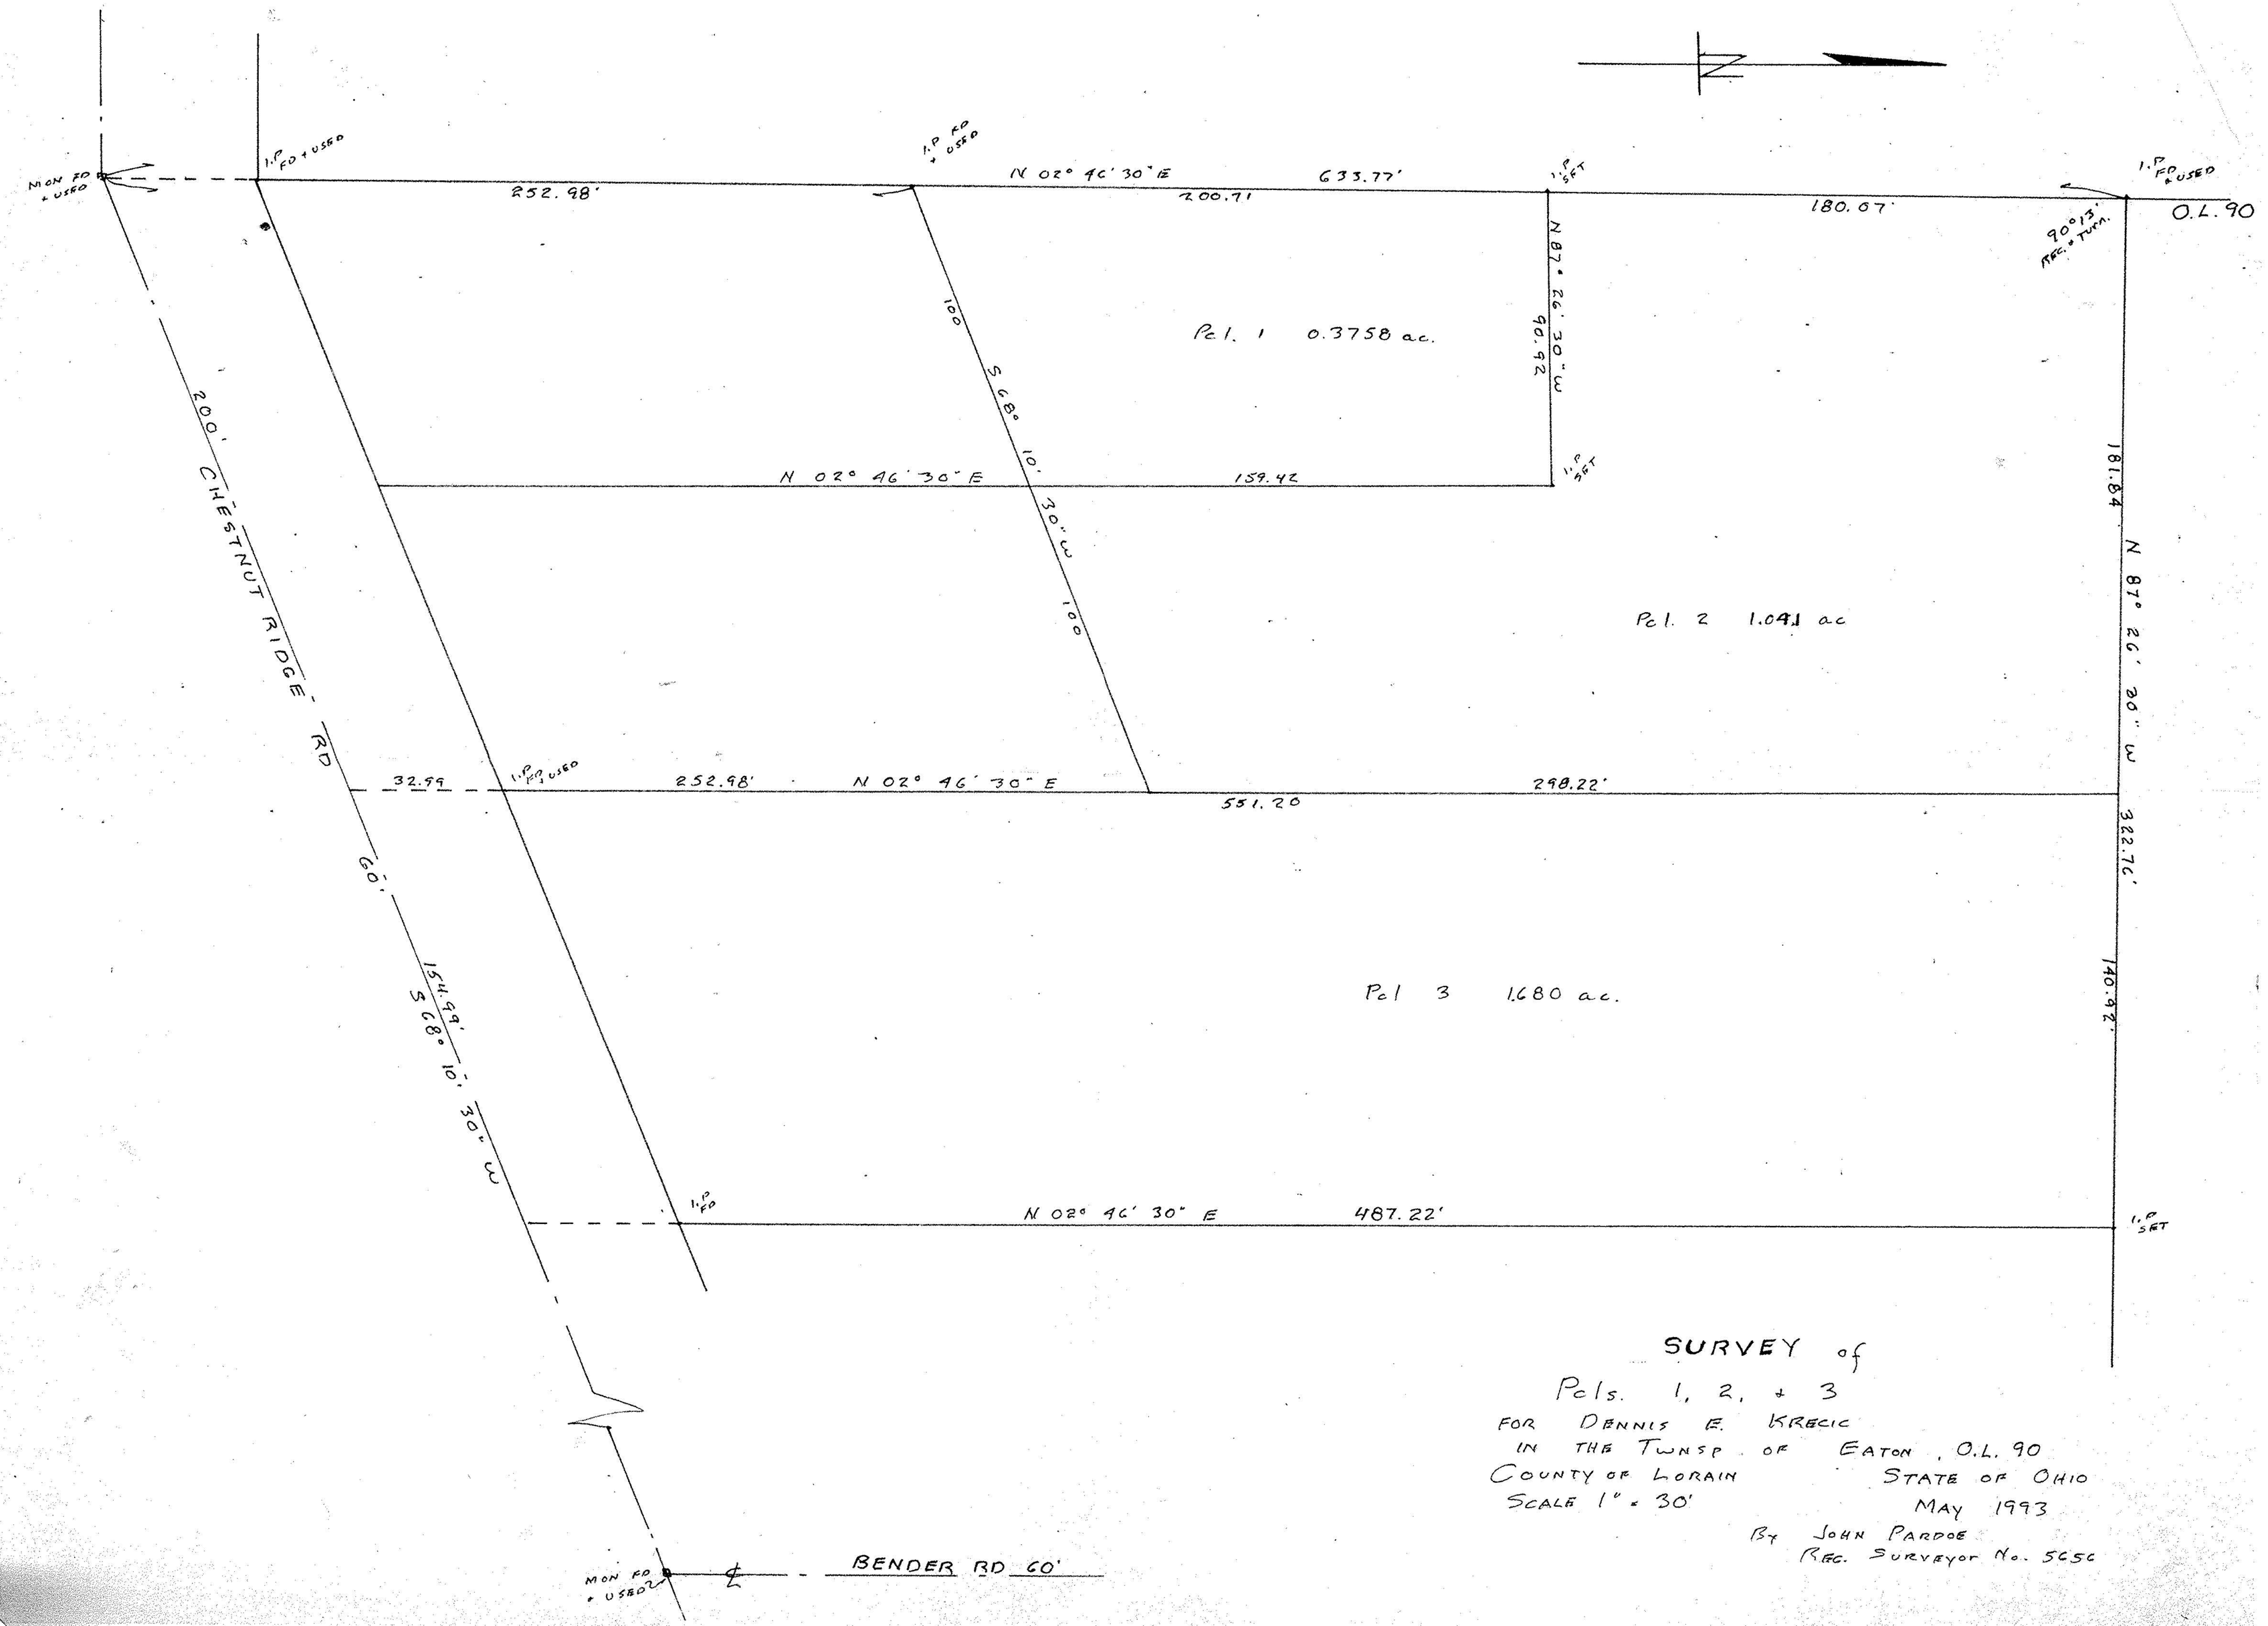

SURVEY of

Pcls. 1, 2, + 3

FOR DENNIS E. KRECIC

IN THE TWNSP OF EATON, O.L. 90

COUNTY OF LORAIN STATE OF OHIO

SCALE 1" = 30' MAY 1993

BY JOHN PARDOE

REG. SURVEYOR No. 5656