SURVEY MADE FOR AND AT THE INSTANCE OF:

CATHOLIC DIOCESE OF CLEVELAND
LANDSEL TITLE AGENCY INC.

SITUATED IN THE TOWNSHIP OF EATON, COUNTY OF LORAIN AND STATE OF OHIO
BEING PART OF ORIGINAL EATON TOWNSHIP LOT NO. 98 AND VACATED EATON
TOWNSHIP ROAD (A.K.A.) FOX ROAD BY RESOLUTION NO. 93-899 OF LORAIN COUNTY RECORDS.

DIMENSIONS ON THIS PLAT ARE EXPRESSED IN FEET AND DECIMAL PARTS THEREOF, BEARINGS SHOWN HEREON ARE TO AN ASSUMED MERIDIAN AND ARE USED TO INDICATE ANGLES ONLY.
ALL OF WHICH I CERTIFY TO BE CORRECT.

FEBRUARY, 1995
SCALE 1"= 50'

Andrew E. Rudy
ANDREW E. RUDY REG. SURVEYOR NO. 5531

0 25 50 100 200

NORTH

STATE OF OHIO
ANDREW E. RUDY
S-5531
REGISTERED SURVEYOR

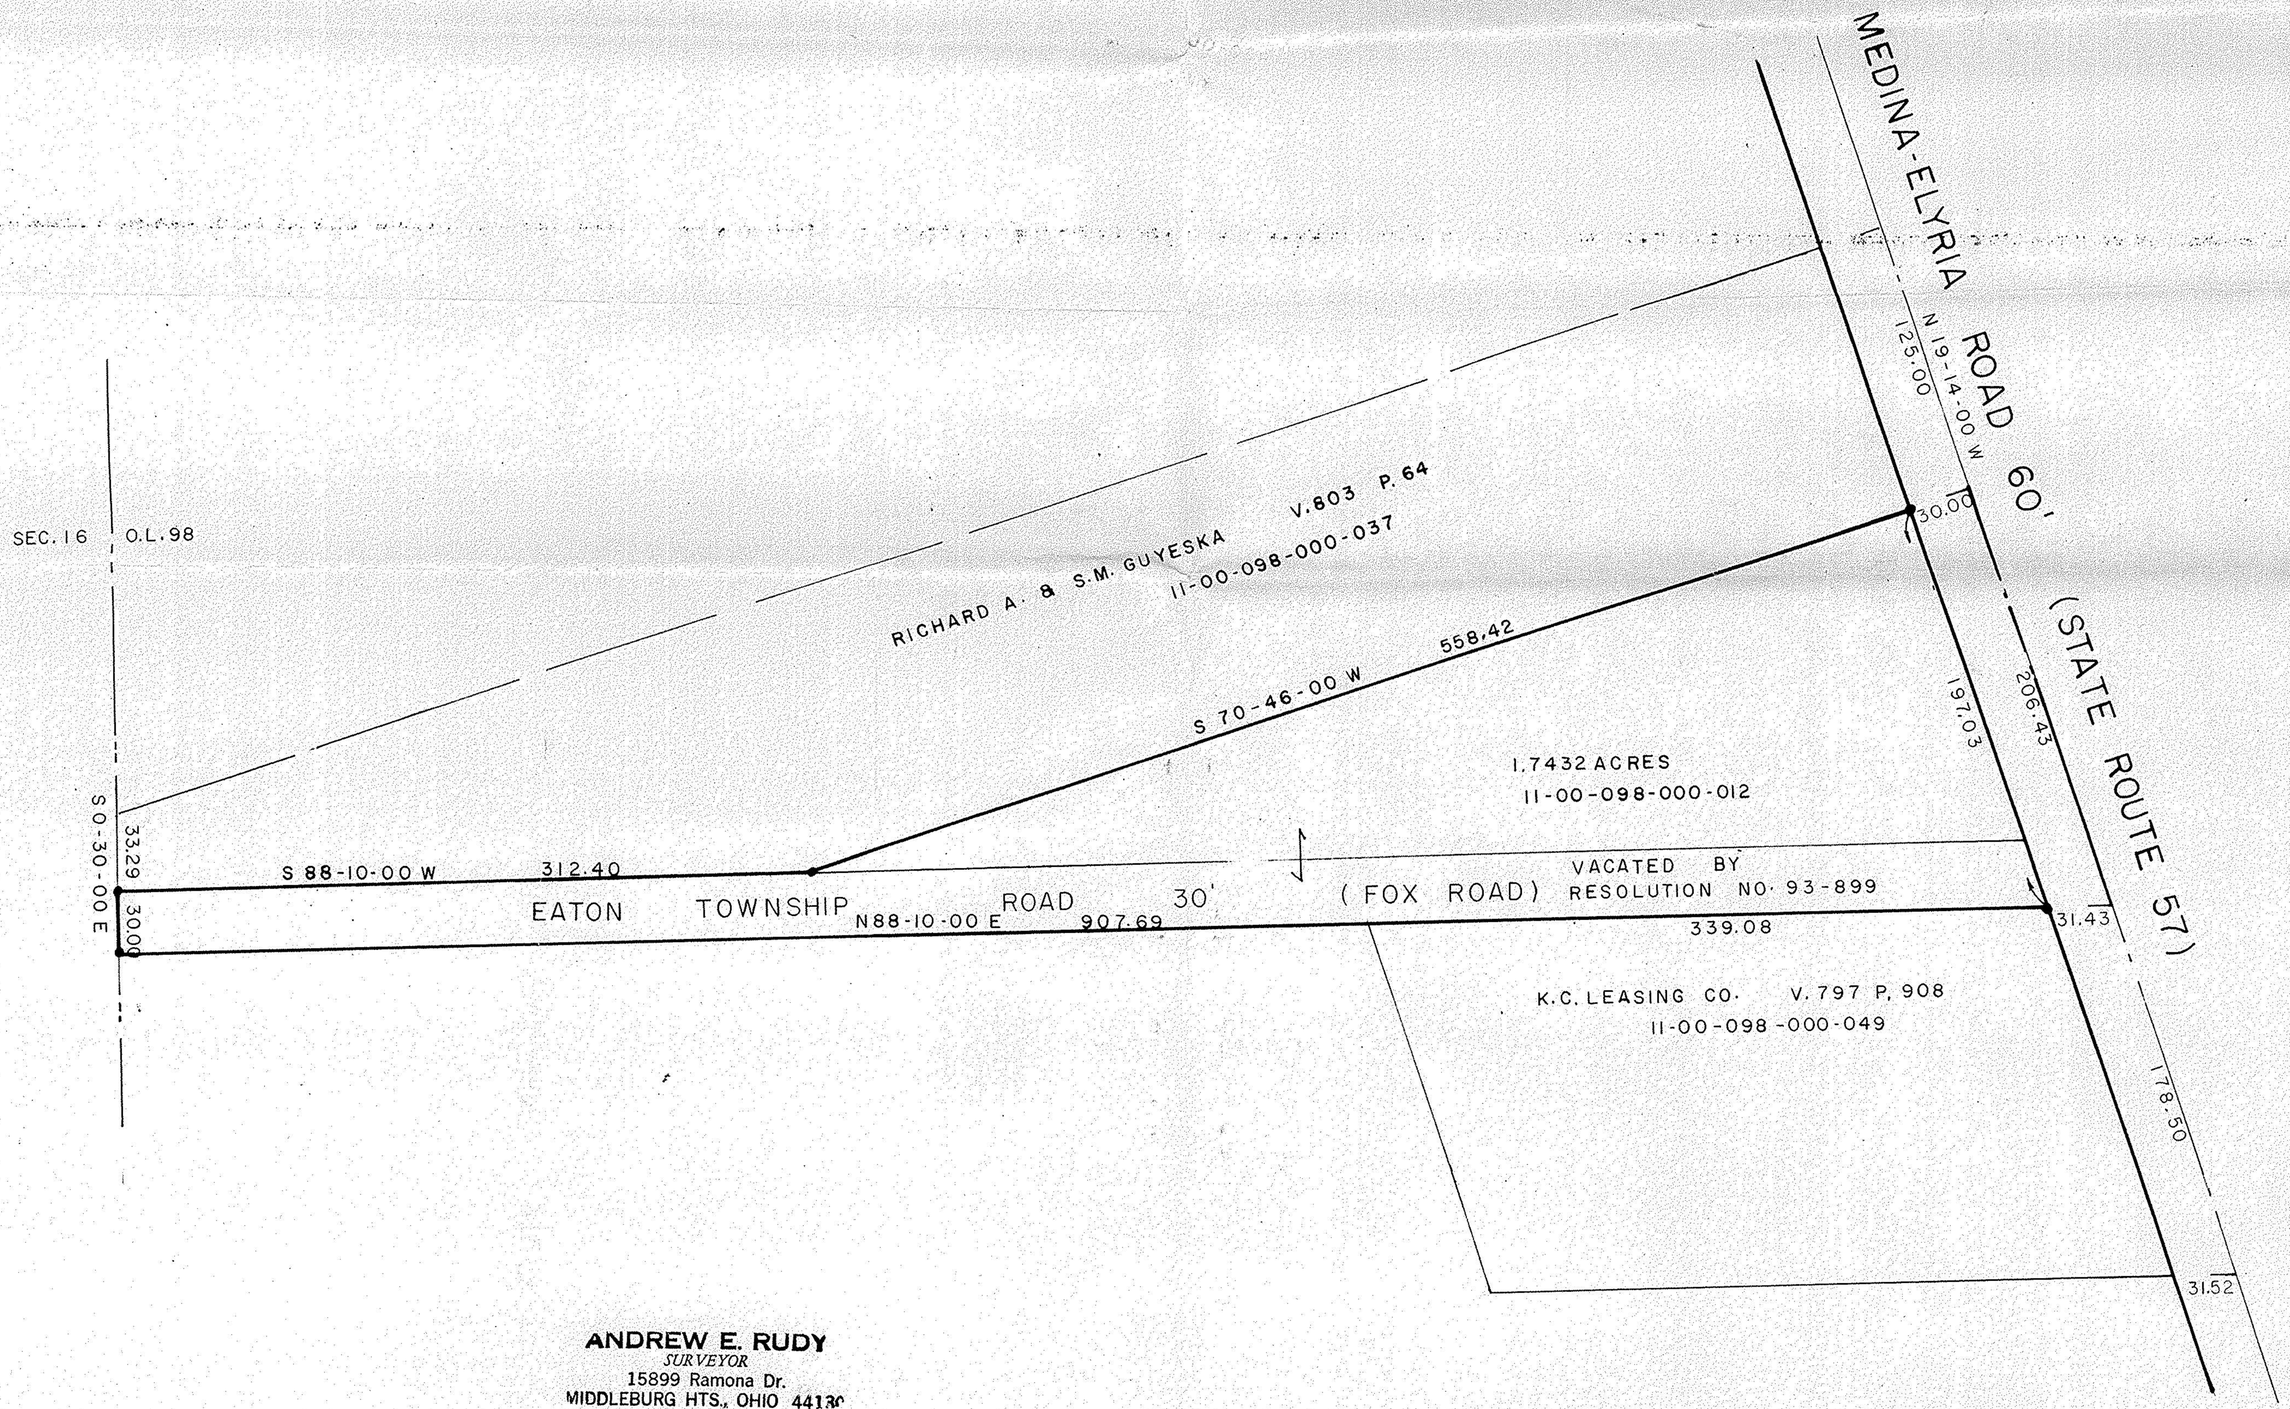

ANDREW E. RUDY
SURVEYOR
15899 Ramona Dr.
MIDDLEBURG HTS., OHIO 44130
216-267-0197