LAUNDON - SIMON - CAHL & ASSOC. INC.
CONSULTING ENGINEERS & SURVEYORS
ELYRIA, OHIO 44035

SURVEY FOR:
SUZANNE E. VANEK

Orig. Lot	City of	Date OCT '91 Scale 1"= 100
Orig. Sec 6	Village of	Dwn. by R.G.S. Chkd. by R.C.
Tract	County of LORAIN	Job No. 91-2105 F.B. 221 P 77
Township of CARLISLE	State of OHIO	Printed OCT 15 1991

10-00-006-G

#19552-A

10-00-006-120-

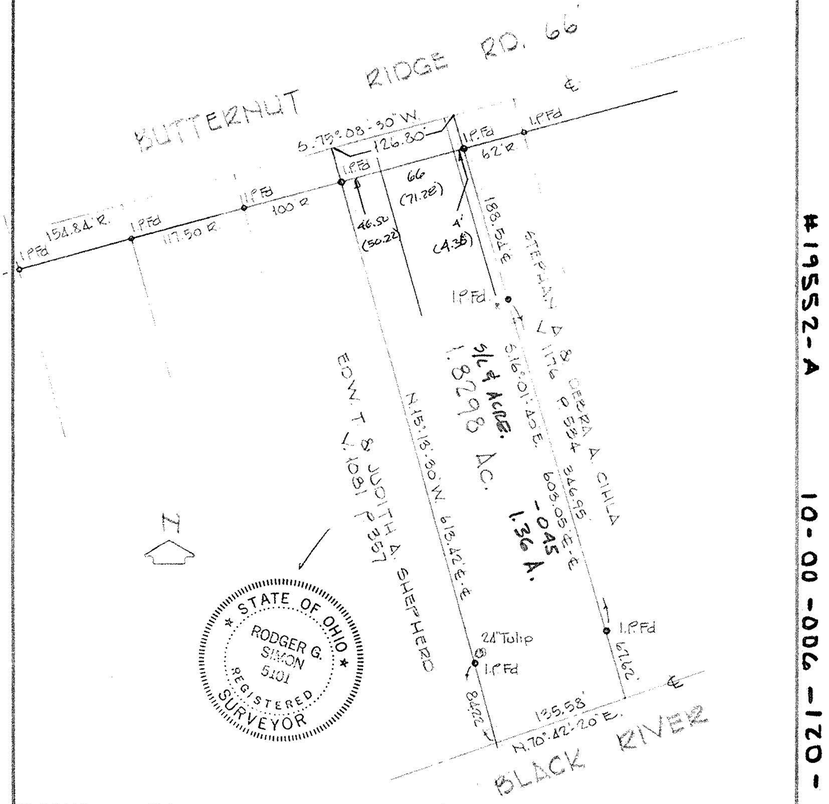

10-00-006-120-

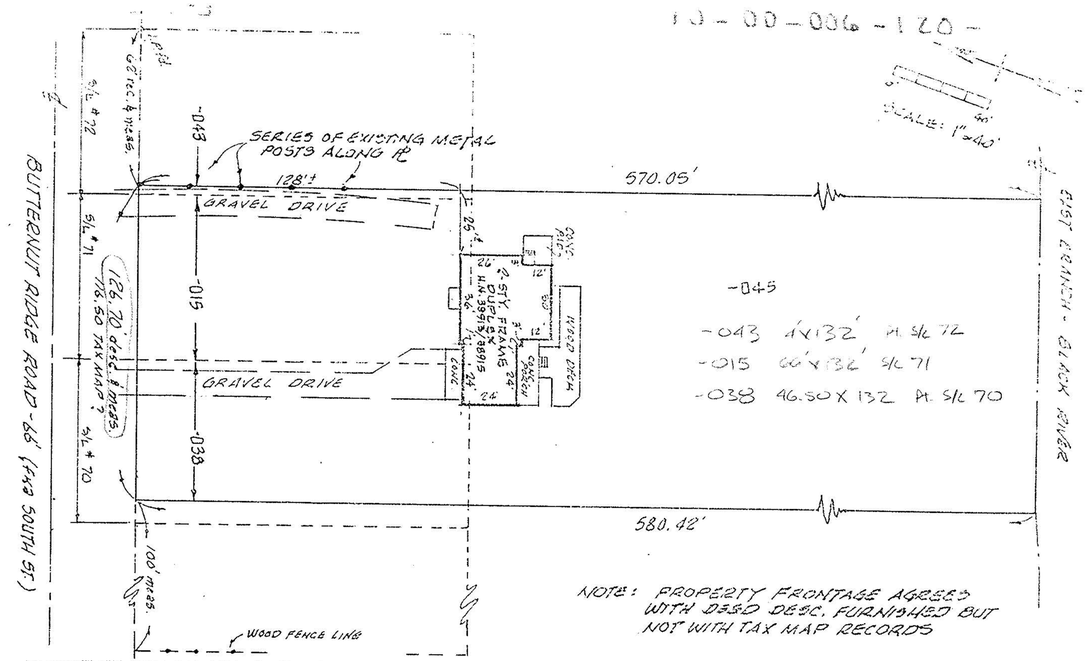

PARTS of SUBLOT Nos. 70 & 72 and ALL of SUBLOT No. 71 in the TOWN PLAT of LAPORTE - PLAT VOL. J, PG. 244; PLUS
PART of ORIG. CARLISLE TWP. SECTION No. 6
LORAIN COUNTY OHIO
PP Nos. 10-00-006-120-015; -038; -043 & -045

THIS IS NOT A PLAT OF SURVEY
FOR MORTGAGE LOAN PURPOSES ONLY

K. E. McCARTNEY & ASSOCIATES
SEPT. 17, 1991 #915664
MID. T. #10-30939-E