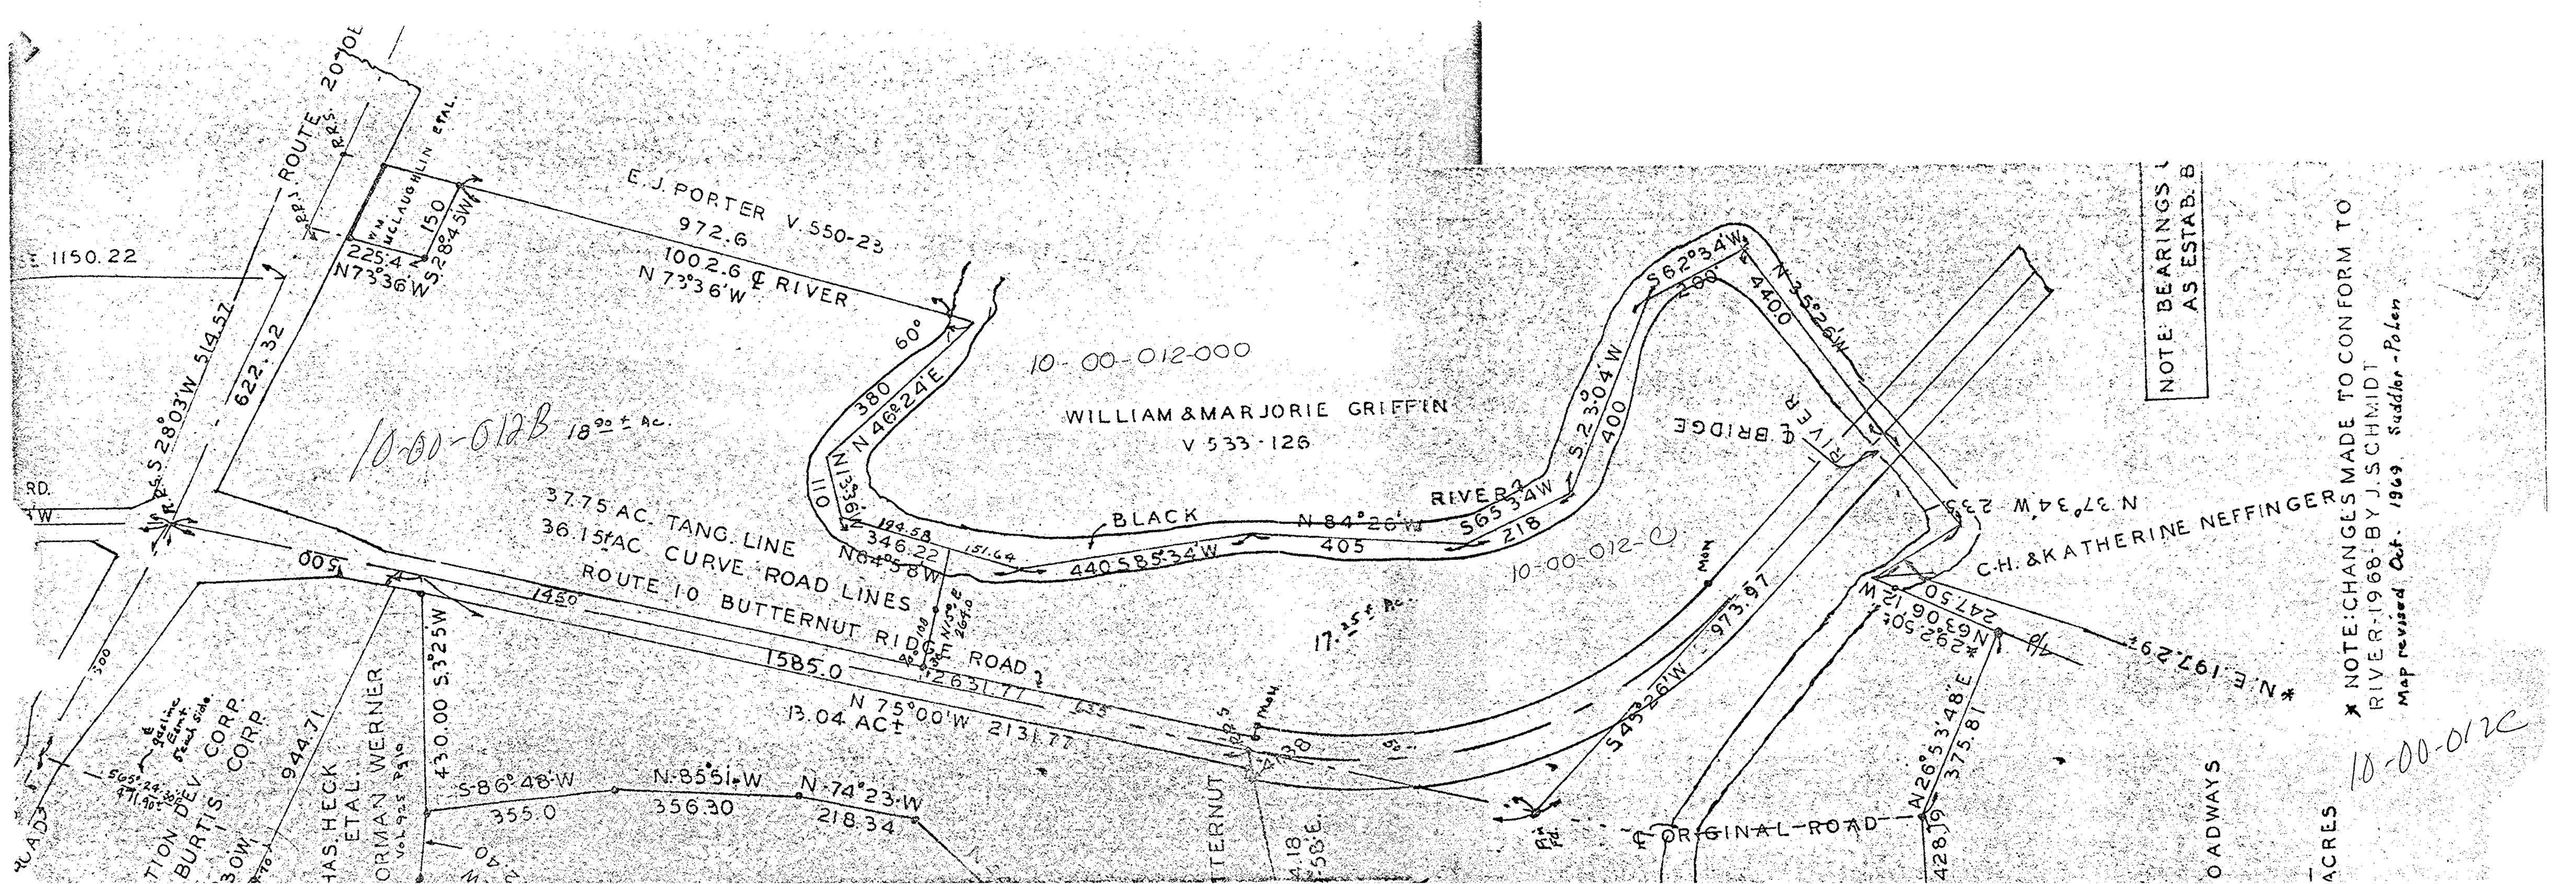
E.J. PORTER V.550-23
972.6
1002.6 ℄ RIVER
N 73°36'W
WM. McCLAUGHLIN ETAL.
N 73°36' W S 28°45' W
225.4
150
1150.22
S 28°03' W 514.52
622.32
10-00-012B 18.90± Ac.
10-00-012-000
WILLIAM & MARJORIE GRIFFIN
V 533-126
380
N 46°24' E
60°
N 13°36' E
110
194.58
346.22
N 64°58' W
151.64
BLACK RIVER
N 84°20' W
440
S 85°34' W
405
S 65°34' W
218
S 23°04' W
400
S 62°34' W
200
N 35°26' W
440.0
℄ BRIDGE
RIVER
37.75 AC. TANG. LINE
36.15 AC. CURVE ROAD LINES
ROUTE 10 BUTTERNUT RIDGE ROAD
1480
1585.0
N 75°00' W 2131.77
13.04 ACt
10-00-012-C
17.35± Ac.
973.97
S 45°26' W
N 37°34' W 233
C.H. & KATHERINE NEFFINGER
N 63°30' E 247.50
N 29°25' 50" E 192.29
375.81
N 26°53'48" E
428.79
ORIGINAL ROAD
430.00 S 3°25' W
S 86°48' W 355.0
N 85°51' W 356.30
N 74°23' W 218.34
944.71
S 65°22' 30" W 711.90
THOMAS HECK ETAL
NORMAN WERNER
Vol 905 Pg 10
CORP.
DEV. CORP.
BURTIS
NOTE: BEARINGS ... AS ESTAB. B
* NOTE: CHANGES MADE TO CONFORM TO RIVER-1968 BY J. SCHMIDT
Map revised Oct. 1969, Saddler-Polen
ACRES
ROADWAYS
10-00-012C