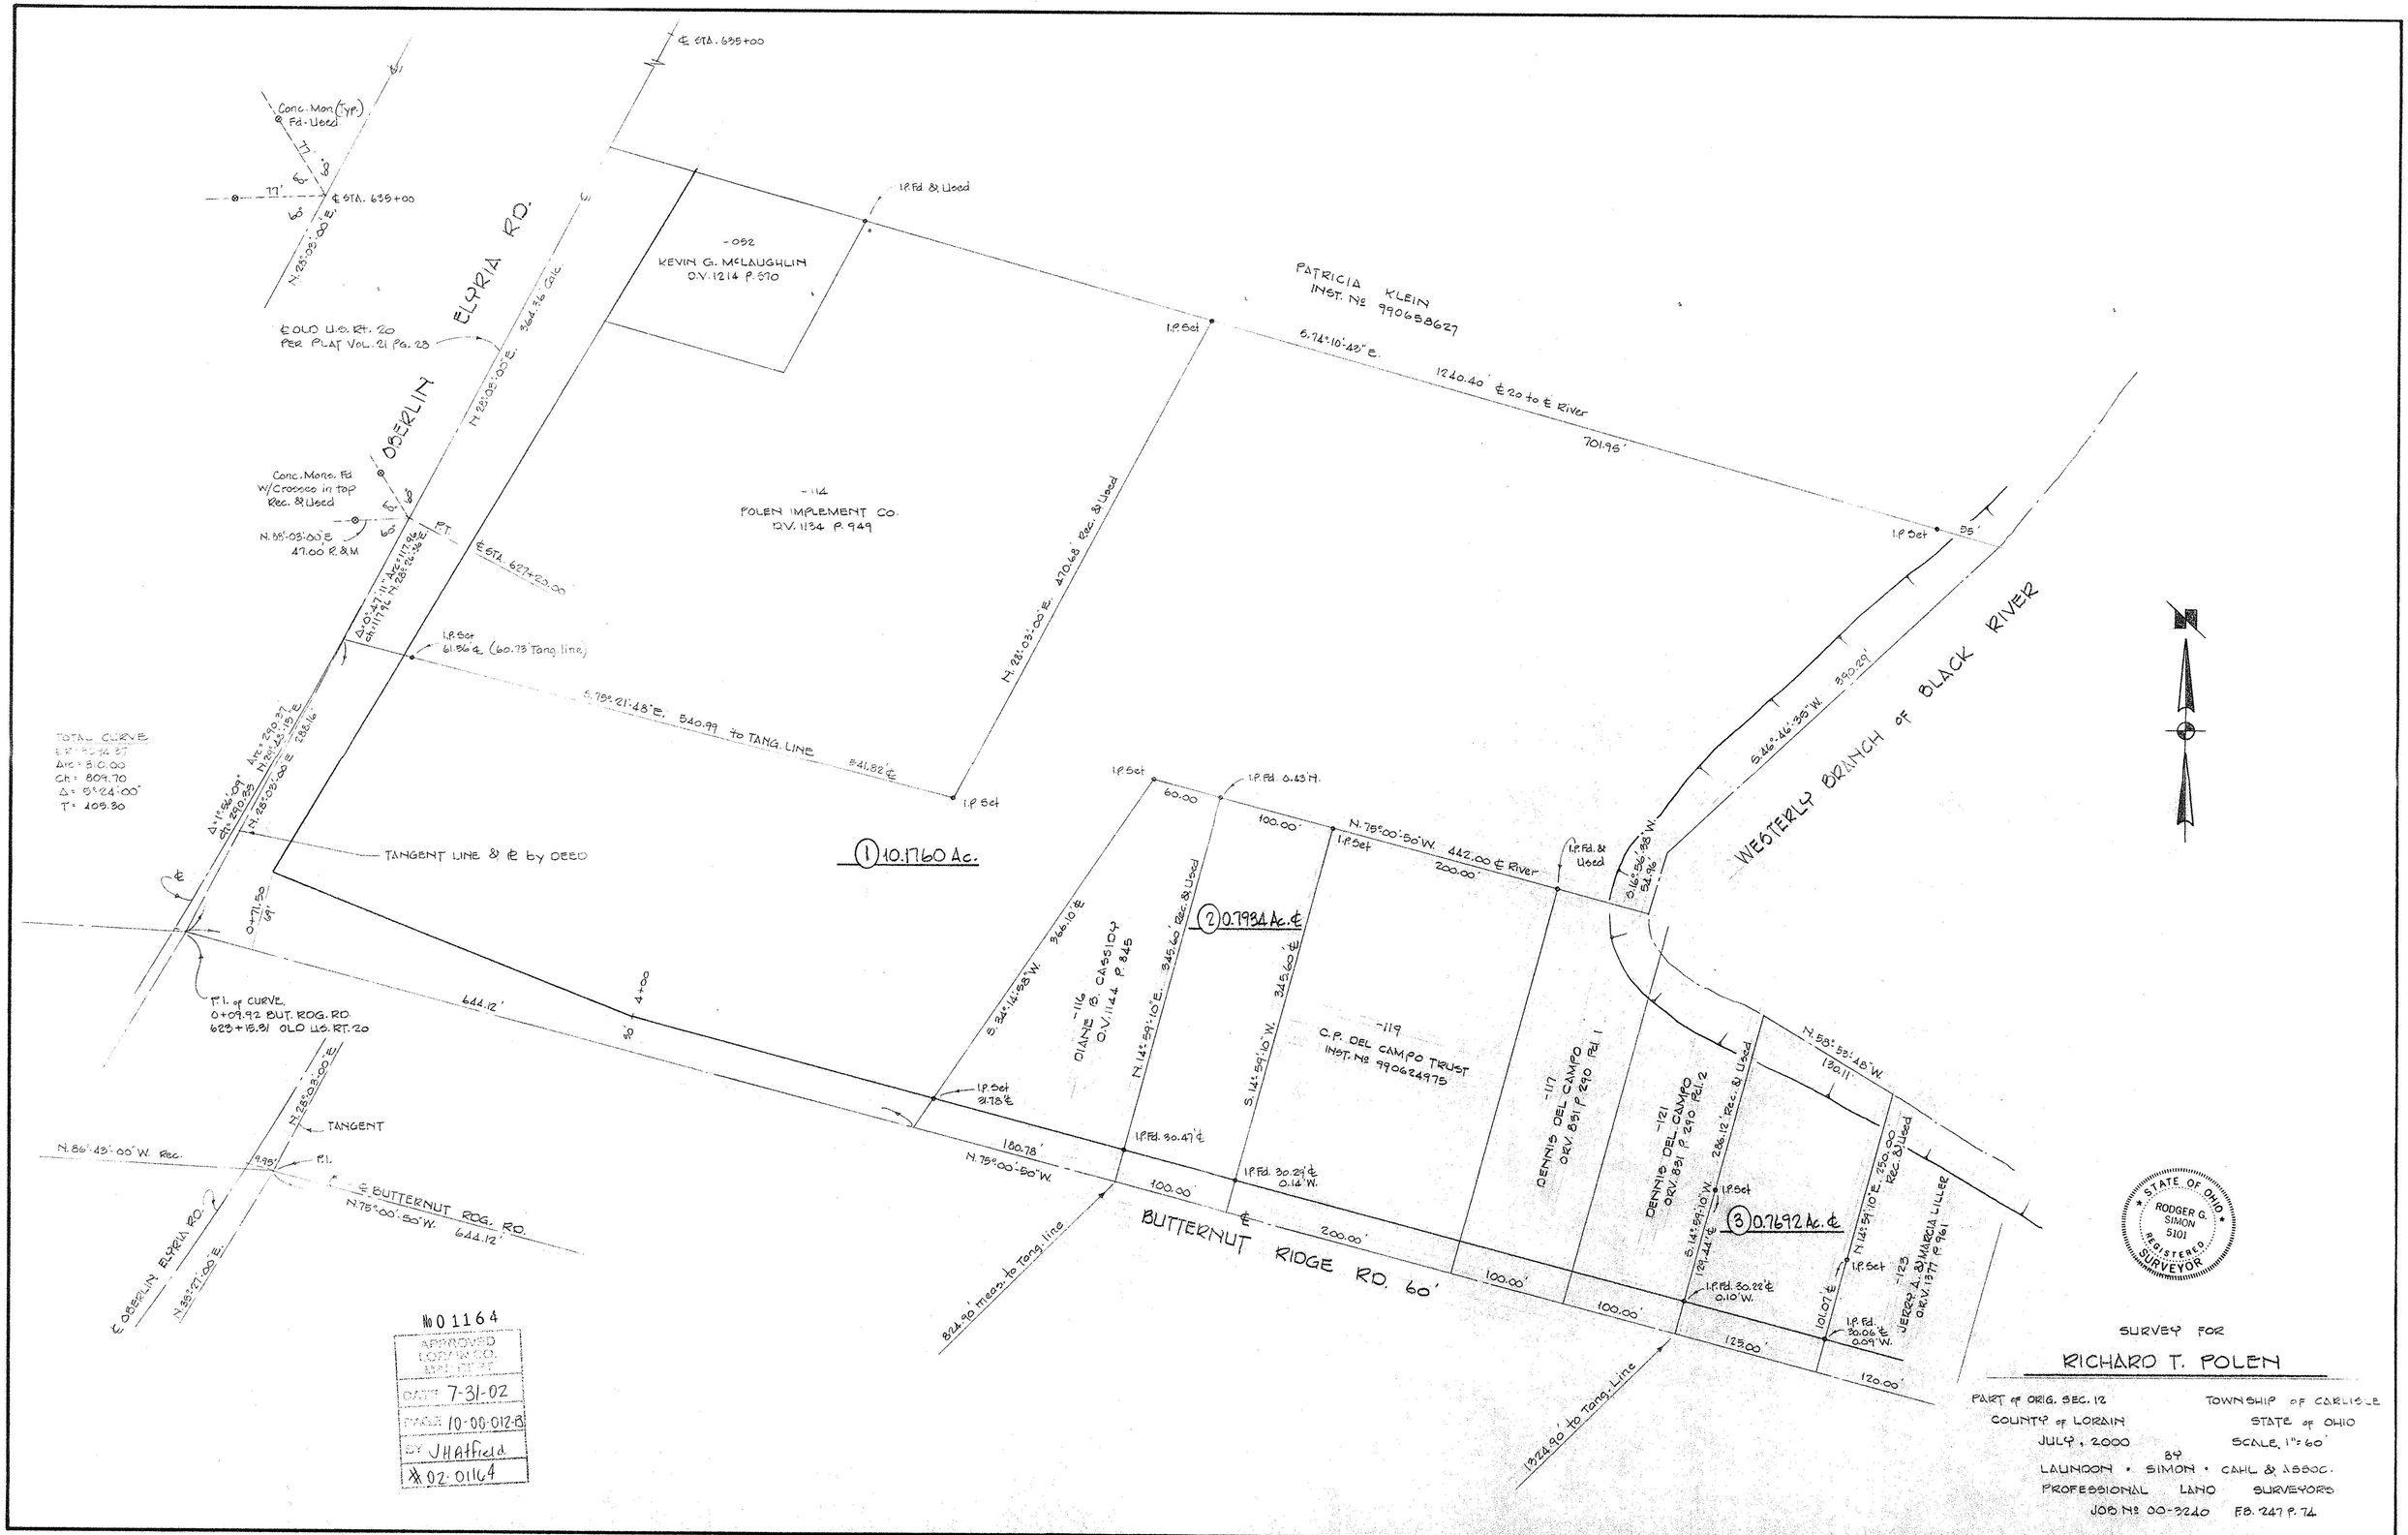

SURVEY FOR

RICHARD T. POLEN

PART OF ORIG. SEC. 12 — TOWNSHIP OF CARLISLE

COUNTY OF LORAIN — STATE OF OHIO

JULY, 2000 — SCALE 1" = 60'

BY

LAUNDON • SIMON • CAHL & ASSOC.

PROFESSIONAL LAND SURVEYORS

JOB Nº 00-3240 F.B. 247 P. 74

388