PLAT OF SURVEYS FOR SHIRLEY A. SADDLER

SECTION No. 12

CARLISLE TOWNSHIP

LORAIN COUNTY-OHIO

SCALE: 1" = 60'

OCTOBER-1974

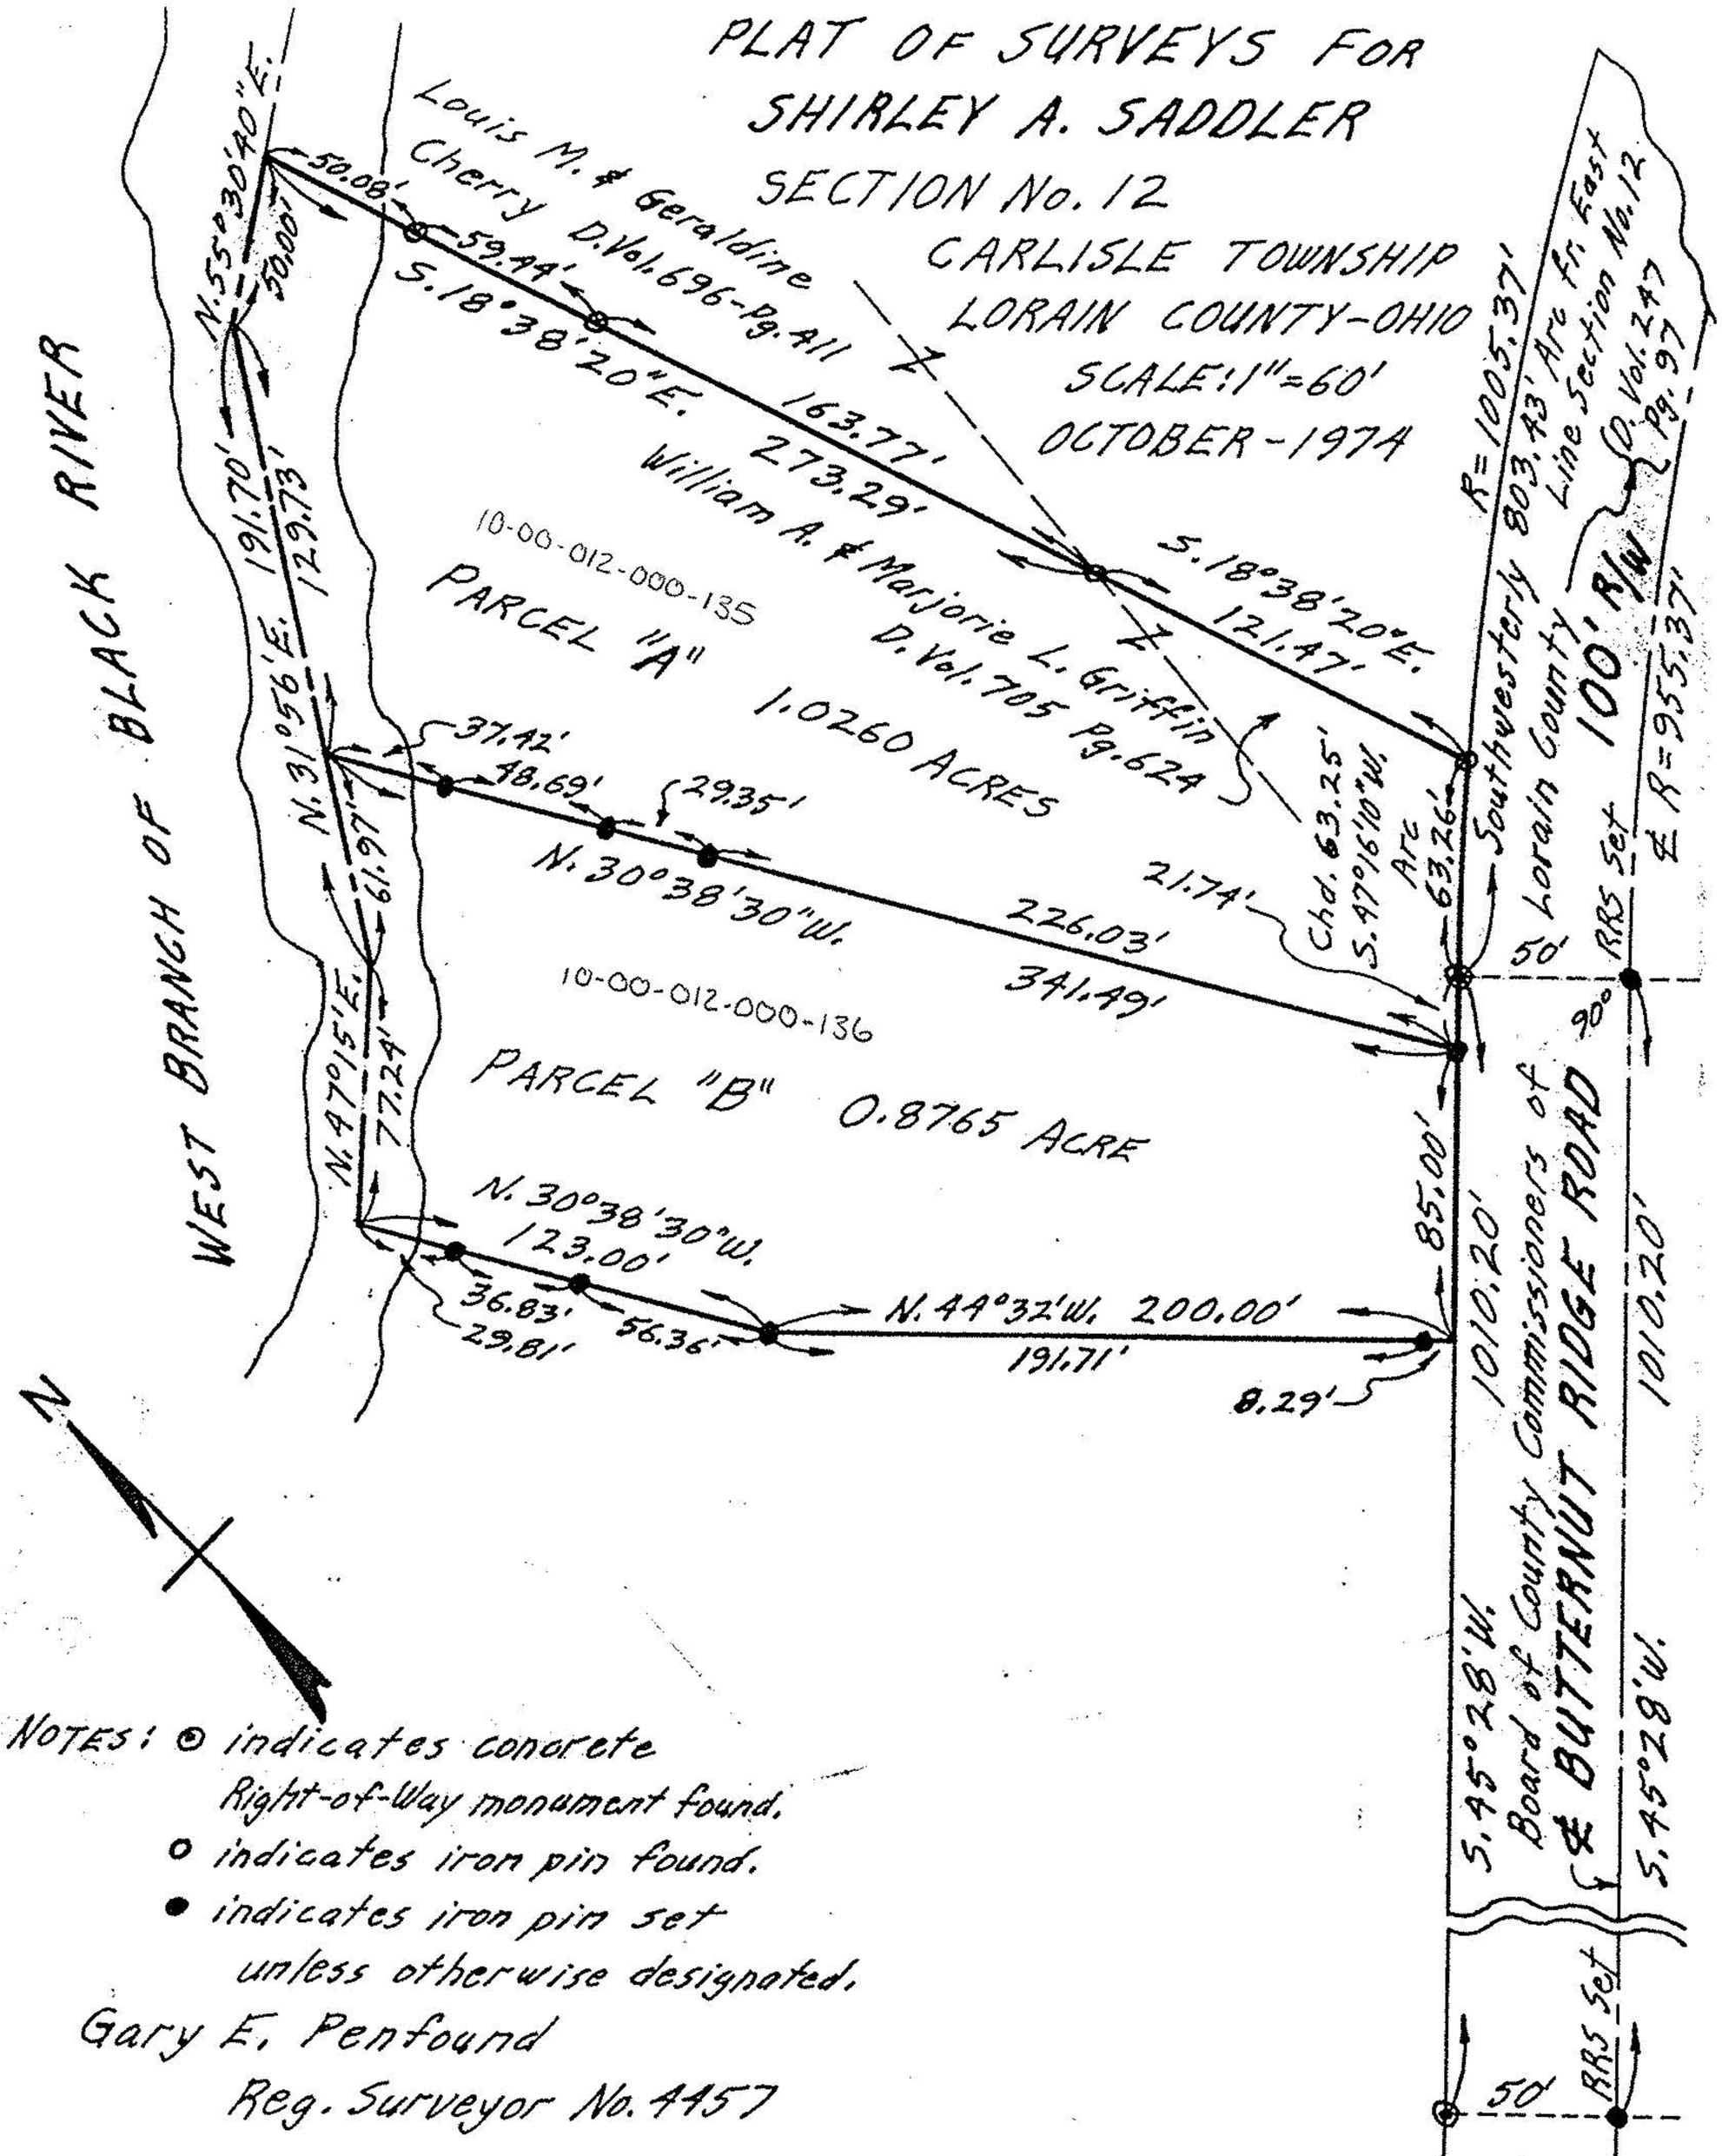

NOTES: ⊙ indicates concrete Right-of-Way monument found.

○ indicates iron pin found.

● indicates iron pin set unless otherwise designated.

Gary E. Penfound

Reg. Surveyor No. 4457