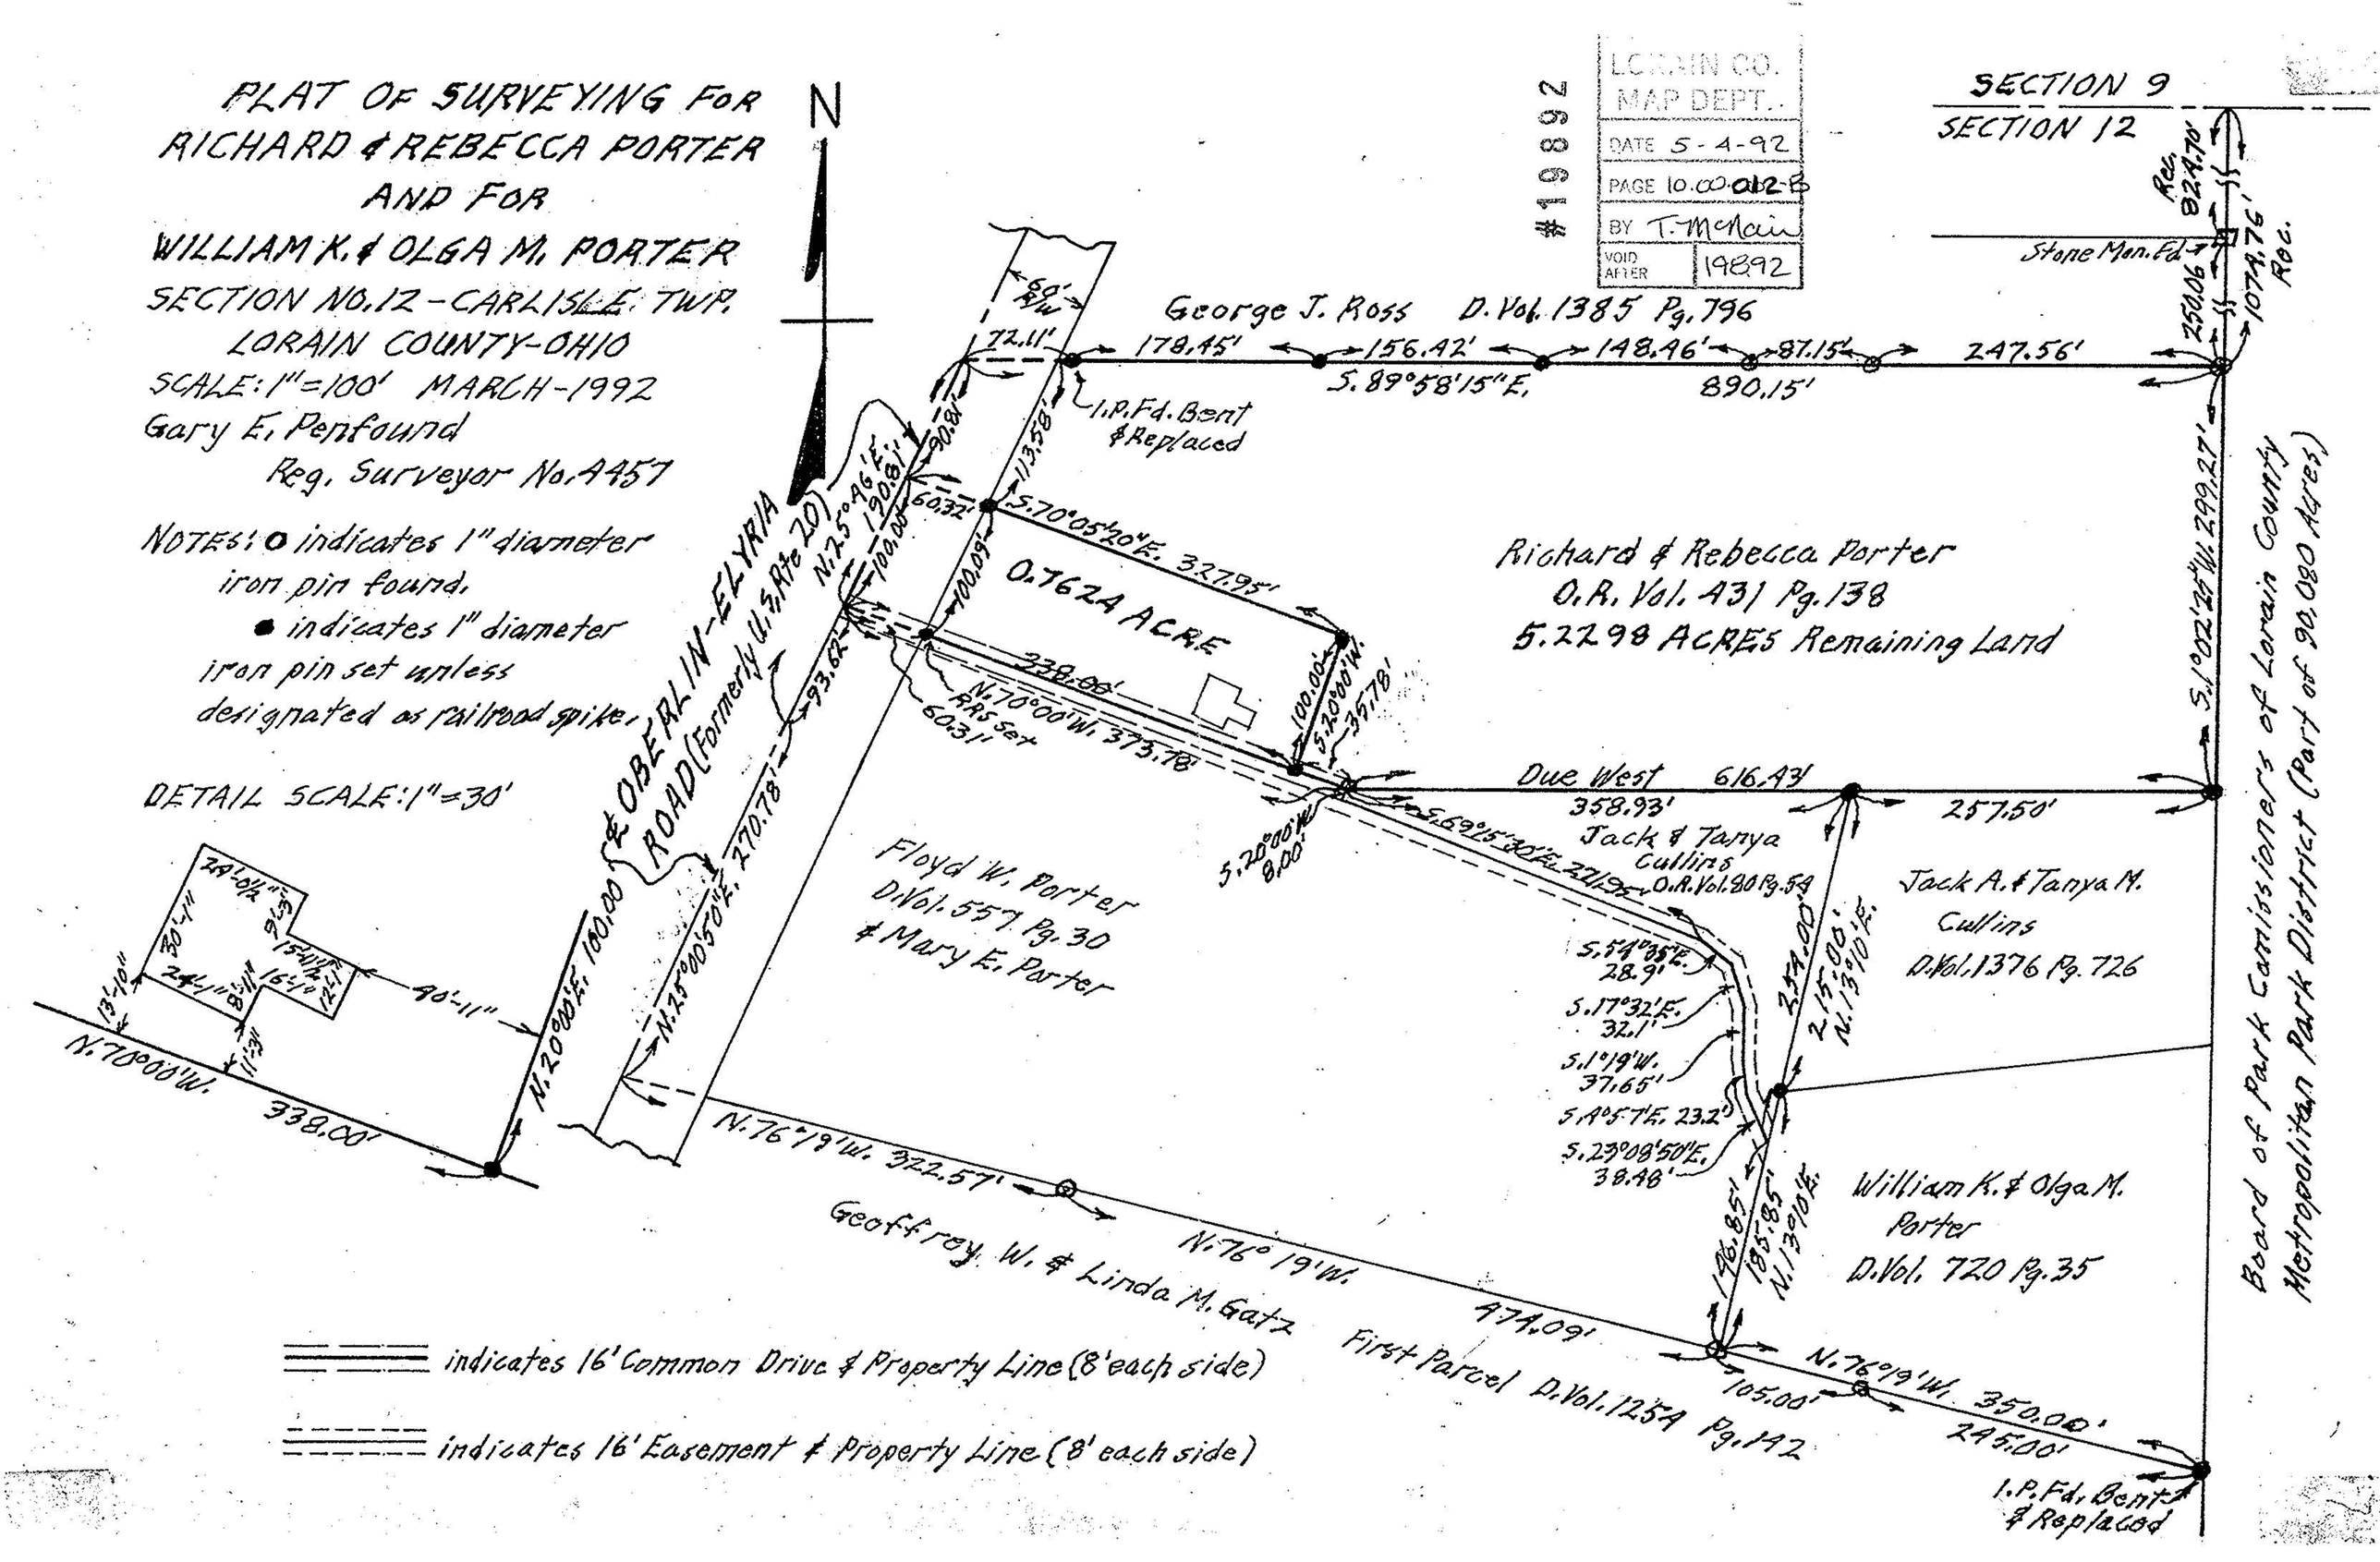
PLAT OF SURVEYING FOR
RICHARD & REBECCA PORTER
AND FOR
WILLIAM K. & OLGA M. PORTER
SECTION NO. 12 - CARLISLE TWP.
LORAIN COUNTY-OHIO
SCALE: 1"=100' MARCH-1992
Gary E. Penfound
Reg. Surveyor No. 4457
NOTES: o indicates 1" diameter iron pin found.
• indicates 1" diameter iron pin set unless designated as railroad spike.
DETAIL SCALE: 1"=30'
N
#19892
LORAIN CO. MAP DEPT.
DATE 5-4-92
PAGE 10.00.012-B
BY T. McNair
VOID AFTER 19892
SECTION 9
SECTION 12
Rec. 824.70'
Stone Mon. Fd.
1074.76' Rec.
250.06
George J. Ross D. Vol. 1385 Pg. 796
178.45'
156.42'
148.46'
87.15'
247.56'
S. 89°58'15"E.
890.15'
72.11'
60' R/W
I.P. Fd. Bent & Replaced
S. 70°05'20"E. 327.95'
0.7624 ACRE
338.00'
N. 70°00'W. 373.78'
RRS Set
60.31'
100.00'
S. 20°00'W. 35.78'
S. 20°00'W. 8.00'
S. 69°15'30"E. 271.95'
Richard & Rebecca Porter
O.R. Vol. 431 Pg. 138
5.2298 ACRES Remaining Land
Due West 616.43'
358.93'
257.50'
Jack & Tanya Cullins
O.R. Vol. 80 Pg. 54
Jack A. & Tanya M. Cullins
D. Vol. 1376 Pg. 726
S. 1°02'25"W. 299.27'
Board of Park Comissioners of Lorain County
Metropolitan Park District (Part of 90.080 Acres)
N. 25°46'E. 190.81'
90.81'
113.58'
60.32'
100.00'
100.09'
93.62'
N. 25°00'50"E. 270.78'
N. 20°00'E. 100.00'
OBERLIN-ELYRIA ROAD (Formerly U.S. Rte 20)
Floyd W. Porter
D. Vol. 557 Pg. 30
& Mary E. Porter
S. 54°35'E. 28.9'
S. 17°32'E. 32.1'
S. 1°19'W. 37.65'
S. 4°57'E. 23.2'
S. 23°08'50"E. 38.48'
254.00'
215.00'
N. 13°10'E.
196.85'
185.85'
N. 13°10'E.
William K. & Olga M. Porter
D. Vol. 720 Pg. 35
N. 76°19'W. 322.57'
N. 76° 19'W.
474.09'
Geoffrey W. & Linda M. Gatz
First Parcel D. Vol. 1254 Pg. 142
105.00'
N. 76°19'W. 350.00'
245.00'
I.P. Fd. Bent & Replaced
N. 70°00'W.
338.00'
40'-11"
13'-10"
24'-0½"
30'-1"
24'-1"
8'-11"
16'-1"
15'-11½"
12'-1"
9'-3"
11'-3"
indicates 16' Common Drive & Property Line (8' each side)
indicates 16' Easement & Property Line (8' each side)