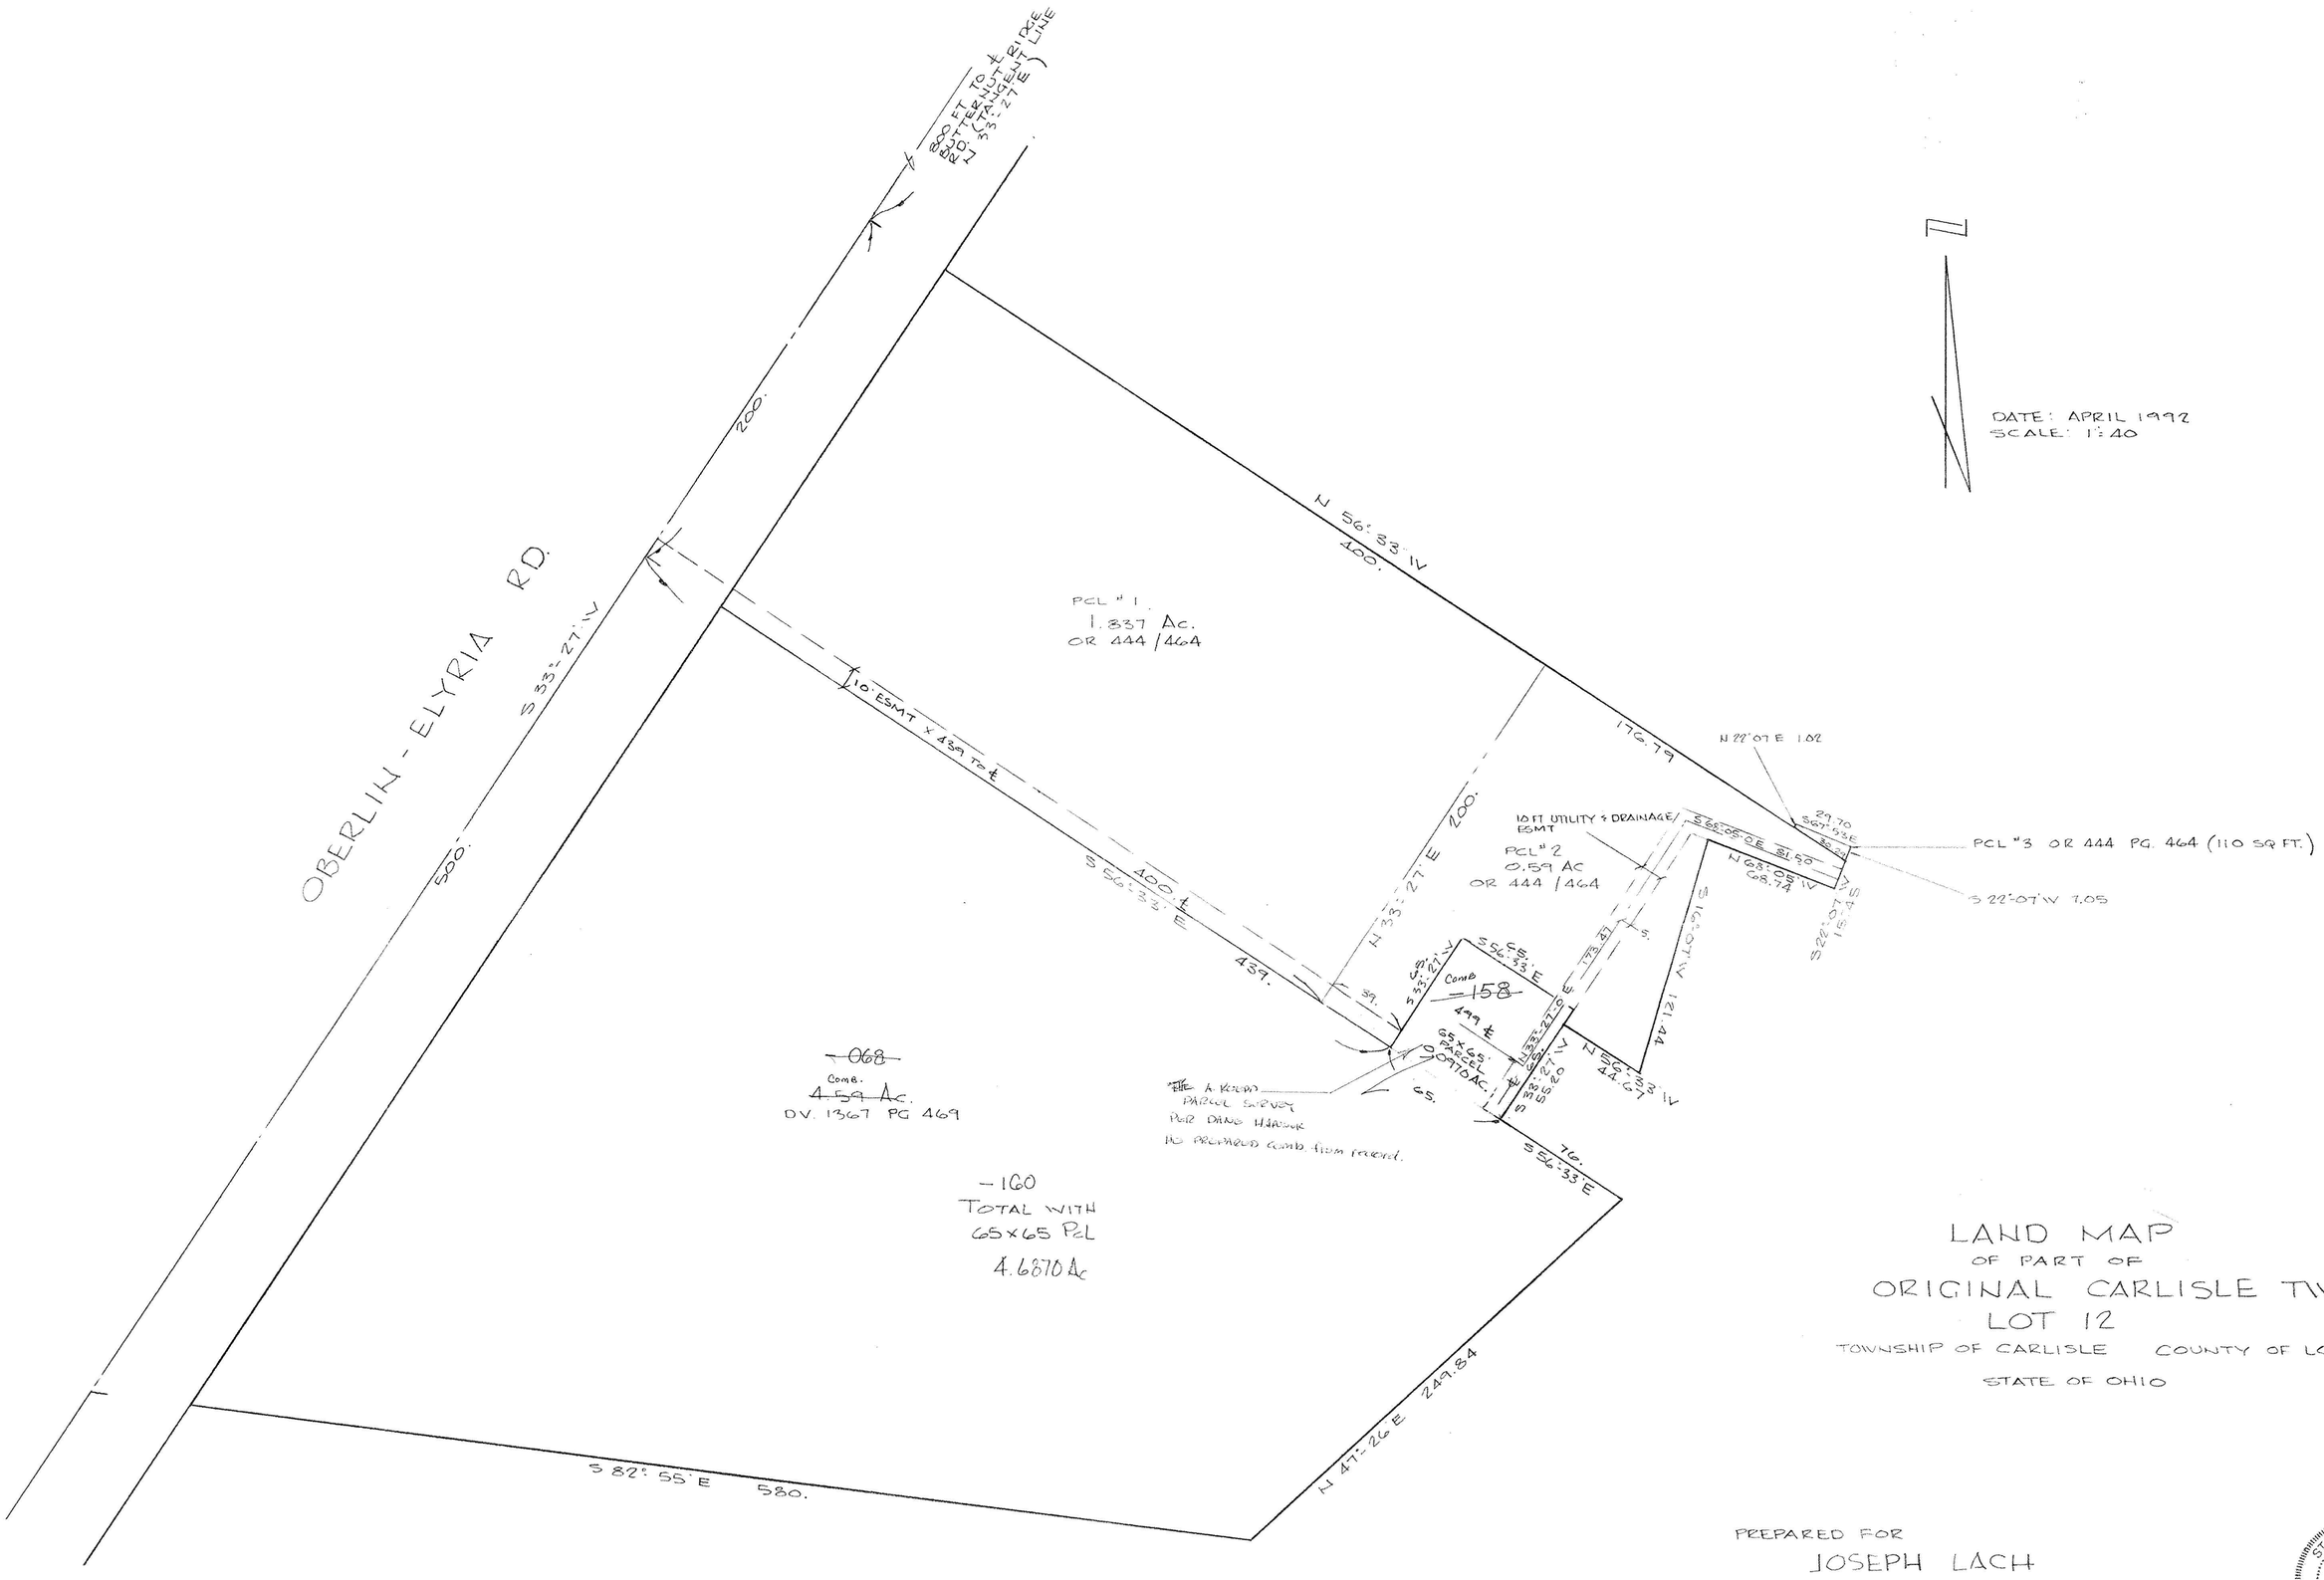

DATE: APRIL 1992
SCALE: 1" = 40

LAND MAP
OF PART OF
ORIGINAL CARLISLE TWP
LOT 12

TOWNSHIP OF CARLISLE COUNTY OF LORAIN

STATE OF OHIO

PREPARED FOR
JOSEPH LACH
2989 HAYES ST.
AVON, OHIO

STATE OF OHIO
DANE A. HAPONEK
S-6211
REGISTERED SURVEYOR

REVISED 8-26-94 ADDED ESMT & 65X65' PCL
REVISED 7/14/94 ADDED ESMT
REVISED 12/20/94 COMBINED 65 X 65 PCL & 4.59 Ac PCL

92-15