KLEINOEDER · SCHMIDT and ASSOCIATES

ENGINEERS — SURVEYORS — CONSULTANTS in LAND PLANNING

ELYRIA · NORWALK · MEDINA OHIO

PLOT PLAN

JOB Nº 82-52

SUBLOT ALL OF 163 & PART OF 164

SUBDIVISION BRENTWOOD ALLOTMENT Nº 4 P.V. 19 P. 20-21

OTHER 0.5162 AC.

1333/532

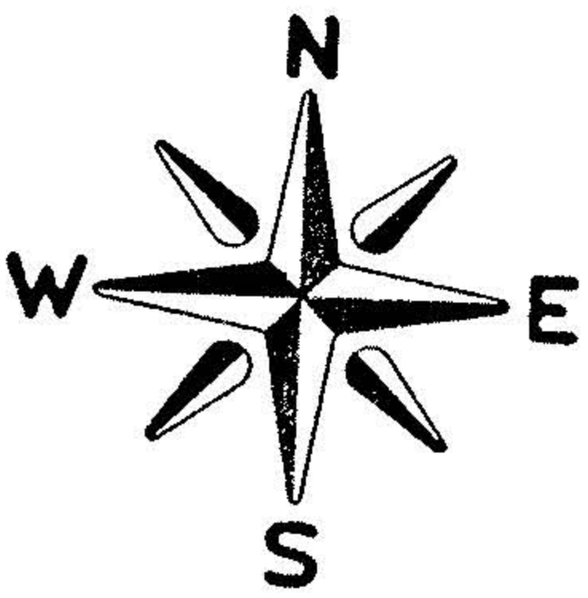

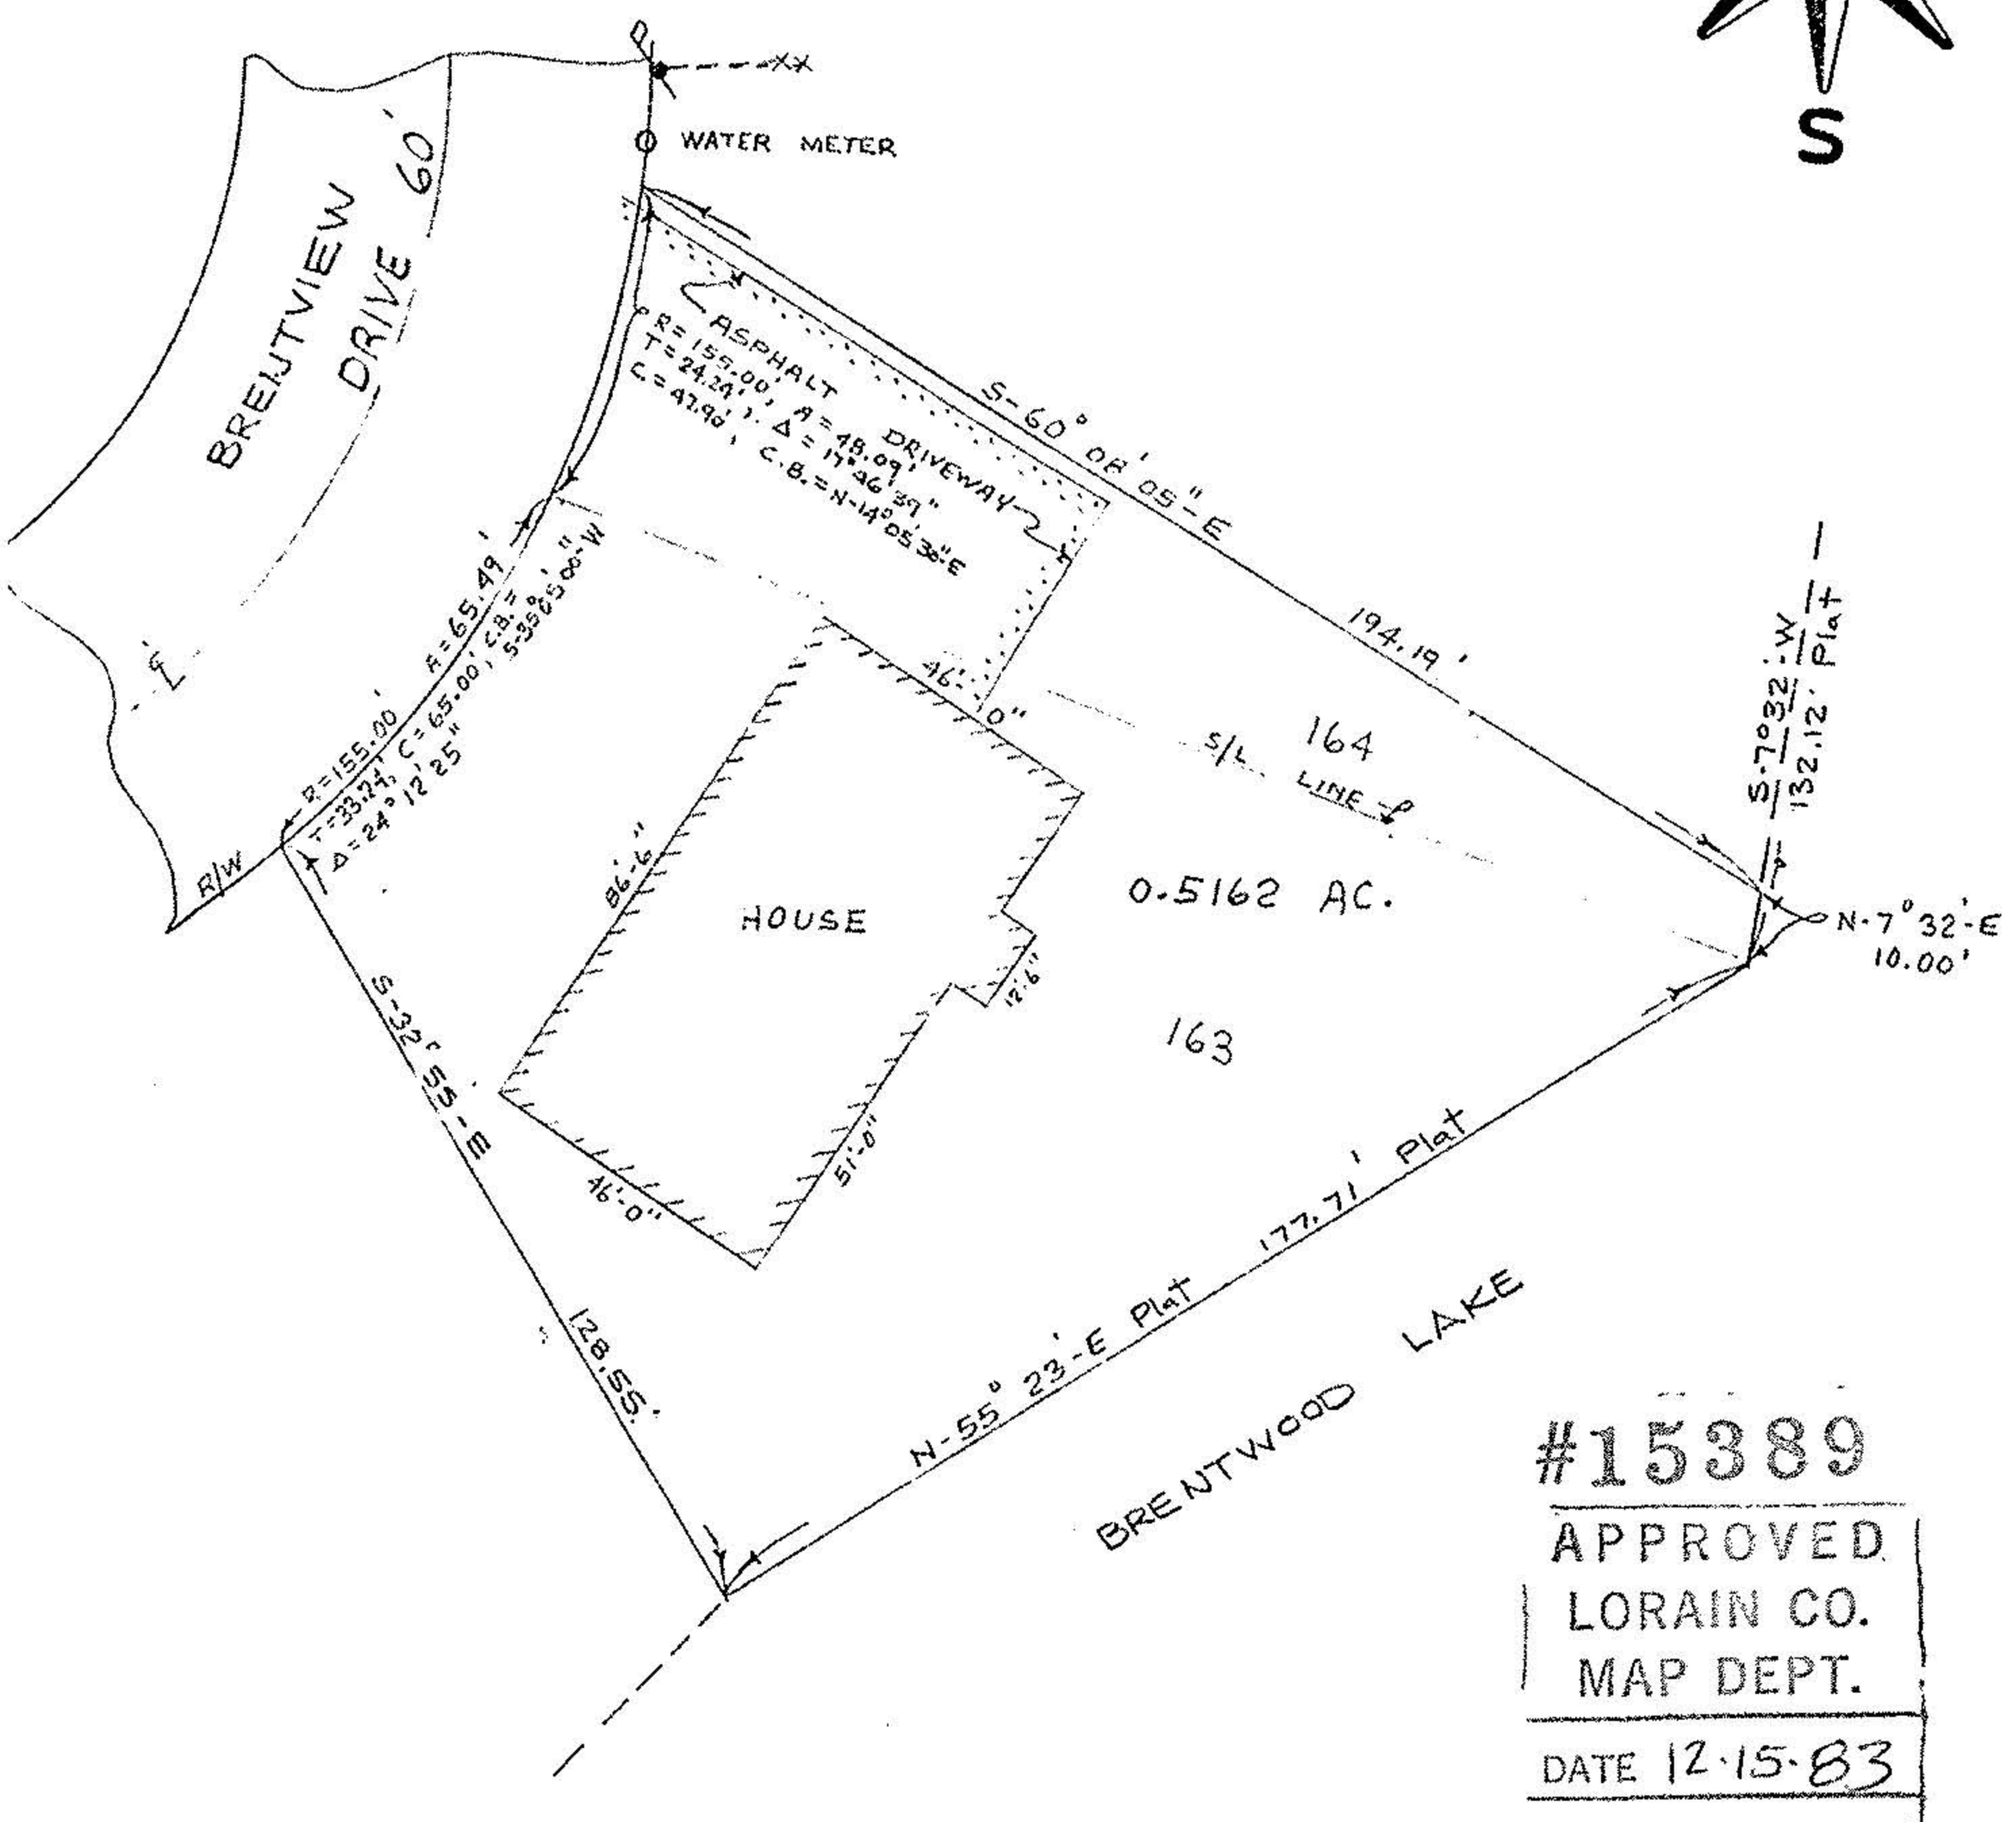

#15389

APPROVED
LORAIN CO.
MAP DEPT.

DATE 12-15-83

PAGE 10.00.015.C

BY T. McMain

VOID AFTER

Prepared for: DEL SPITZER

Scale: 1" = 40'

Date: JULY 15th 1982 REV. 9-22-83