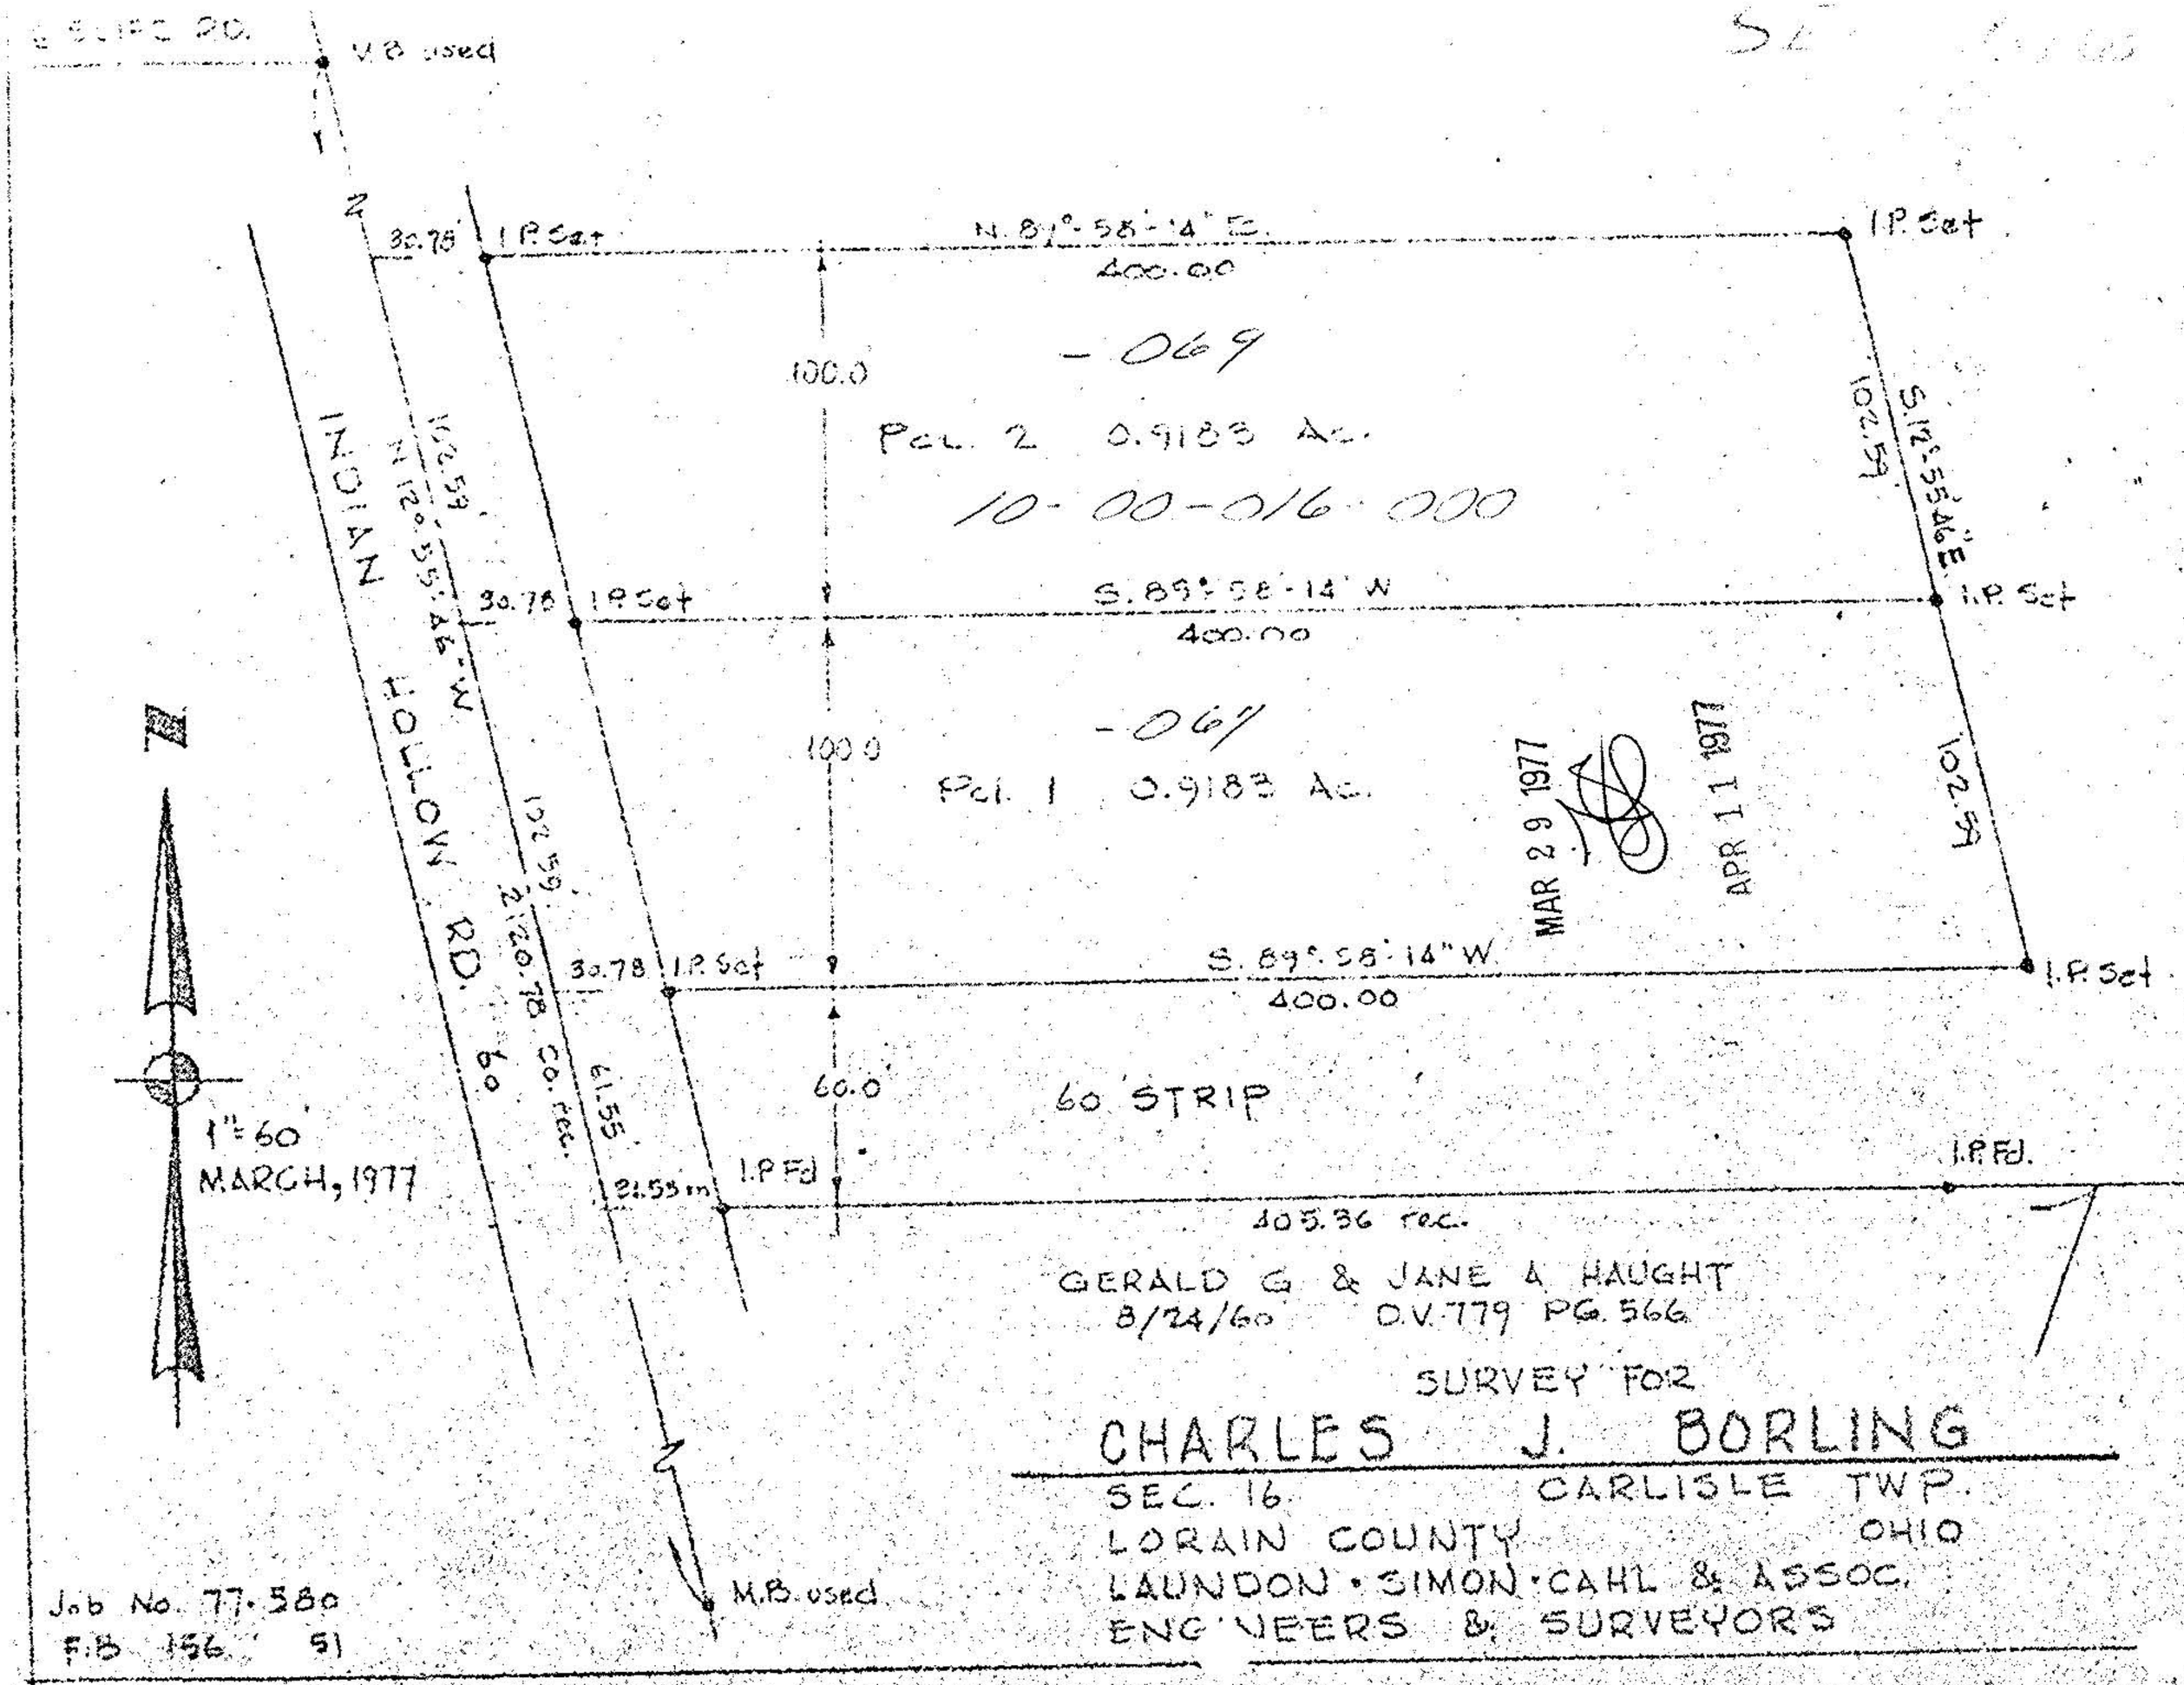

16
SE
℄ SLIFE RD.
V.B. used
30.78
I.P. Set
N. 89°-58'-14" E.
400.00
I.P. Set
100.0
-069
Pcl. 2 0.9183 Ac.
10-00-016-000
102.59
S. 12°-55'-46" E.
102.59
INDIAN HOLLOW RD.
N. 12°-55'-46" W.
30.78
I.P. Set
S. 89°-58'-14" W.
400.00
I.P. Set
100.0
-067
Pcl. 1 0.9183 Ac.
MAR 29 1977
APR 11 1977
102.59
102.59
2120.78 Co. rec.
30.78
I.P. Set
S. 89°-58'-14" W.
400.00
I.P. Set
60
61.55
60.0
60 STRIP
1"=60'
MARCH, 1977
21.55 m
I.P. Fd.
I.P. Fd.
405.36 rec.
GERALD G. & JANE A. HAUGHT
8/24/60 D.V. 779 PG. 566
SURVEY FOR
CHARLES J. BORLING
SEC. 16 CARLISLE TWP.
LORAIN COUNTY OHIO
LAUNDON · SIMON · CAHL & ASSOC.
ENGINEERS & SURVEYORS
M.B. used
Job No. 77-580
F.B. 156 51