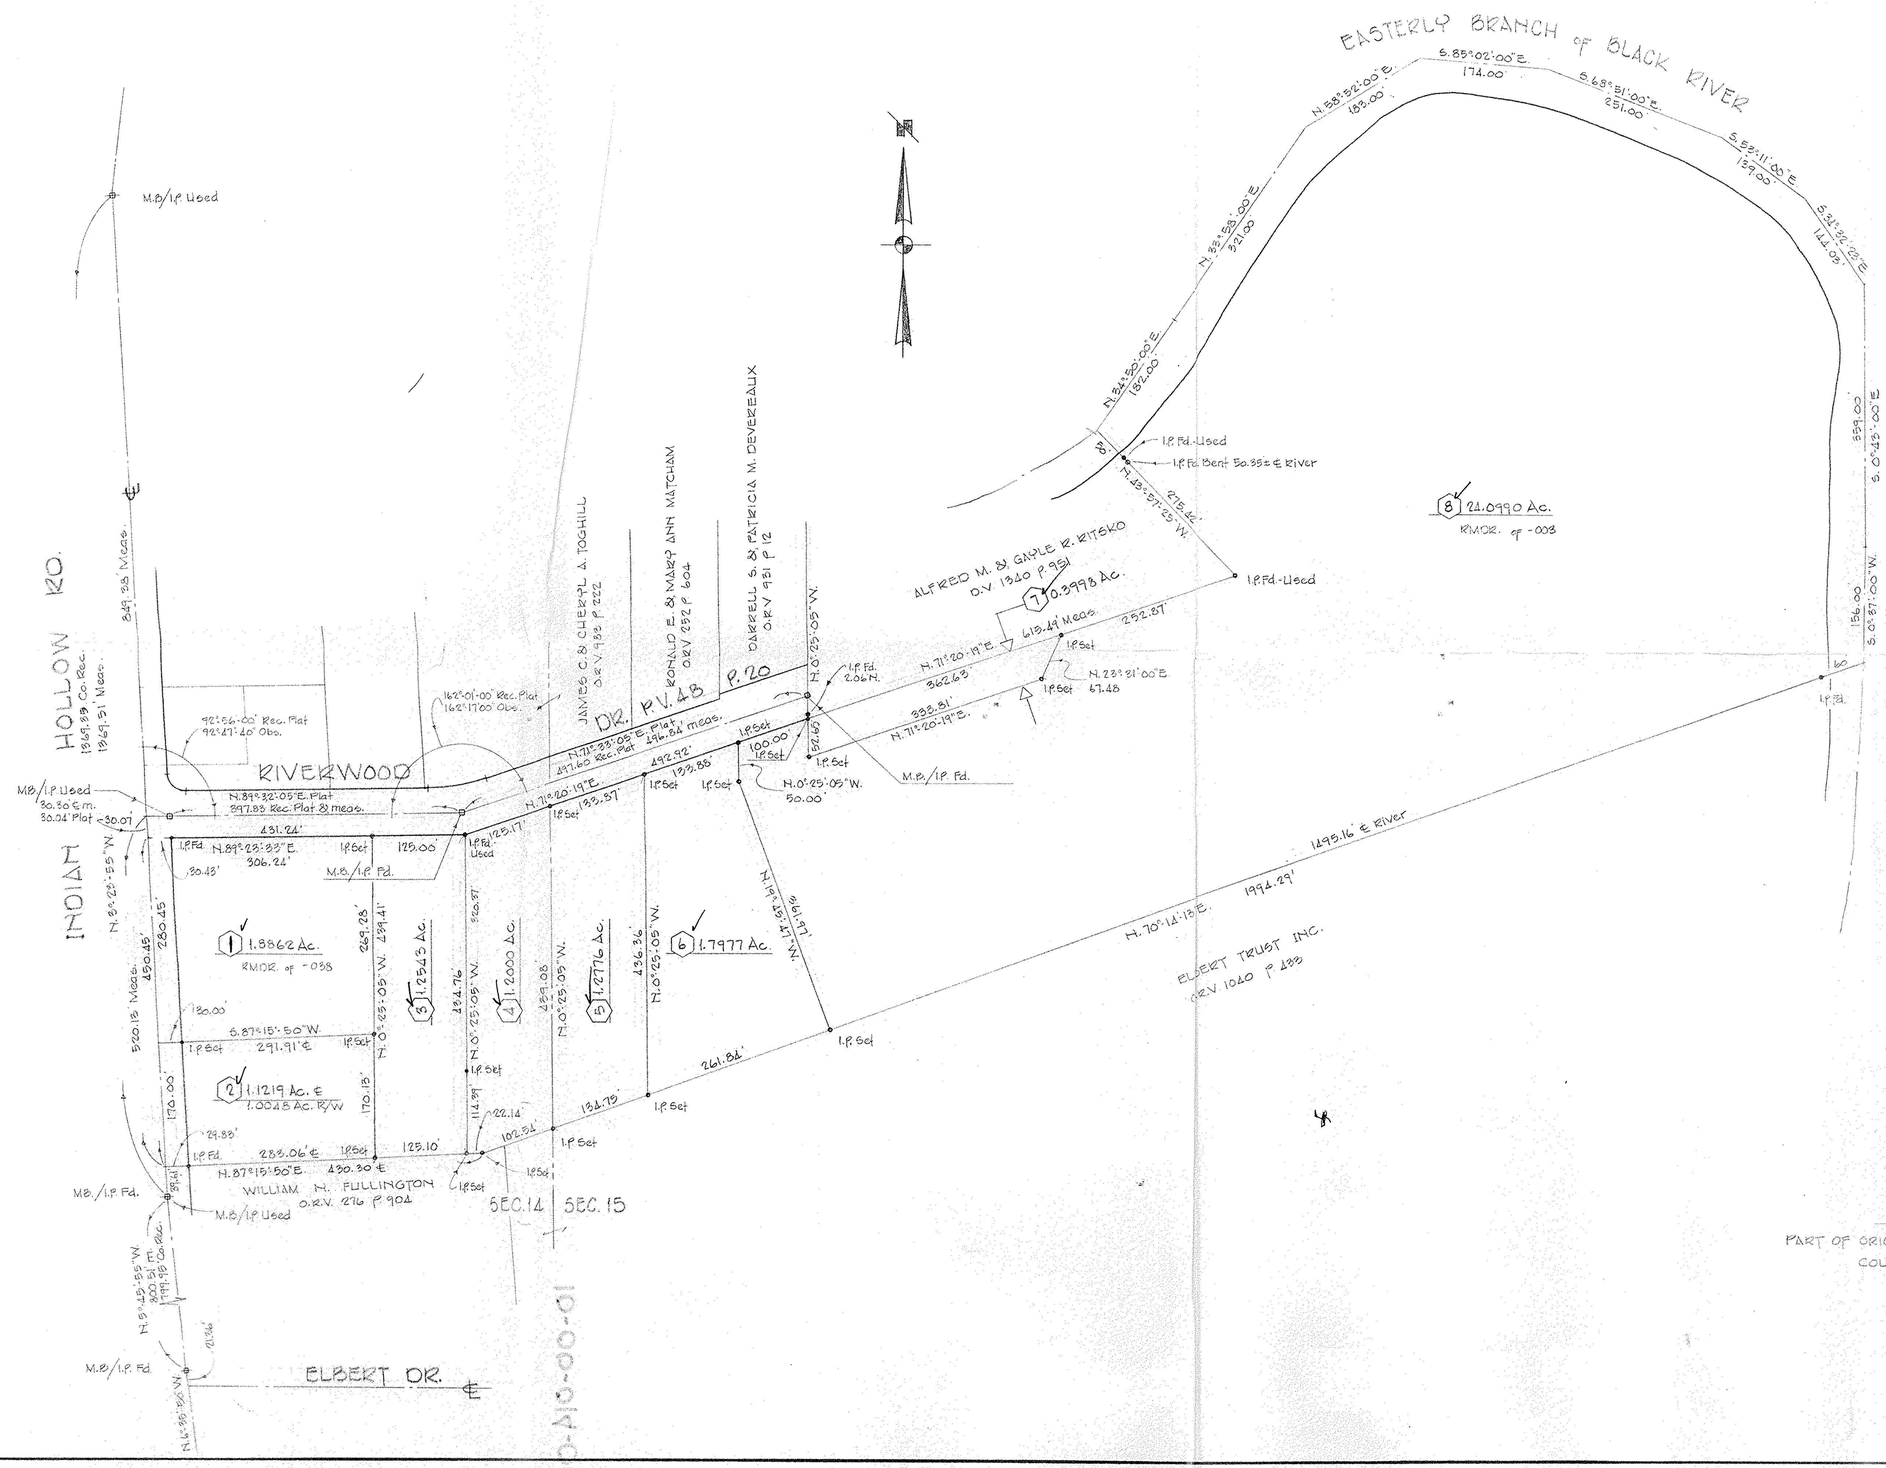

#21826

APPROVED
LORAIN CO.
MAP DEPT.
DATE 7-3-96
PAGE 10-00-010
BY
VOID AFTER 21826

STATE OF OHIO
RODGER G. SIMON
5101
REGISTERED SURVEYOR

SURVEY FOR

WARREN H. BRUCE

PART OF ORIGINAL SECTIONS 14 & 15
COUNTY OF LORAIN
SCALE 1" = 100'

TOWNSHIP OF CARLISLE
STATE OF OHIO
MARCH, 1996

LAUNDON • SIMON • CAHL & ASSOC.
PROFESSIONAL LAND SURVEYORS