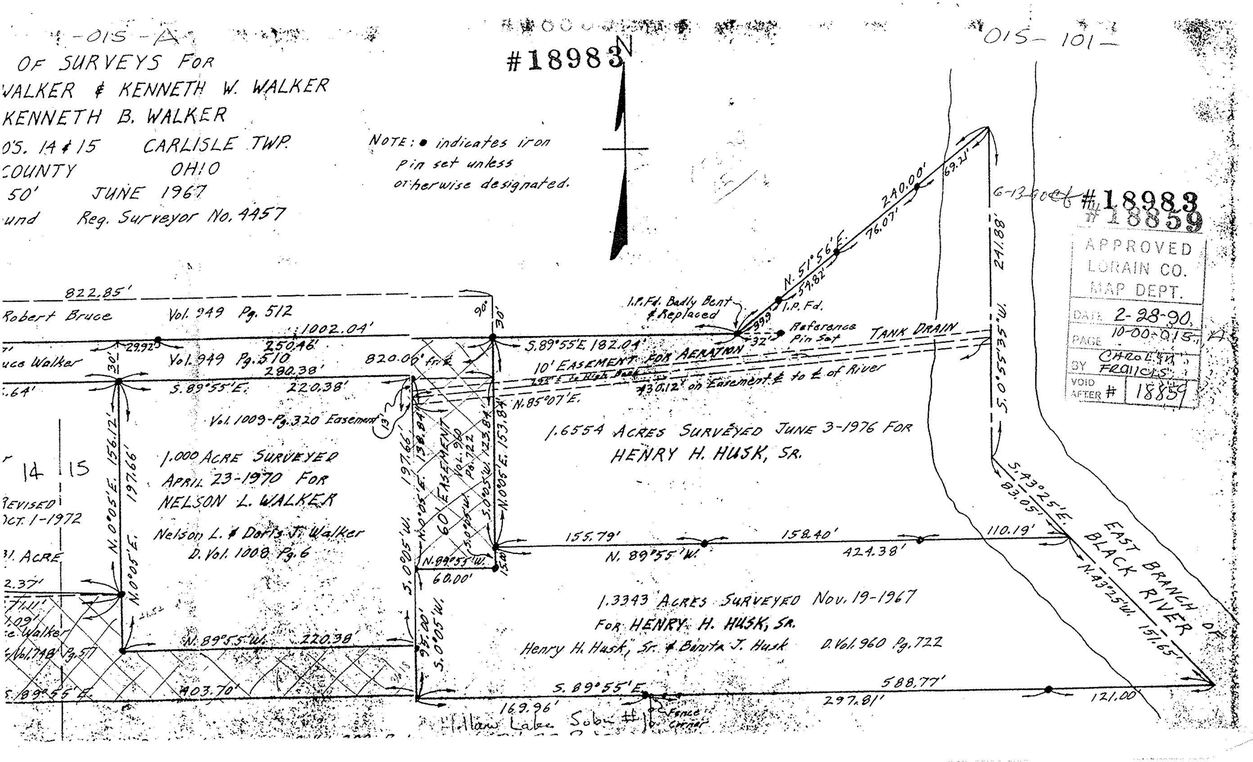
#18983
#18983
#18859
APPROVED
LORAIN CO.
MAP DEPT.
DATE 2-28-90
PAGE 10-00-015-A
BY FRANCIS
VOID AFTER # 18859
NOTE: • indicates iron pin set unless otherwise designated.
822.85'
Robert Bruce
Vol. 949 Pg. 512
1002.04'
250.46'
Vol. 949 Pg. 510
820.06'
280.38'
S. 89°55'E. 220.38'
Vol. 1009-Pg. 320 Easement
1.000 ACRE SURVEYED APRIL 23-1970 FOR NELSON L. WALKER
Nelson L. & Doris J. Walker D. Vol. 1008 Pg. 6
N. 0°05'E. 156.12'
197.66'
S. 0°05'W. 197.66'
14
15
REVISED OCT. 1-1972
1.000 ACRE
2.37'
N. 89°55'W. 220.38'
403.70'
S. 89°55'E.
169.96'
Hillcrest Lakes Subd. #1
Fence Corner
I.P.Fd. Badly Bent & Replaced
I.P.Fd.
Reference Pin Set
TANK DRAIN
10' EASEMENT FOR AERATION
N. 51°56'E. 240.00'
76.07'
69.24'
S. 0°05'35"W. 241.88'
S. 43°25'E. 83.05'
N. 43°25'W. 197.65'
EAST BRANCH OF BLACK RIVER
S. 88°08'W. 153.84'
N. 1°52'W. 123.84'
N. 85°07'E.
60' EASEMENT Vol. 960 Pg. 722
N. 89°55'W. 155.79'
158.40'
424.38'
110.19'
N. 89°55'W. 60.00'
1.6554 ACRES SURVEYED JUNE 3-1976 FOR HENRY H. HUSK, SR.
1.3343 ACRES SURVEYED Nov. 19-1967 FOR HENRY H. HUSK, SR.
Henry H. Husk, Sr. & Bonita J. Husk D. Vol. 960 Pg. 722
S. 89°55'E. 588.77'
297.81'
121.00
Fence Corner

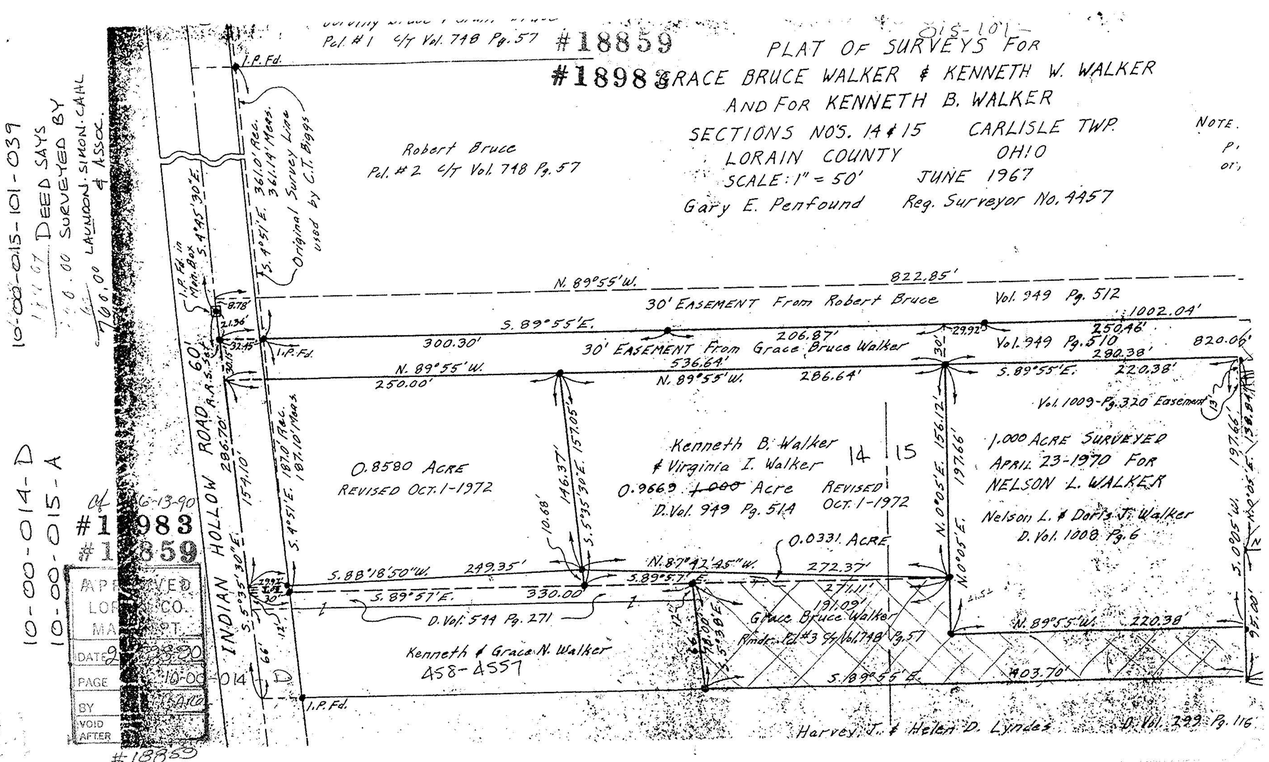
#18859
#18983
#18859
APPROVED
LORAIN CO.
MAP DEPT.
DATE 2-28-90
PAGE 10-00-015-A
BY FRANCIS
VOID AFTER
10-00-014-D
10-00-015-A
10-00-015-101-039
1.74 Ac. DEED SAYS
1.00 SURVEYED BY
LAWSON, SIMON, CAHL & ASSOC.
INDIAN HOLLOW ROAD
60'
I.P.Fd.
I.P.Fd. in Manhole
S. 4°45'30"E.
Original Survey Line used by C.T. Biggs
Robert Bruce
Pcl. #2 4/t Vol. 718 Pg. 57
Pcl. #1 4/t Vol. 718 Pg. 57
#18859
PLAT OF SURVEYS FOR
#18983 GRACE BRUCE WALKER & KENNETH W. WALKER
AND FOR KENNETH B. WALKER
SECTIONS NOS. 14 & 15 CARLISLE TWP.
LORAIN COUNTY OHIO
SCALE: 1" = 50' JUNE 1967
Gary E. Penfound Reg. Surveyor No. 4457
N. 89°55'W. 822.85'
30' EASEMENT From Robert Bruce Vol. 949 Pg. 512
1002.04'
S. 89°55'E.
30' EASEMENT From Grace Bruce Walker
206.87'
536.64'
Vol. 949 Pg. 510
250.46'
820.06'
300.30'
N. 89°55'W. 250.00'
N. 89°55'W. 286.64'
280.38'
S. 89°55'E. 220.38'
Vol. 1009-Pg. 320 Easement
0.8580 ACRE REVISED OCT. 1-1972
Kenneth B. Walker & Virginia I. Walker
0.9669 ~~1.000~~ Acre REVISED
D. Vol. 949 Pg. 514 OCT. 1-1972
1.000 ACRE SURVEYED APRIL 23-1970 FOR NELSON L. WALKER
Nelson L. & Doris J. Walker D. Vol. 1008 Pg. 6
14
15
N. 0°05'E. 156.12'
197.66'
S. 0°05'W. 197.66'
S. 4°51'E. 180.70' Meas. 181.10' Meas.
S. 5°35'30"E. 157.05'
N. 4°51'W. 286.70'
154.10'
146.37'
10.68'
0.0331 ACRE
S. 88°18'50"W. 299.35'
N. 87°42'45"W. 272.37'
S. 89°55'E. 330.00'
D. Vol. 511 Pg. 271
Kenneth & Grace N. Walker 458-4557
Grace Bruce Walker Rmdr. of 43 A/t Vol. 718 Pg. 57
131.03'
N. 89°55'W. 220.38'
403.70'
S. 89°55'E.
I.P.Fd.
Harvey T. & Helen D. Lynds D. Vol. 299 Pg. 116