


LORAIN CO. MAP DEPT.	
DATE	7/1/77
PAGE	14-00-C14D
BY	L.W. Hall
VOID AFTER	

Pt - 036
Pt 6.00 A.

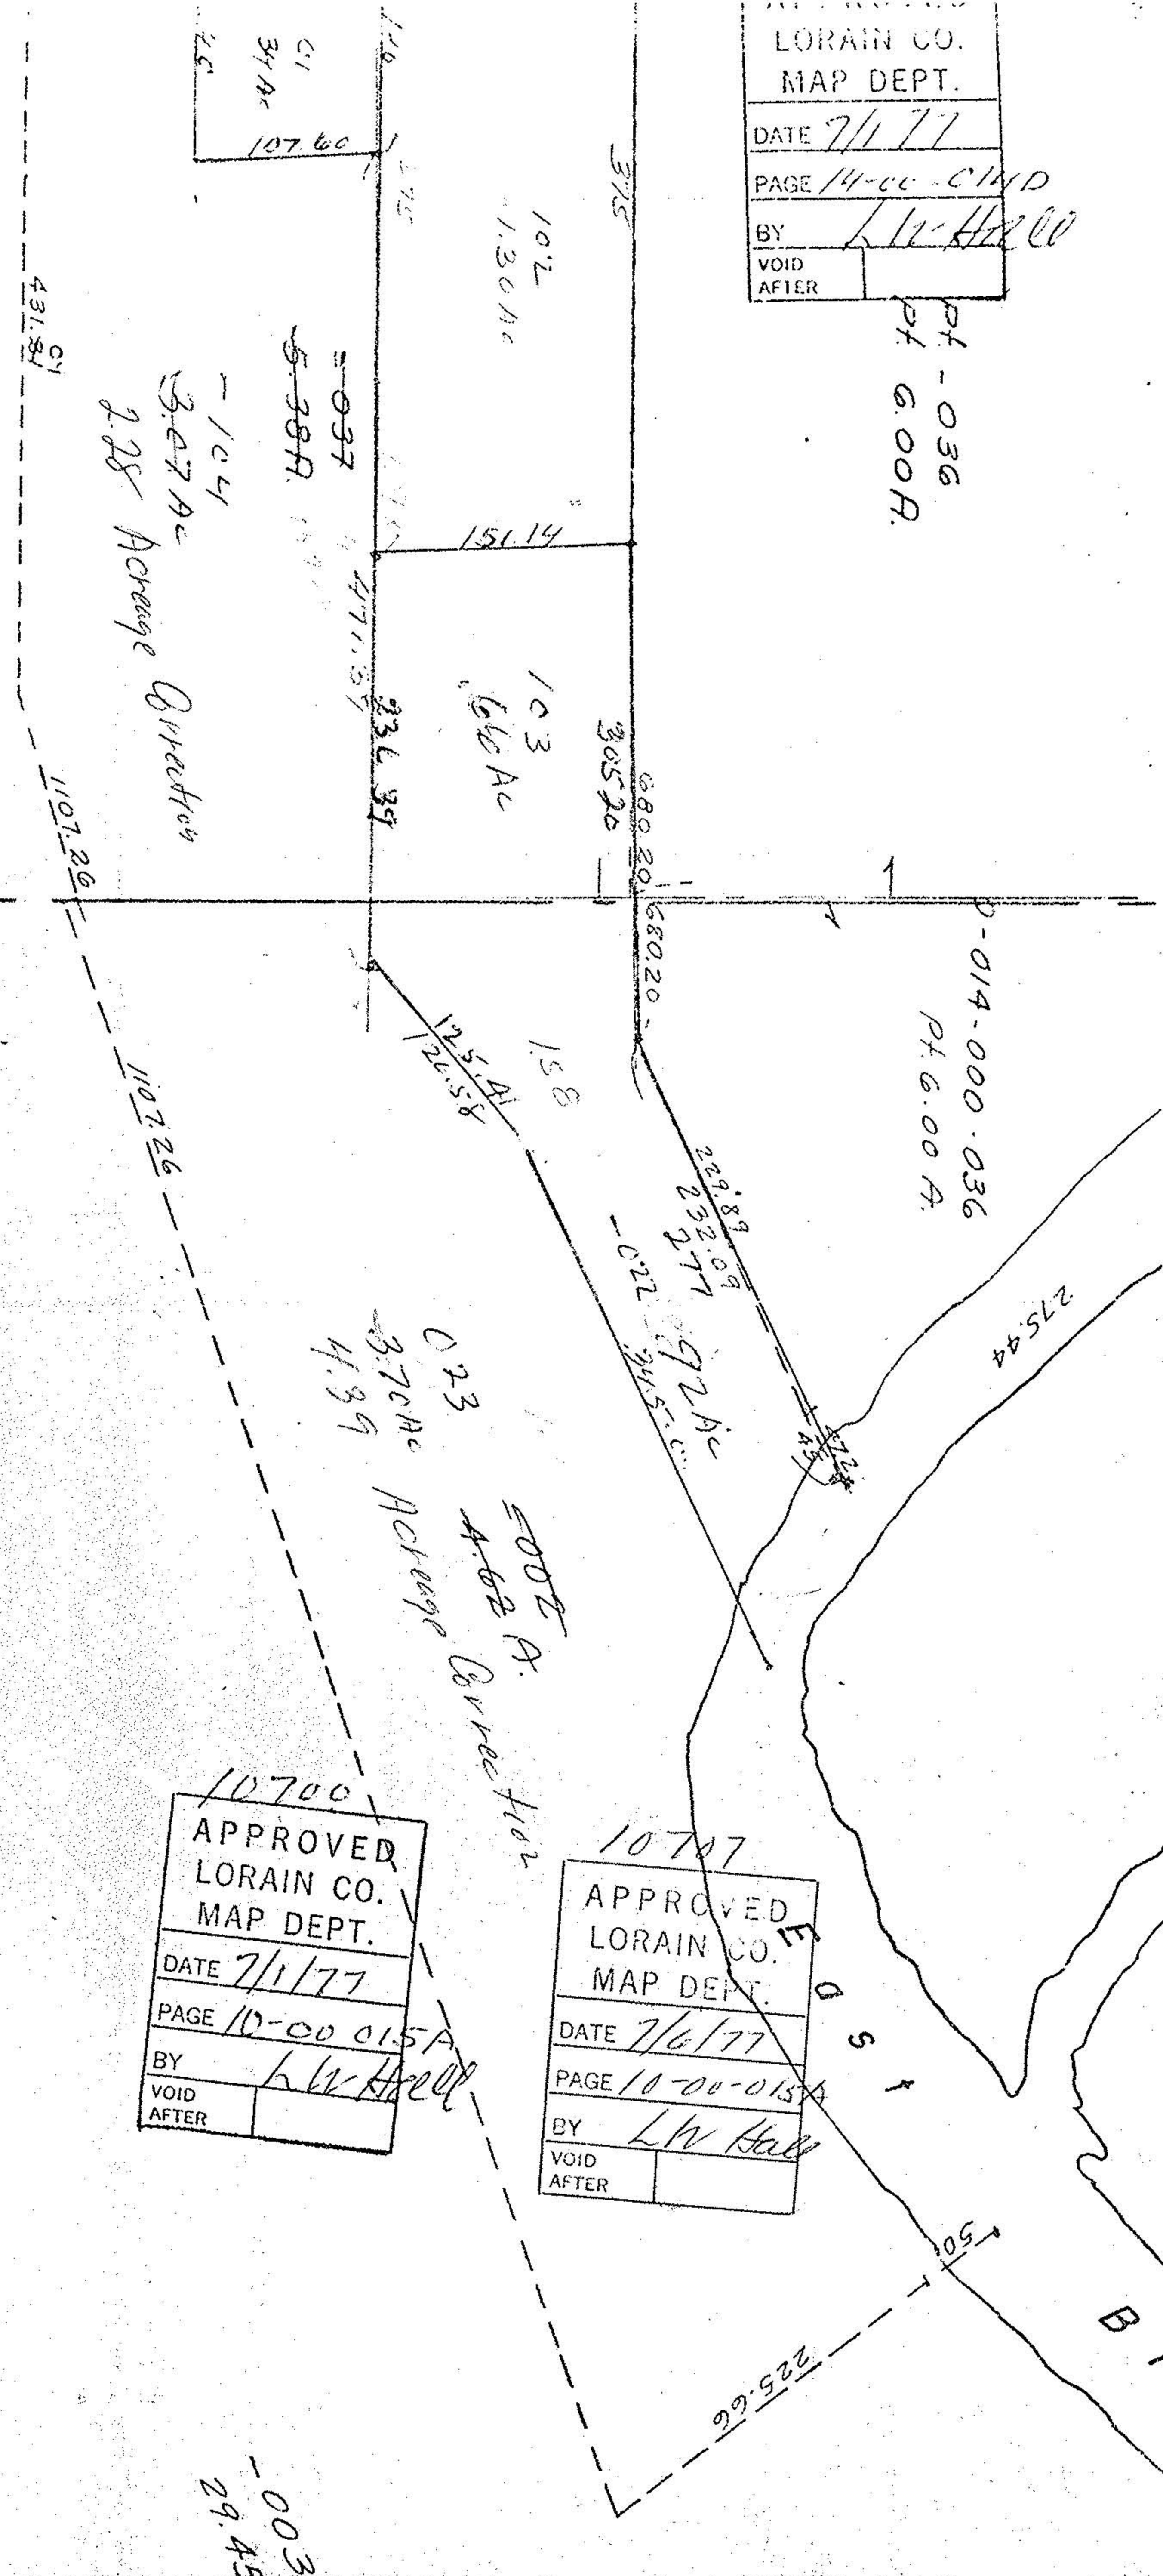



LORAIN CO. MAP DEPT.	
DATE	7/6/77
PAGE	10-00-015A
BY	L.W. Hall
VOID AFTER	


LORAIN CO. MAP DEPT.	
DATE	7/1/77
PAGE	10-00-015A
BY	L.W. Hall
VOID AFTER	

-003
29.45

LORAIN CO. MAP DEPT.	
DATE	7/1/77
PAGE	10-00-C14D
BY	L.W. Hall
VOID AFTER	

Pt - 036
Pt 6.00 A.

LORAIN CO. MAP DEPT.	
DATE	7/6/77
PAGE	14-00-014D
BY	L.W. Hall
VOID AFTER	

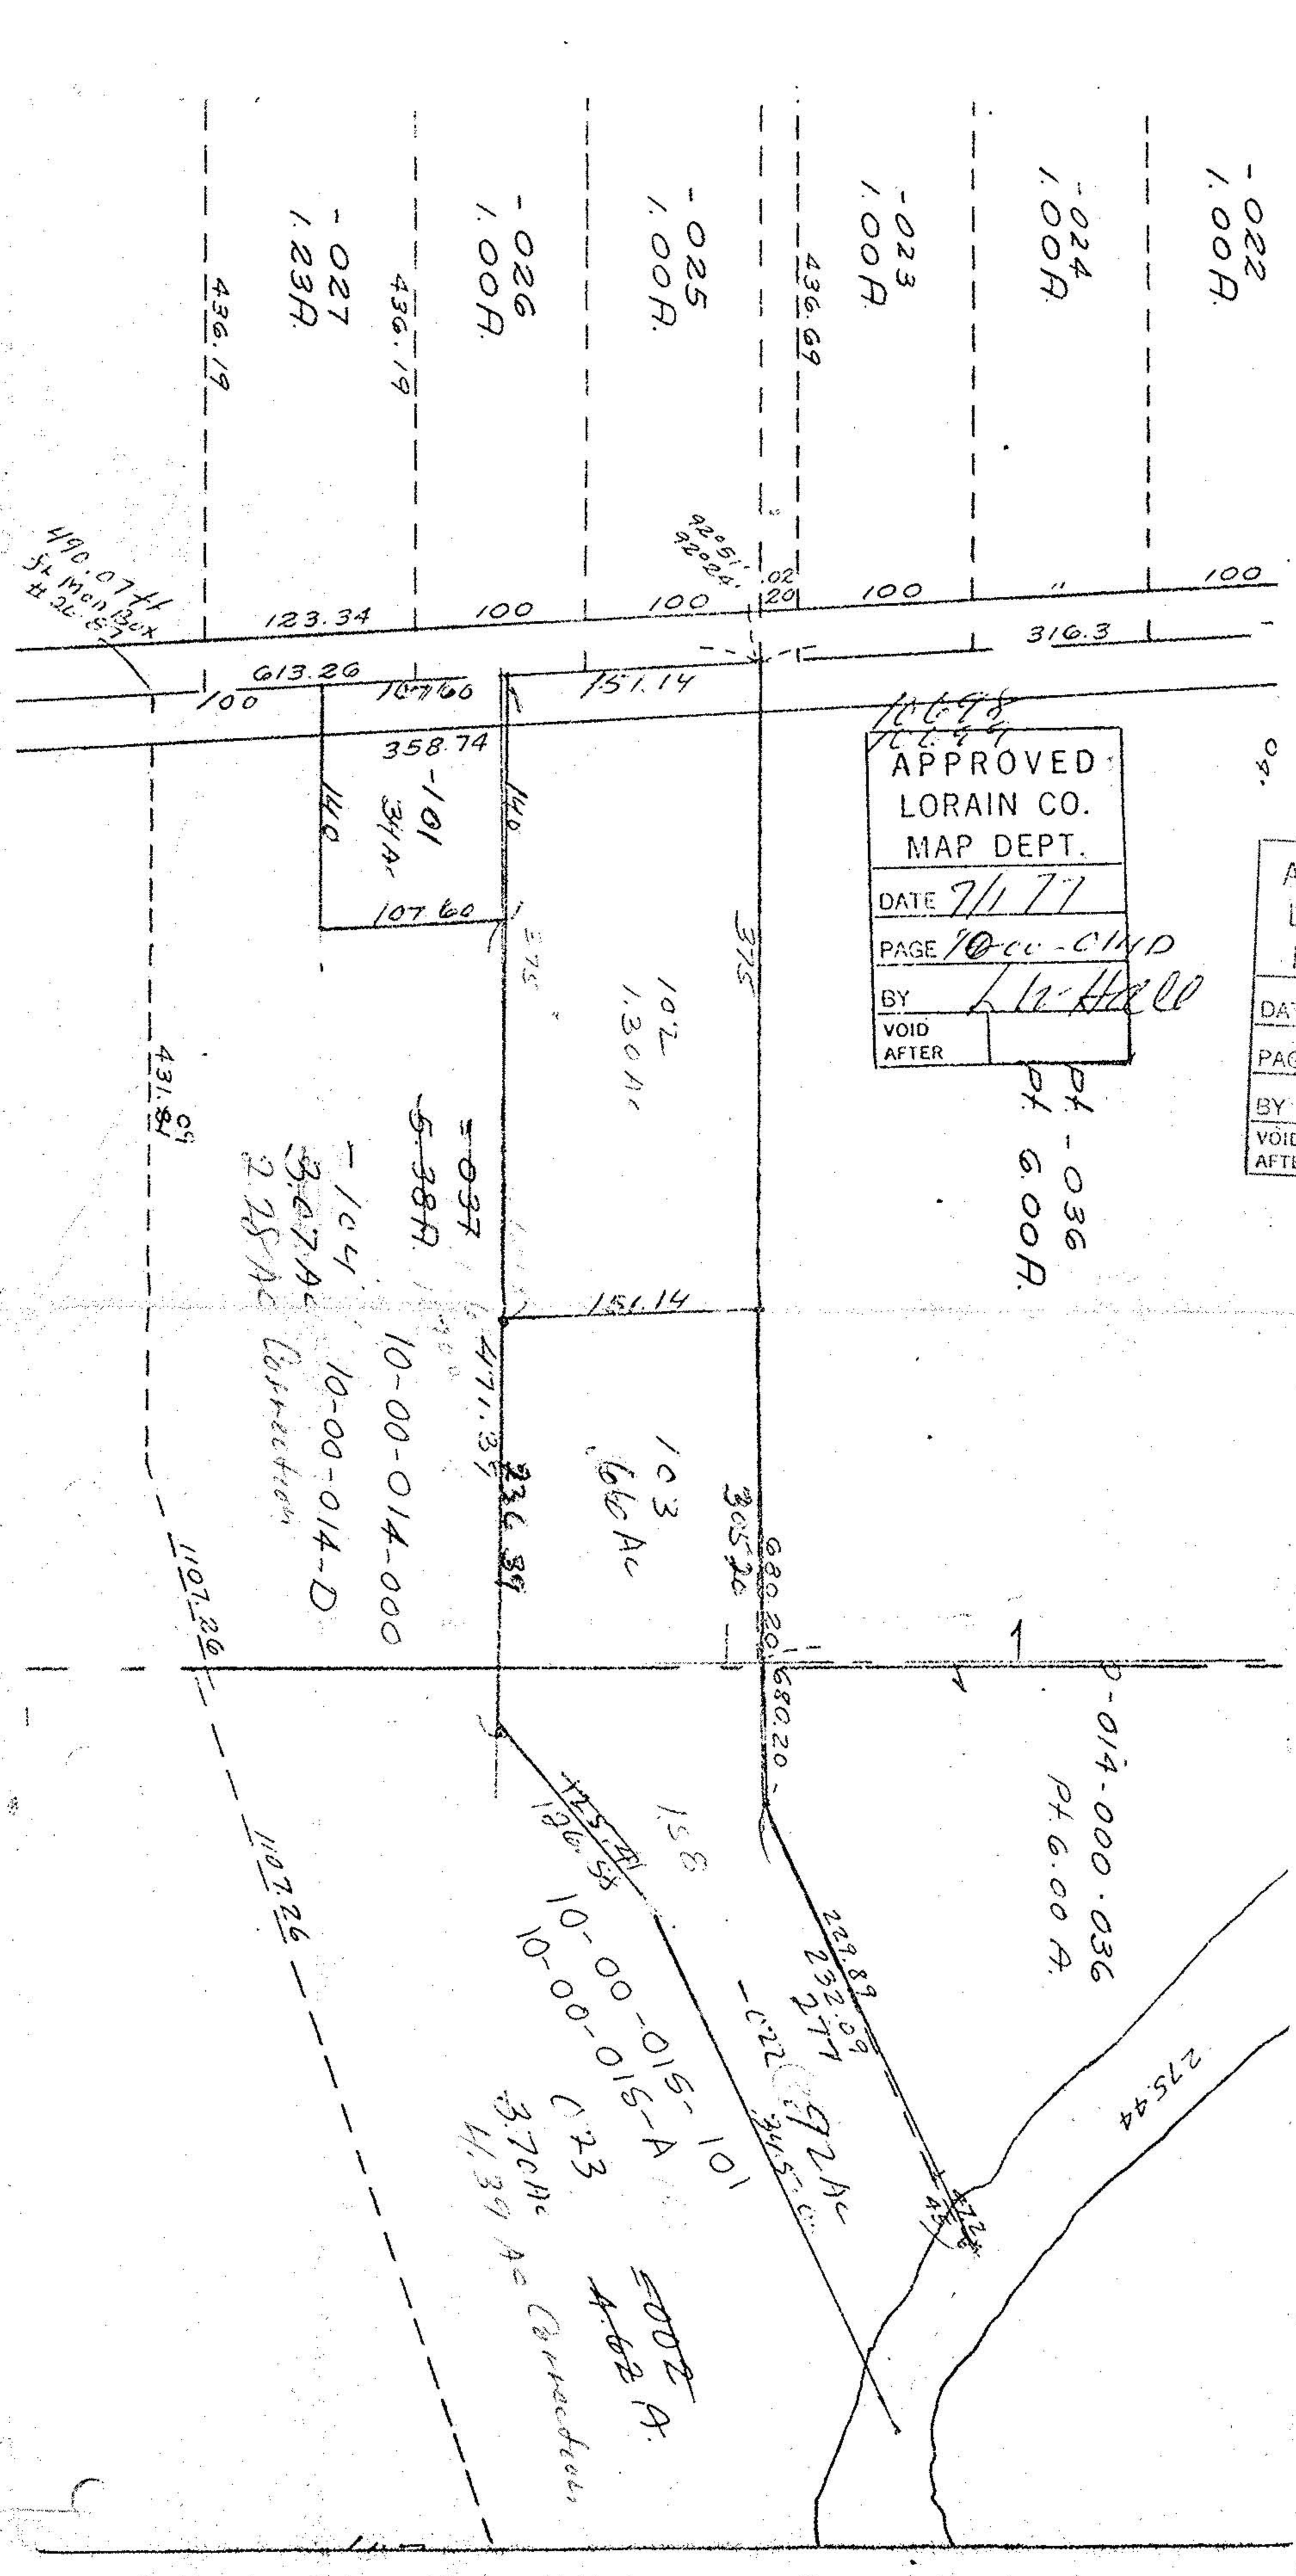

LORAIN CO. MAP DEPT.	
DATE	7/1/77
PAGE	10-00-C14D
BY	L.W. Hall
VOID AFTER	

Pt - 036
Pt 6.00 A.

LORAIN CO. MAP DEPT.	
DATE	7/6/77
PAGE	14-00-014D
BY	L.W. Hall
VOID AFTER	

