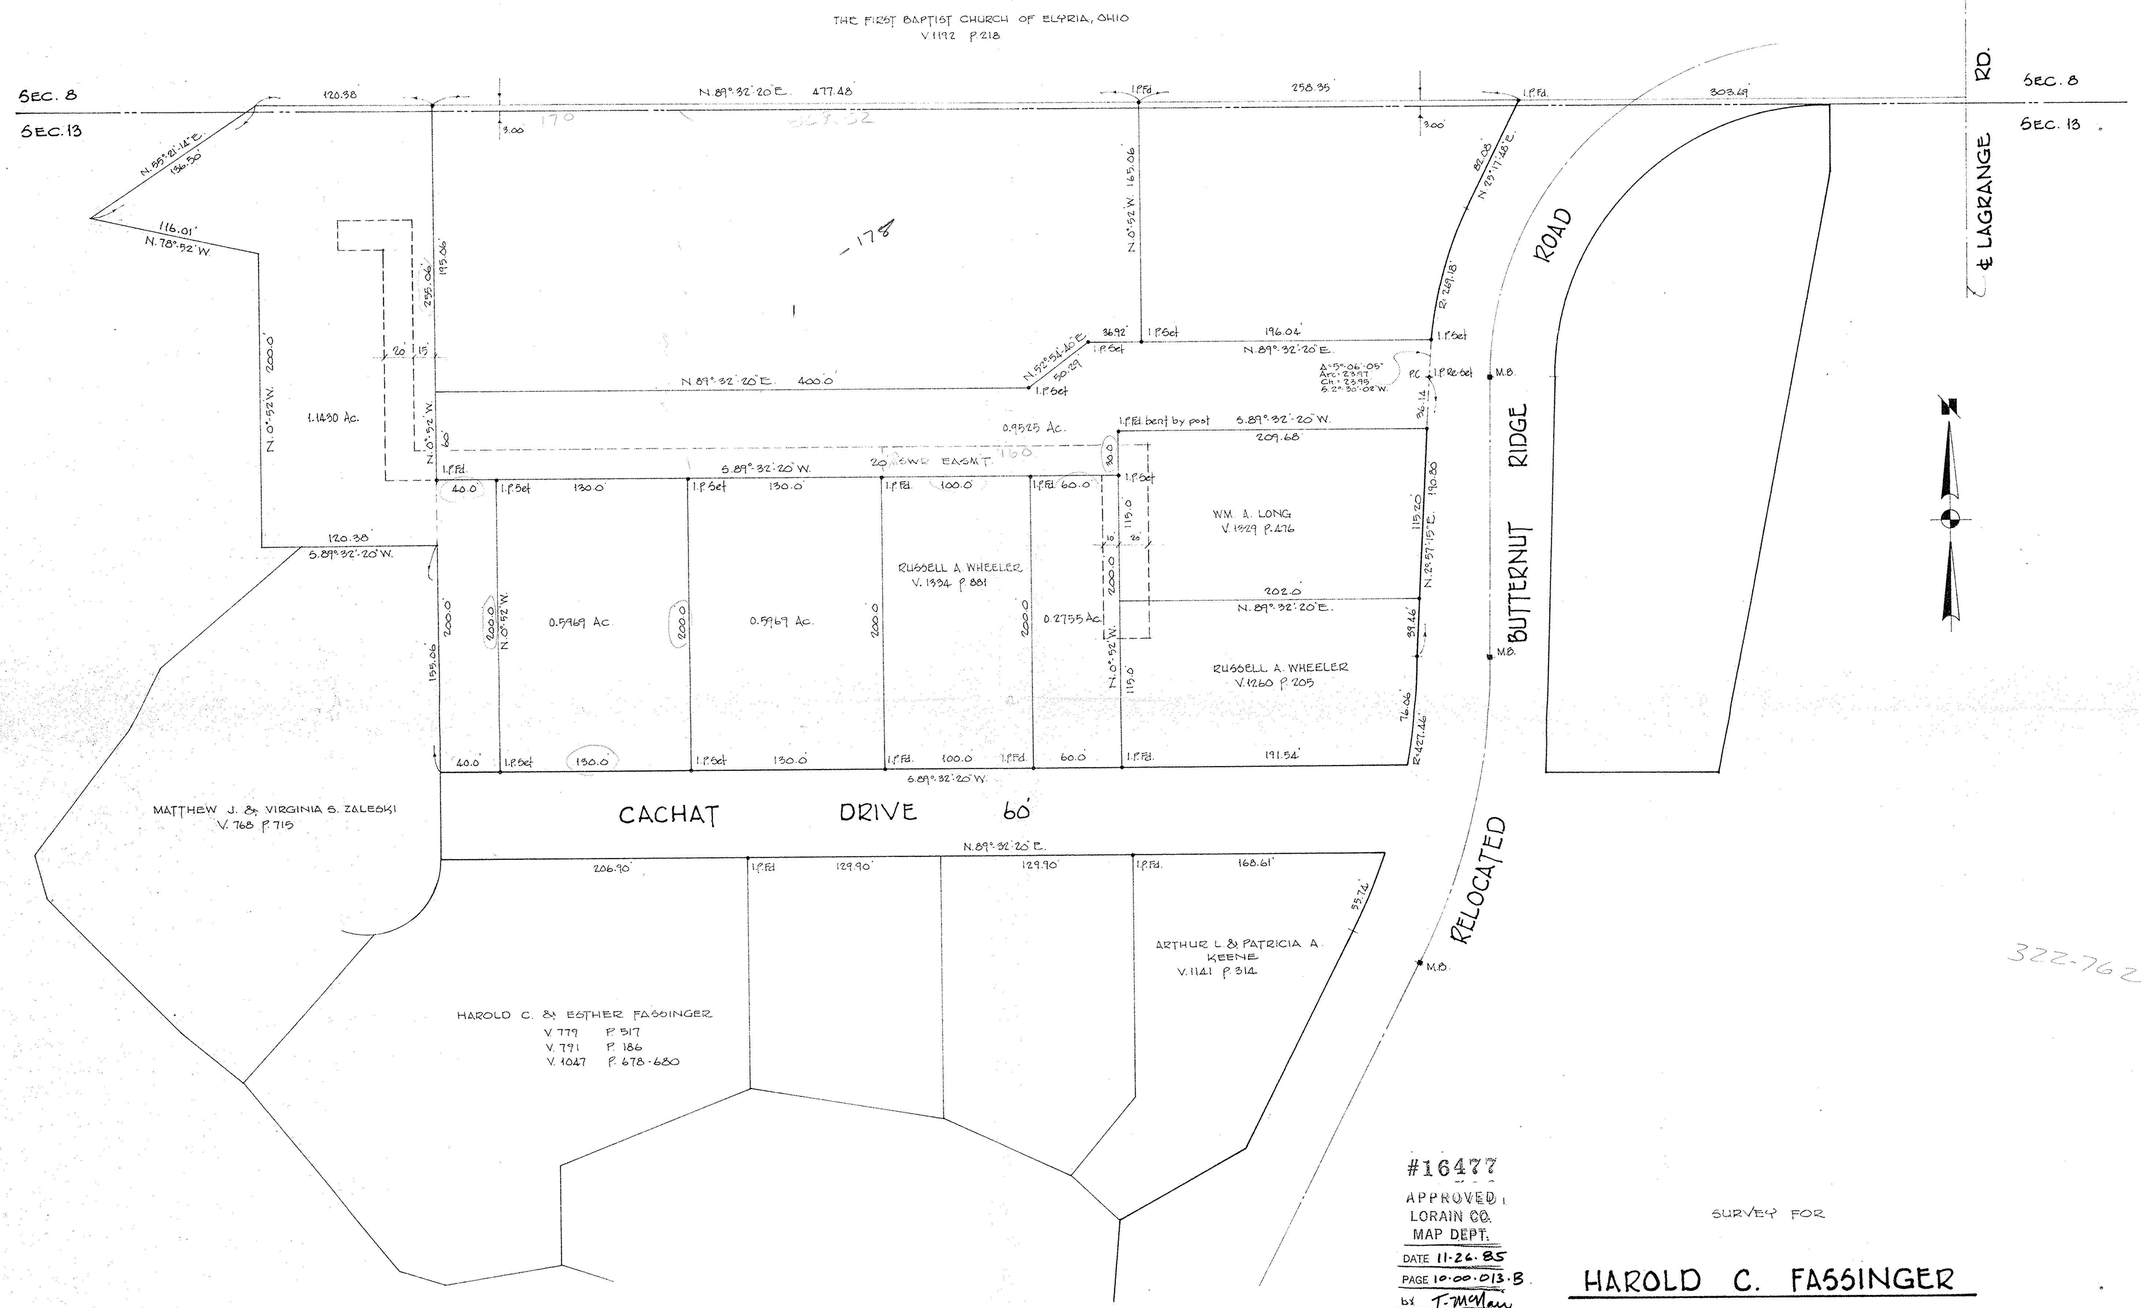

#16477
APPROVED
LORAIN CO.
MAP DEPT.
DATE 11-26-85
PAGE 10-00-013-B
BY T. McMan

SURVEY FOR

HAROLD C. FASSINGER

PART OF ORIG. SEC'S. 8 & 13 CARLISLE TOWNSHIP
LORAIN COUNTY OHIO

SCALE 1"=50 OCT. 1985

LAUNDON • SIMON • CAHL & ASSOC.
ENGINEERS SURVEYORS

Job No. 85-1425