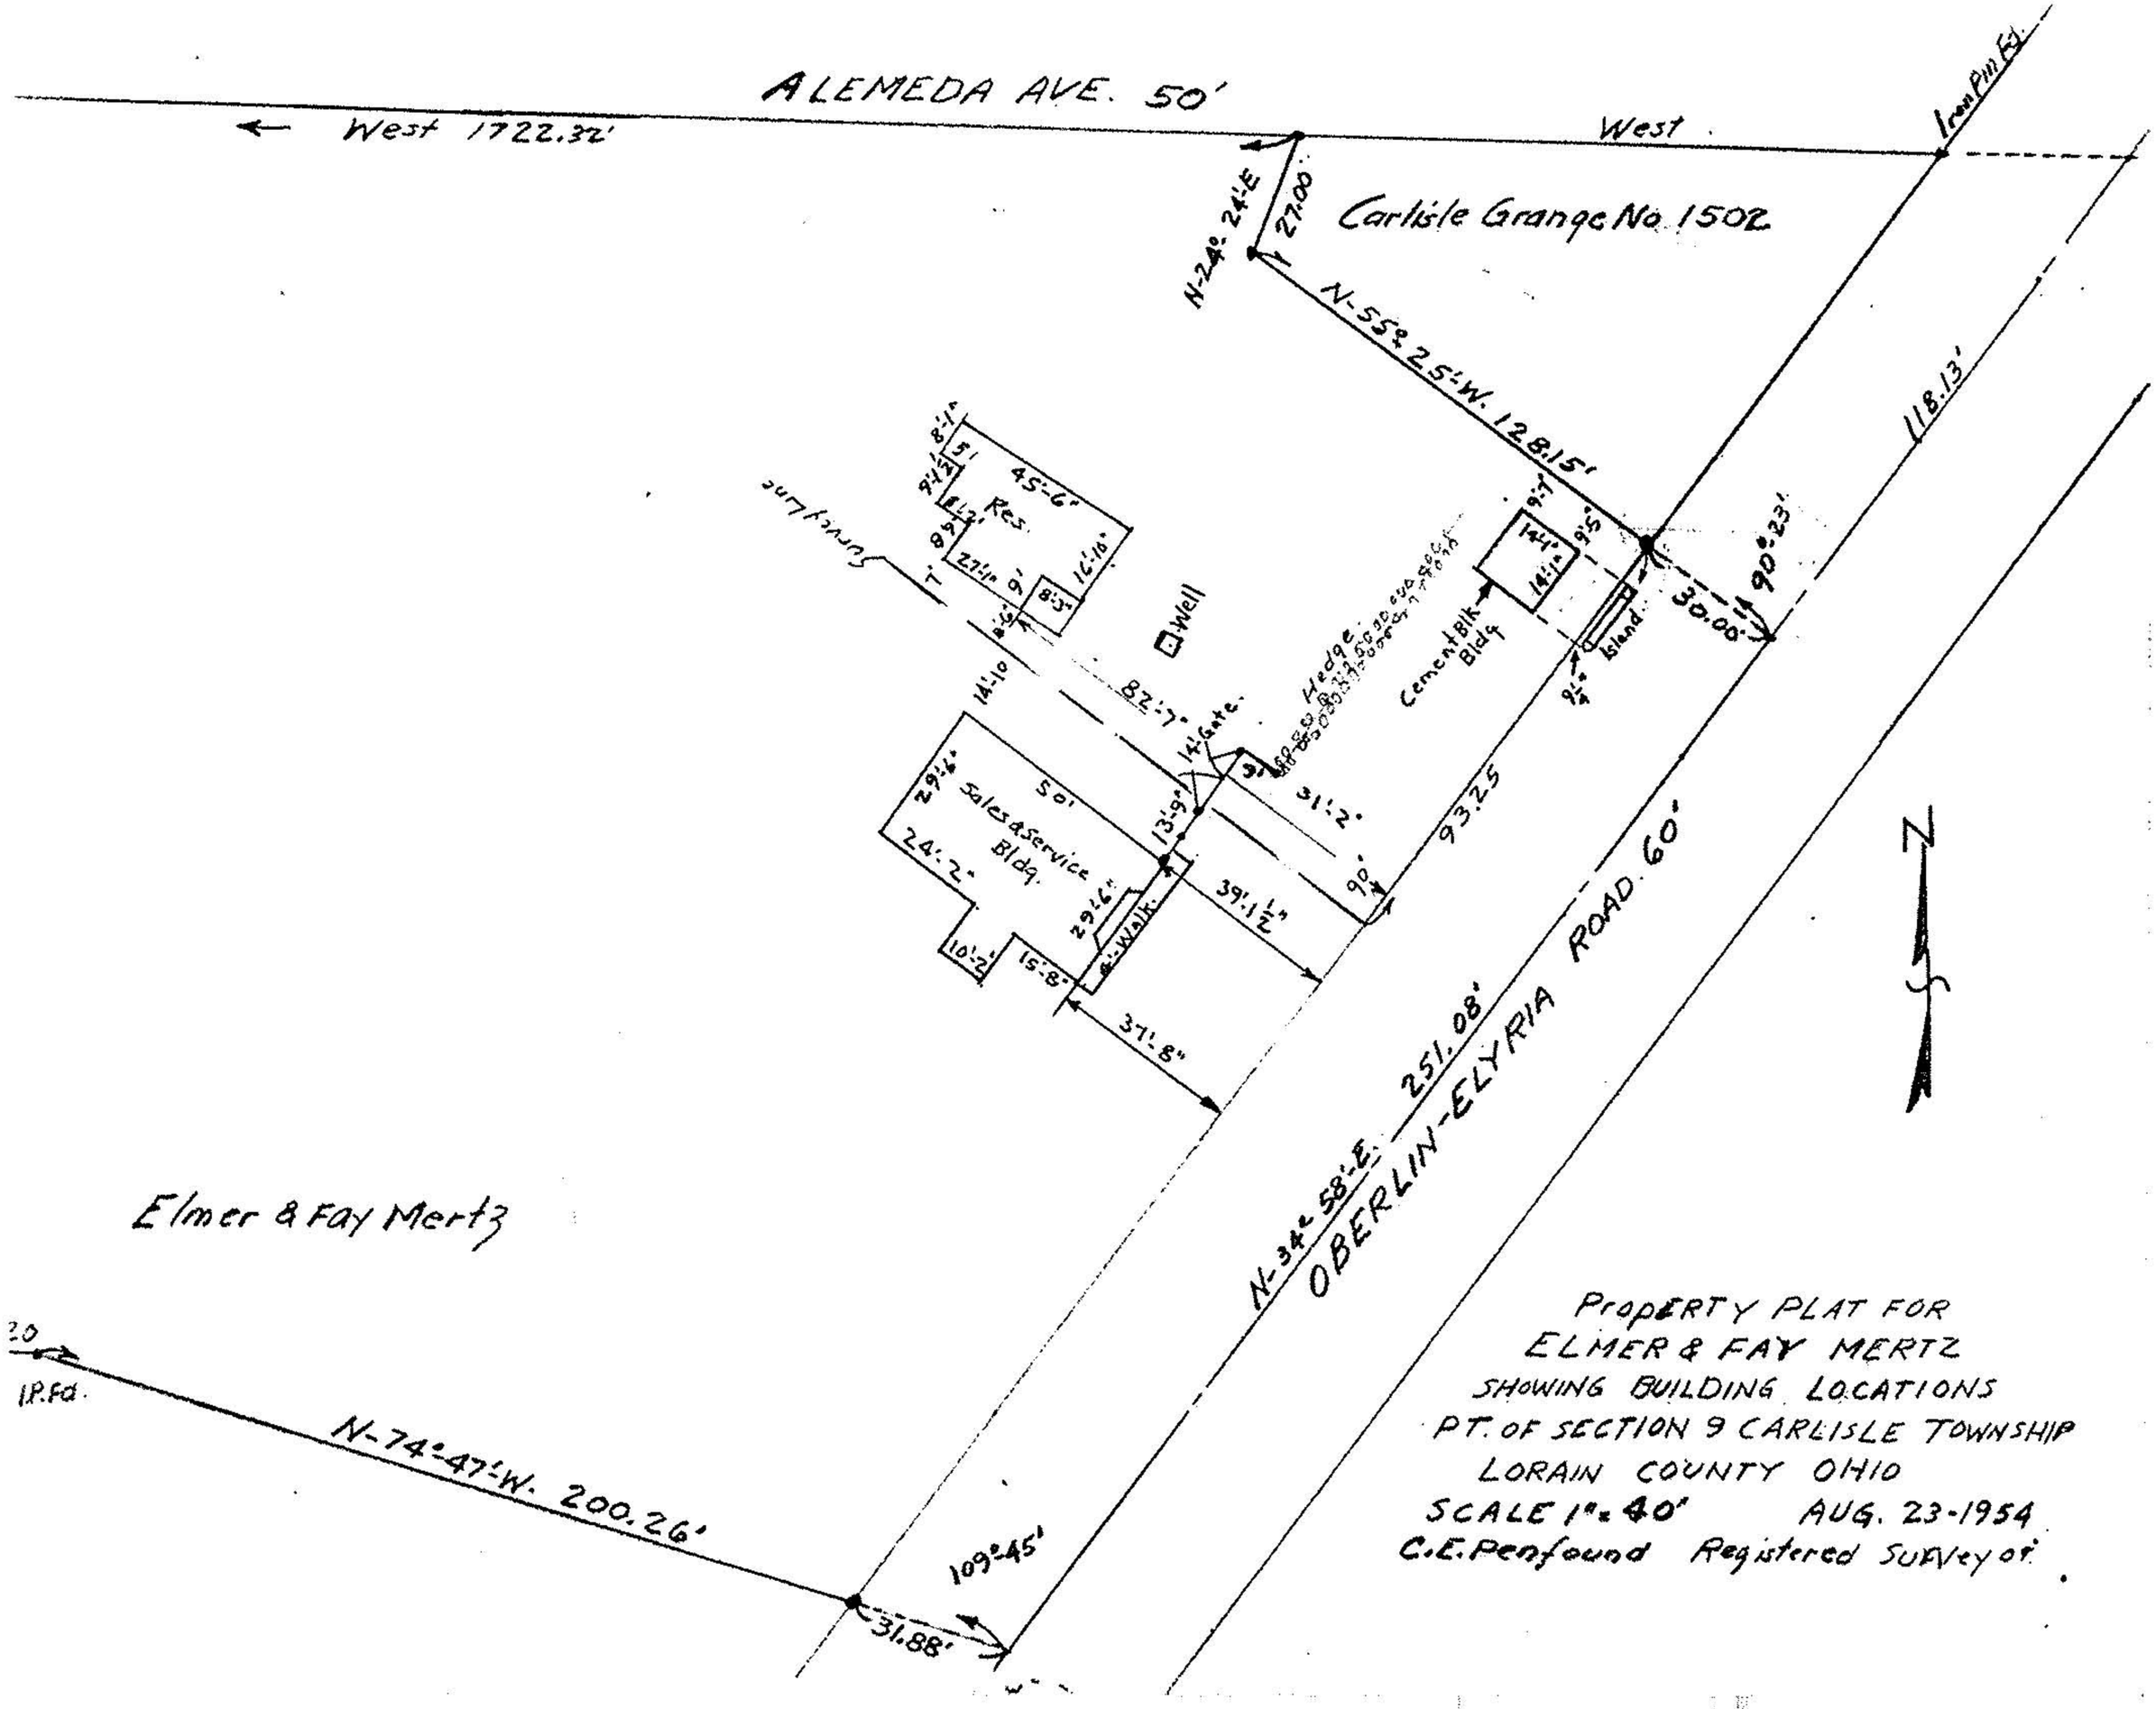

PROPERTY PLAT FOR
ELMER & FAY MERTZ
SHOWING BUILDING LOCATIONS
PT. OF SECTION 9 CARLISLE TOWNSHIP
LORAIN COUNTY OHIO
SCALE 1" = 40' AUG. 23-1954
C.E. Penfound Registered Surveyor