
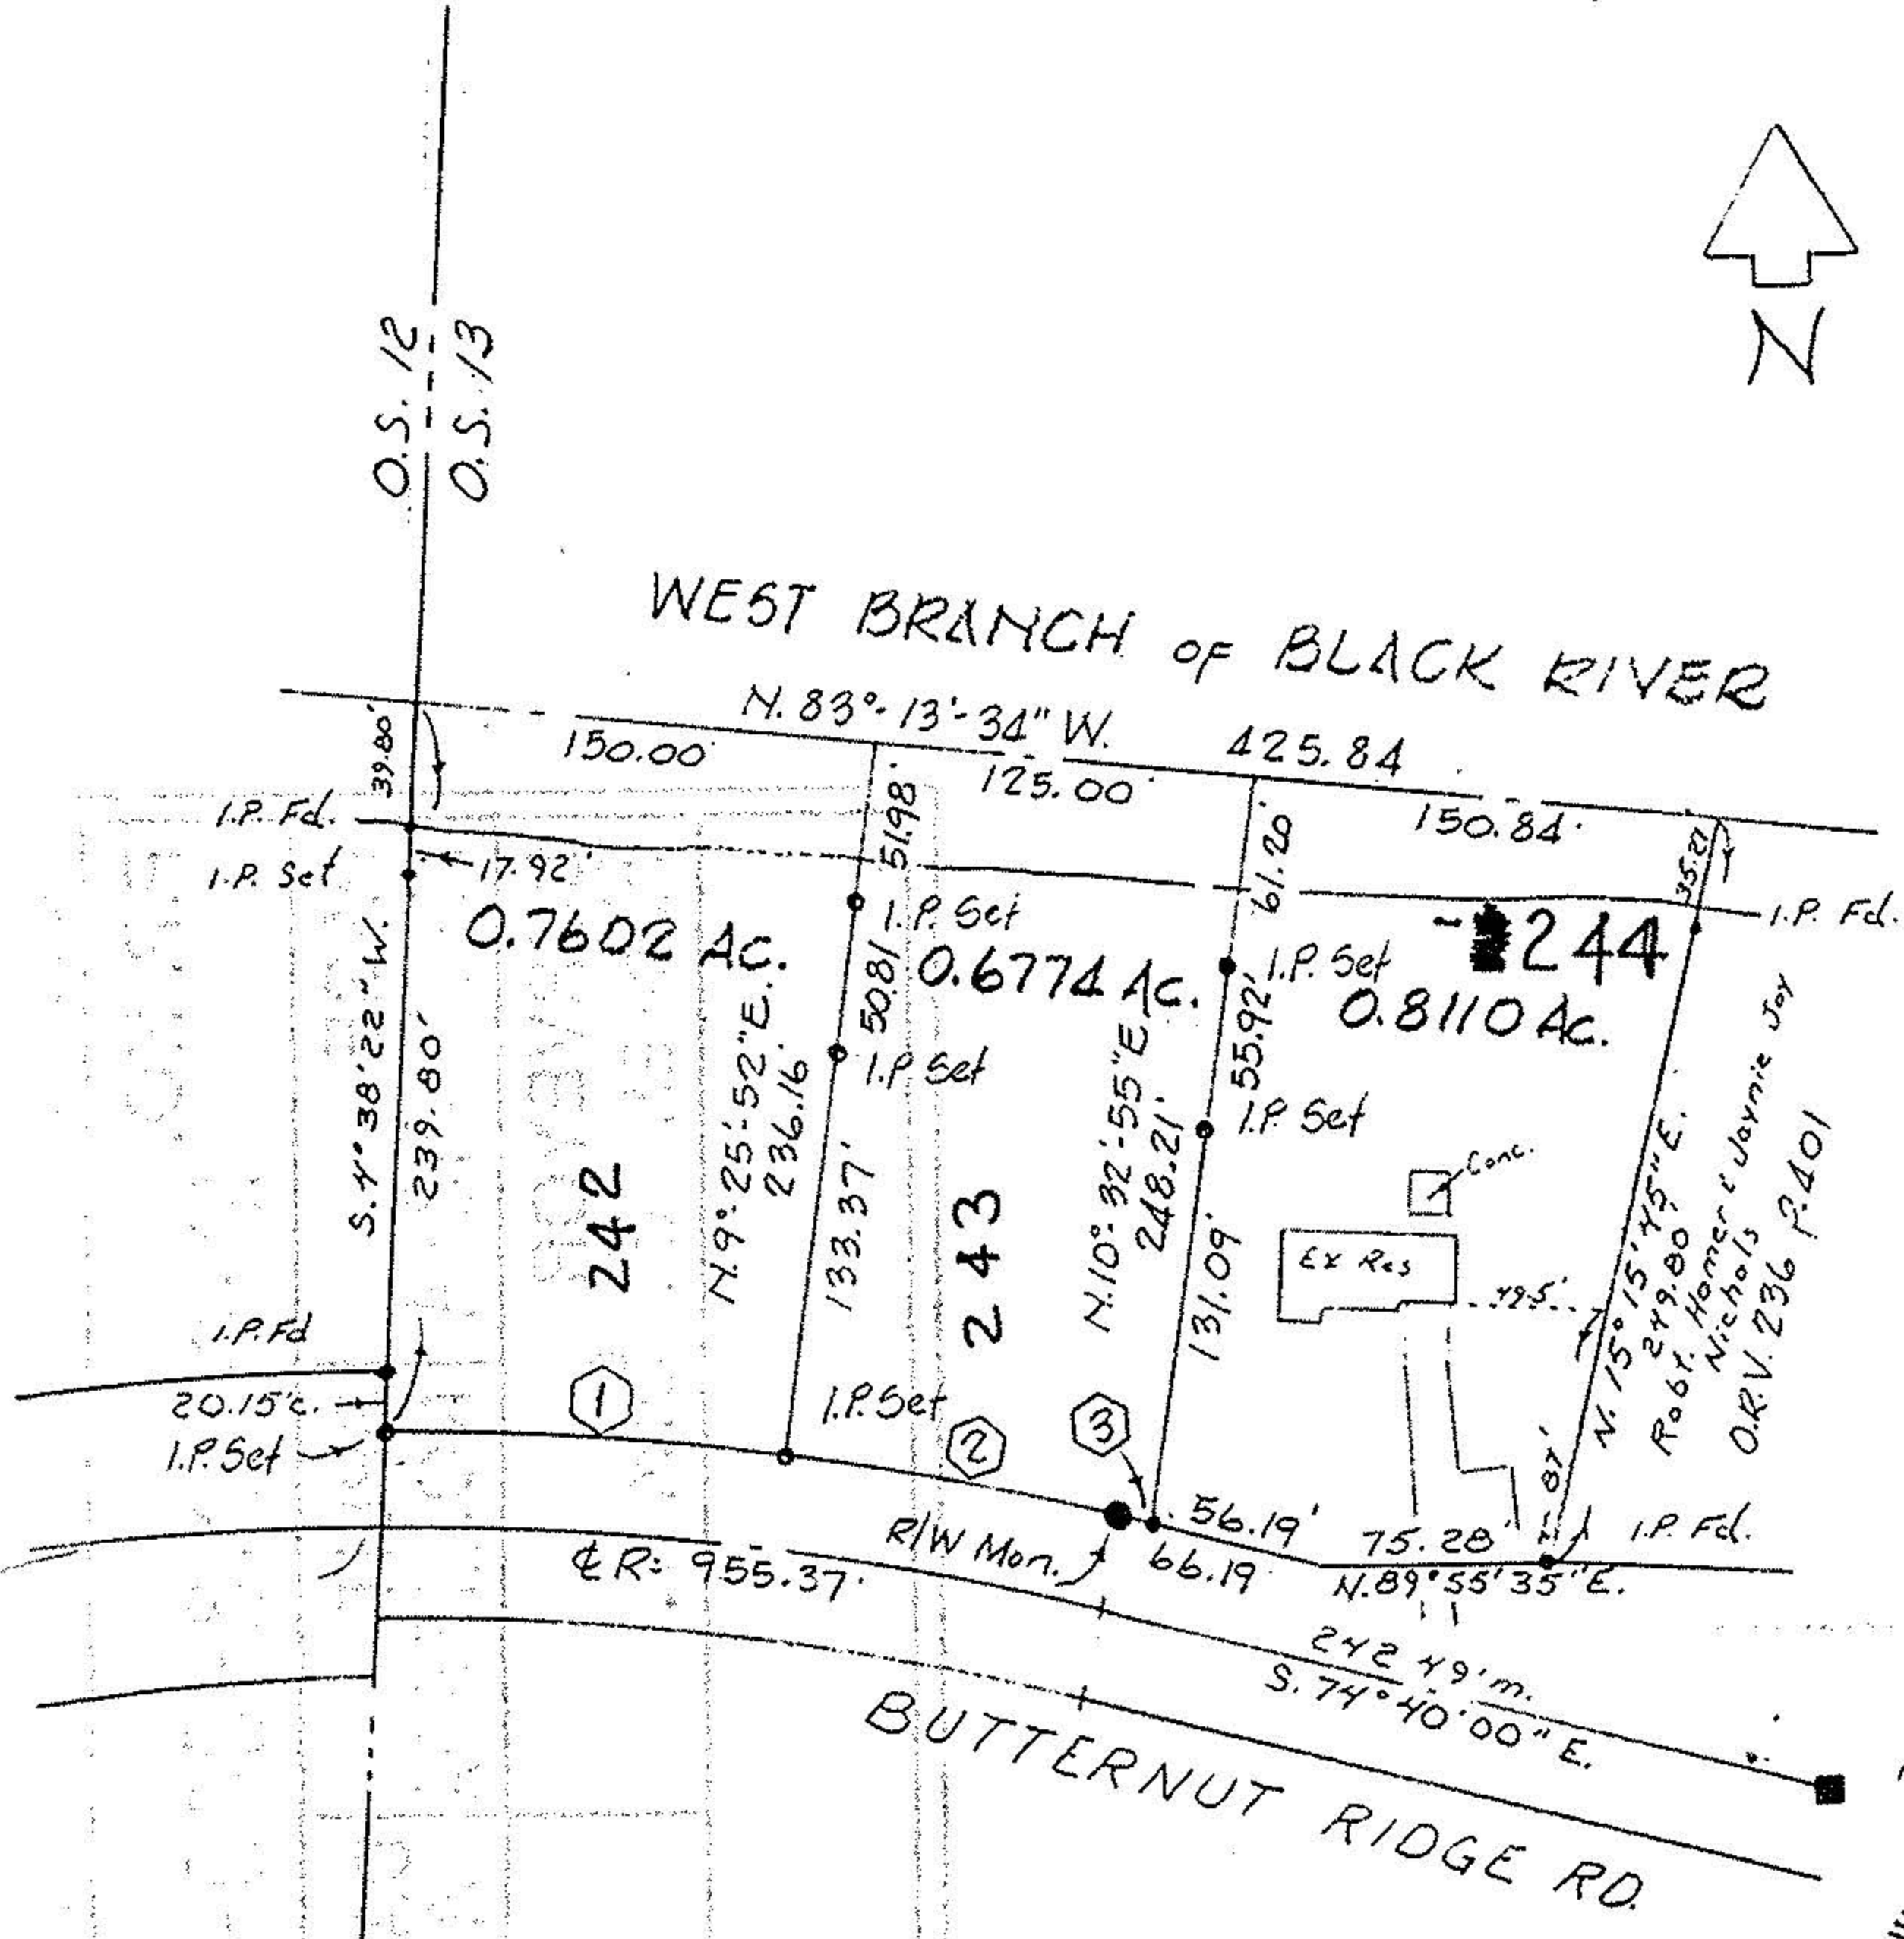


Carole Patyak

g. Lot	City of	Date Apr. 1 1995	Scale 1" = 100'
g. Sec 13	Village of	Dwn. by RC	Chkd. by RS
ct	County of Lorain	Job No. 95-2707	F.B. 235 P.19
inship of Carlisle	State of Ohio	Printed	

REV. 8/9/95 - LOT SPLITS

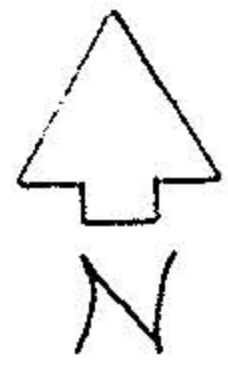

21557-A

APPROVED LORAIN CO. MAP DEPT
DATE 10-31-95
PAGE 10-00-013-A
BY CAROLYN FRANCIS
#21557-A

- ① R=985.37 Δ=7°34'27" L=130.26 Ch=130.17 5.84°52'03"E.
- ② R=985.37 Δ=6°24'40" L=110.26 Ch=110.20 5.77°52'20"E
- ③ 5.74°40'00"E. 10.00'

10-00-013-000-

