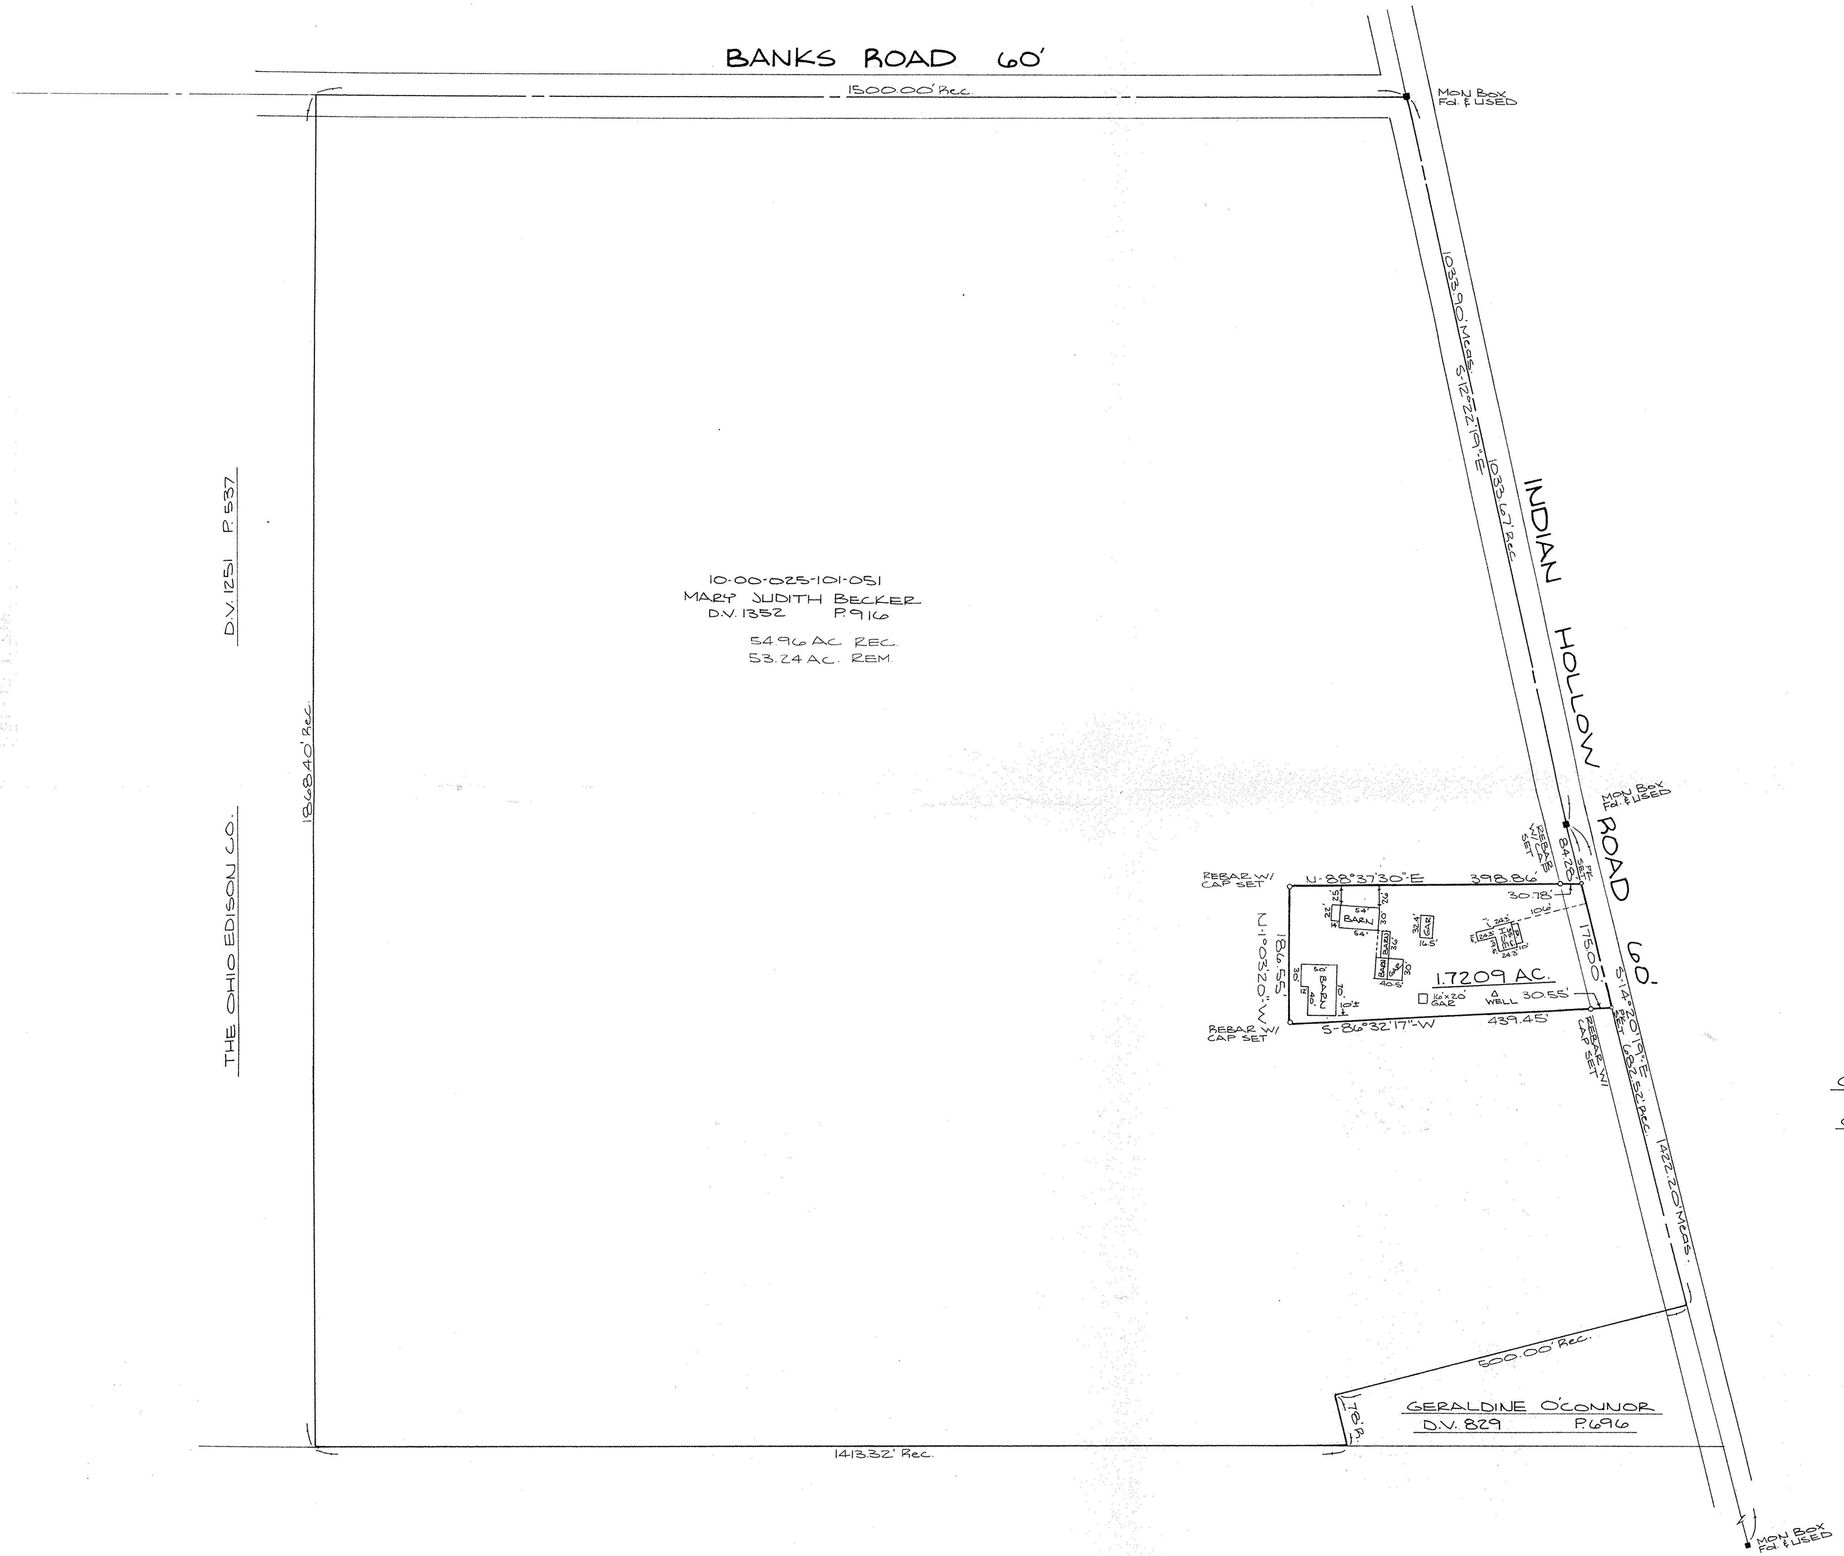

PARCEL & SURVEY MAP

OF PART OF

CARLISLE TOWNSHIP SECTION No. 25

TOWNSHIP OF CARLISLE

COUNTY OF LORAIN STATE OF OHIO

OCTOBER 25, 1994
REV. 01-03-95

PREPARED BY:

KS ASSOCIATES INC.

ENGINEERS SURVEYORS

David L. Elwell

REG. SURV. No. 6333

STATE OF OHIO
DAVID L. ELWELL
6333
REGISTERED SURVEYOR

21238

APPROVED LORAIN CO. MAP DEPT
DATE 2-14-95
PAGE 10-00-025 - A
BY CAROLYN FRANCIS
21238

10-00-025-101- 94-538