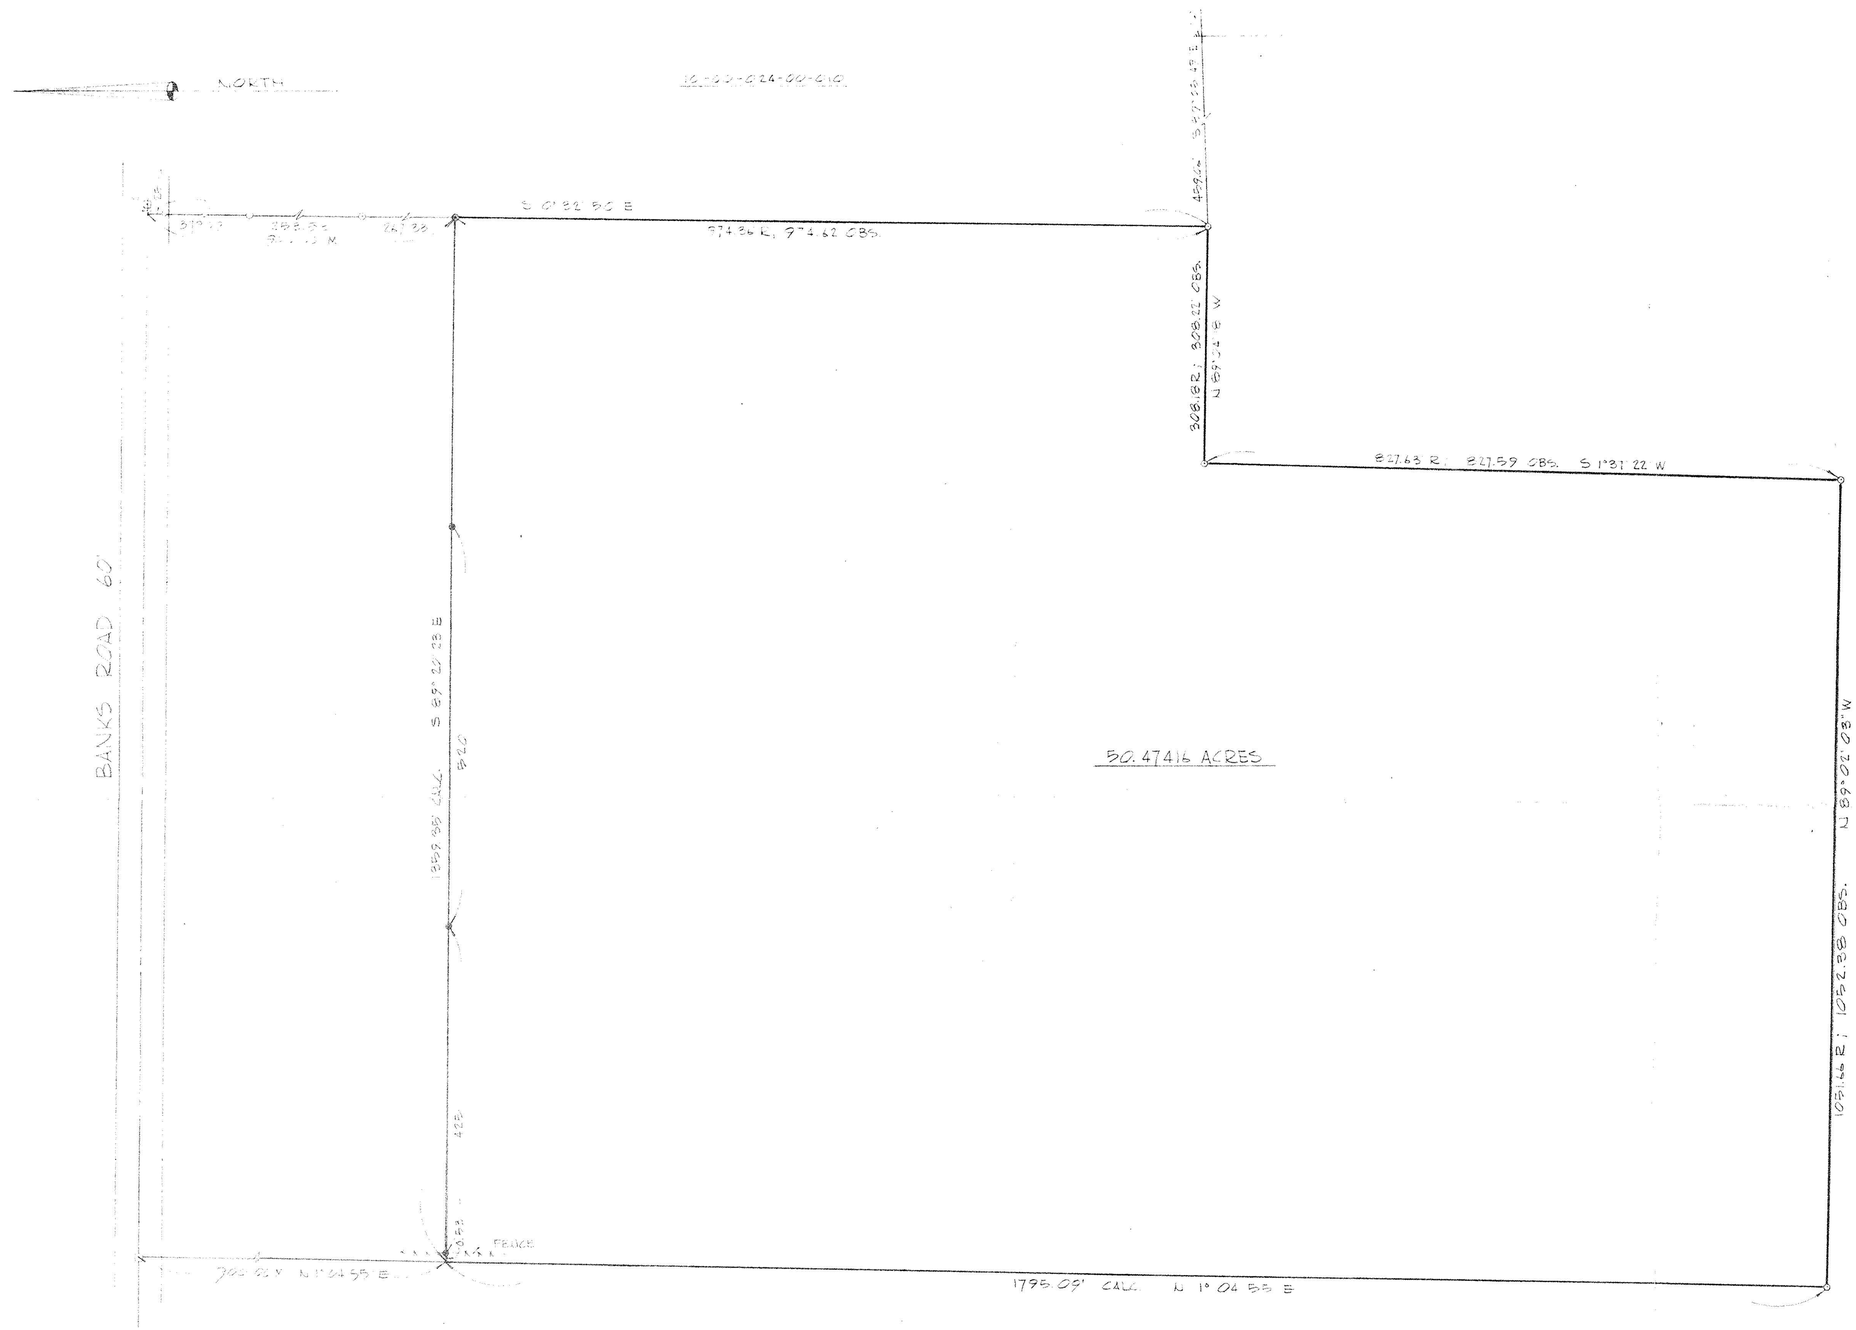

LEGEND
IRON PIN FOUND ----O
IRON PIN SET ------●
RECORD ---------- R
MEASURED -------- M
OBSERVED -------- OBS.
MONUMENT BOX ----D

WILLIAM FEES
CARLISLE TOWNSHIP

SCHAFER, HURA & ASSOCIATES, INC.
ENGINEERS AND SURVEYORS
4656 OBERLIN AVE.
LORAIN, OHIO

50 ACRE SURVEY

ORIGINAL LOT	24	DATE	3-11-74
TOWNSHIP	CARLISLE	SCALE	1" 100'
CITY OF		FIELD BOOK	224 P.9-97
COUNTY OF	LORAIN	DRAWN BY	JFR
STATE OF	OHIO	CHECKED BY	J.L.M.
N. O.	2069	FILE NO.	10-00-24