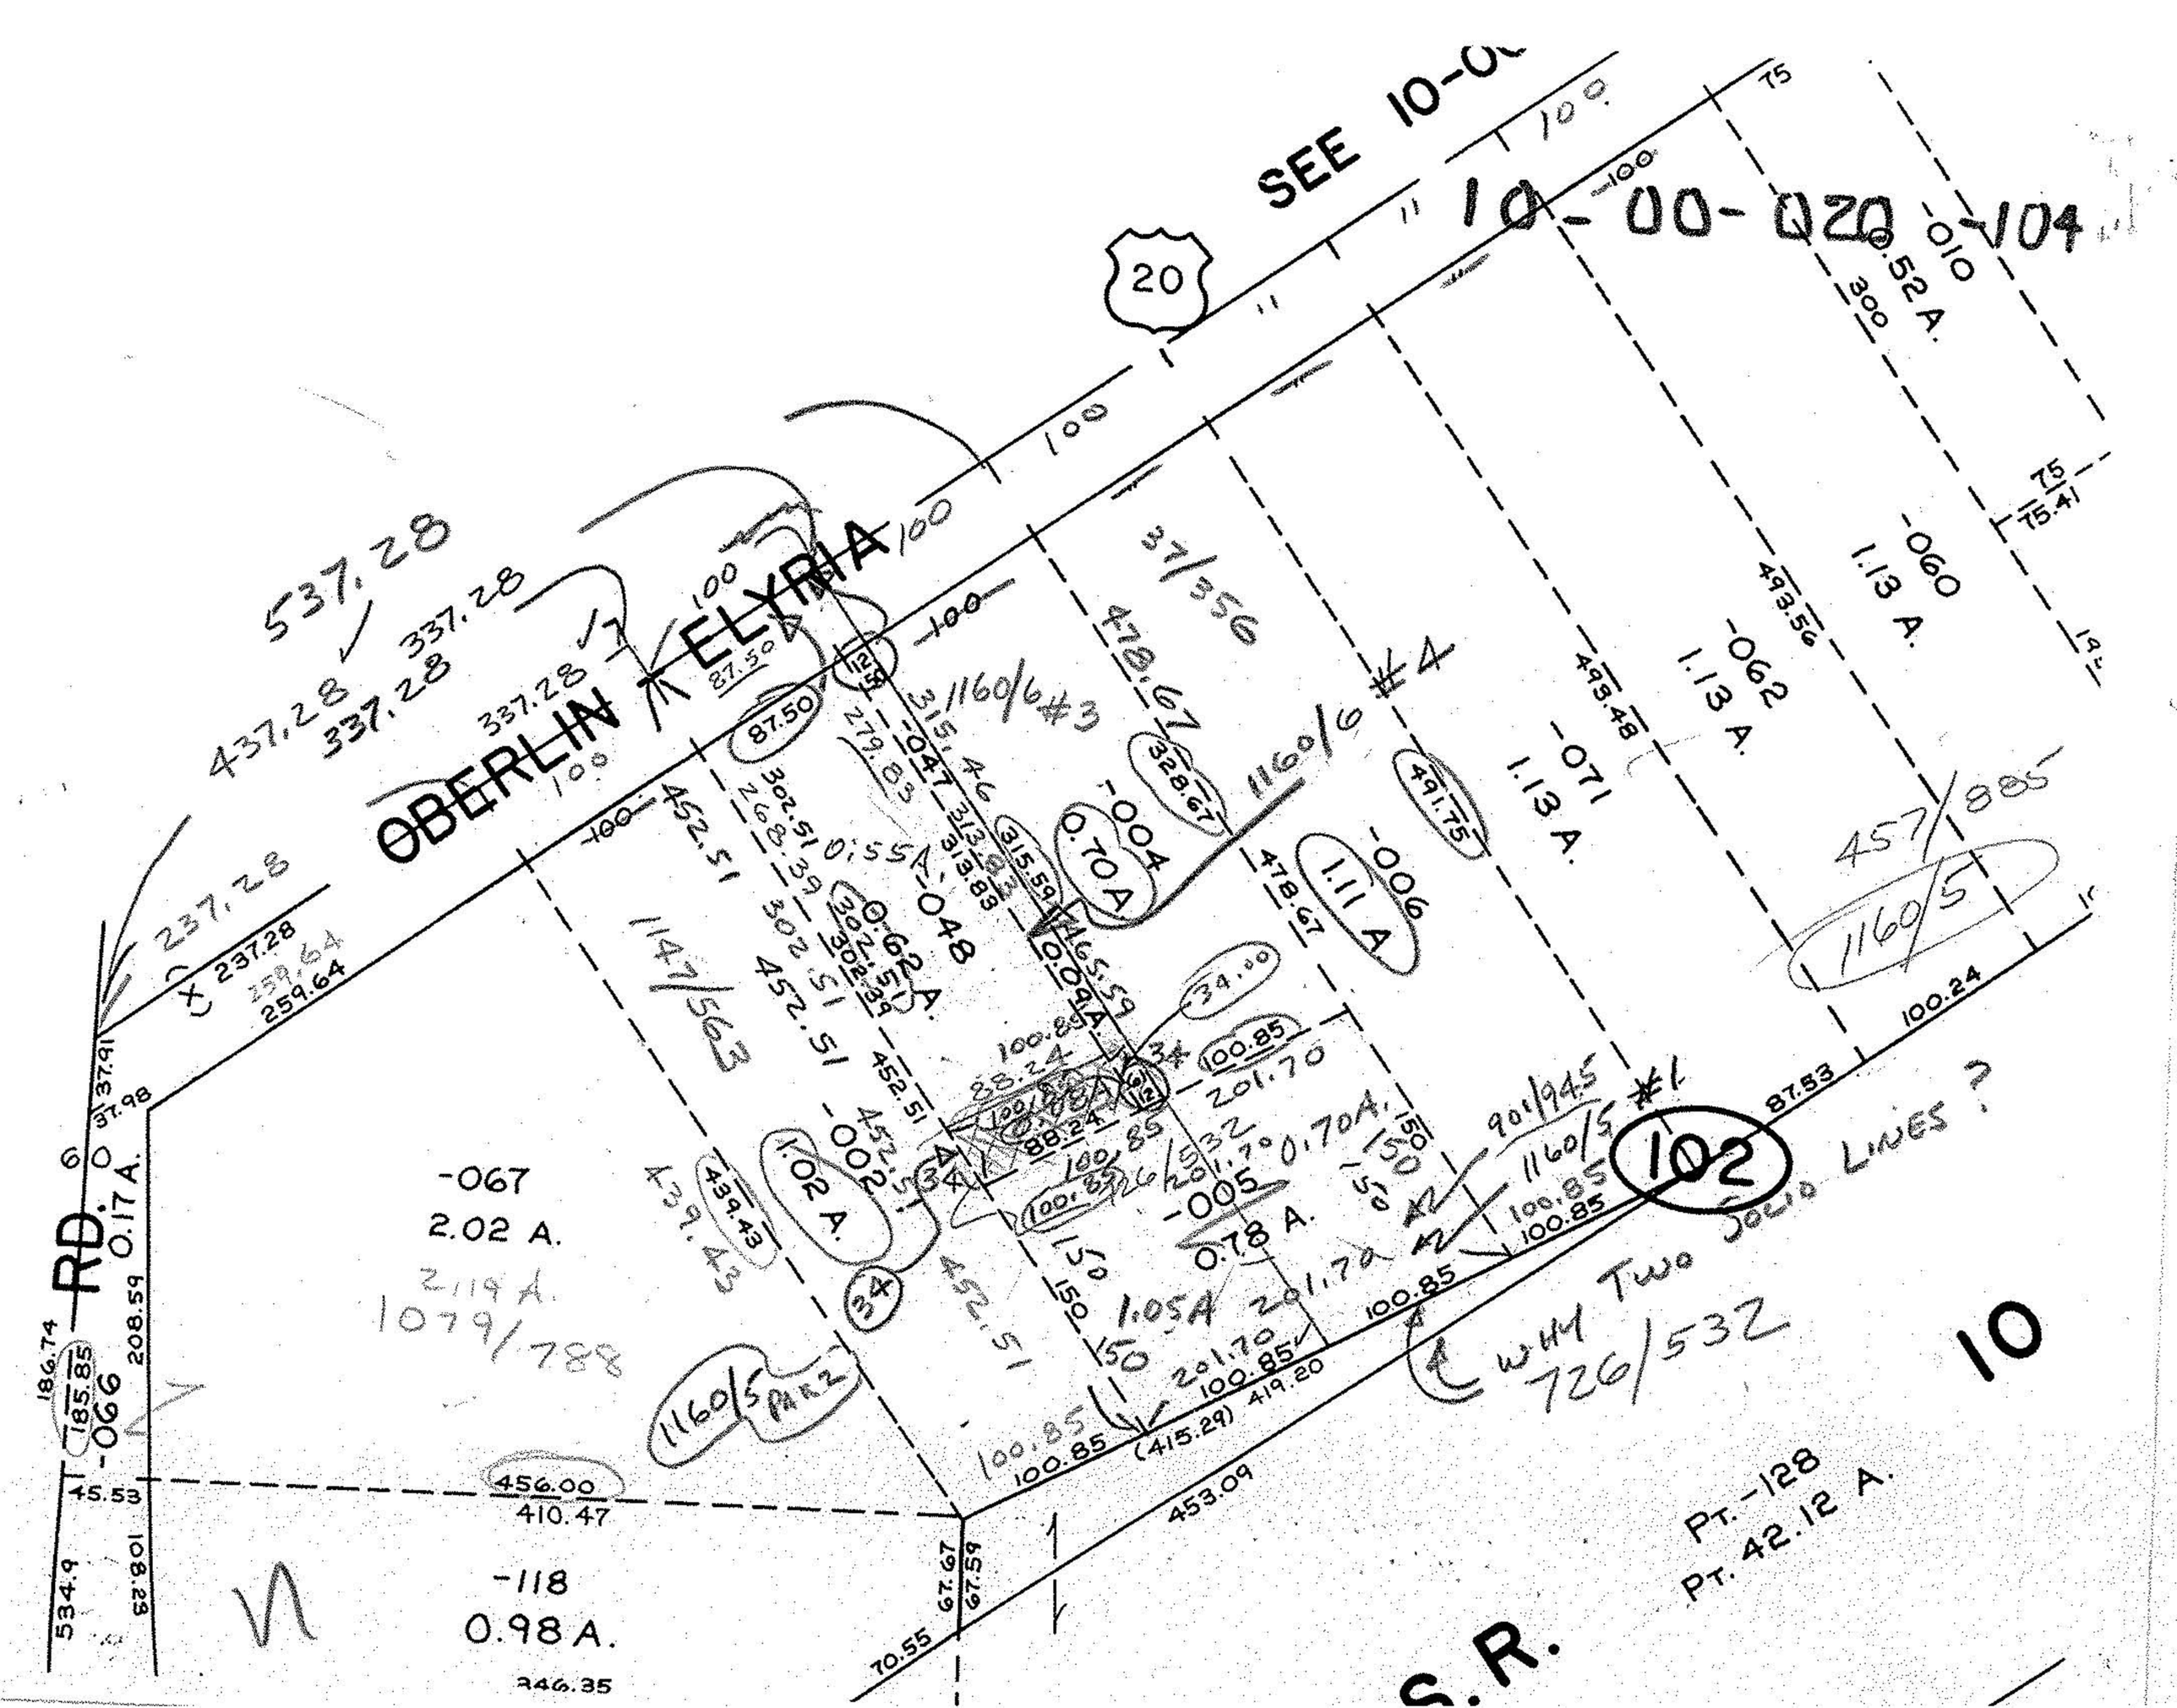

SEE 10-00
10-00-020-104
20
OBERLIN
ELYRIA
537.28
437.28
337.28
237.28
259.64
37.91
37.98
RD.
0.17 A.
-067
2.02 A.
2.19 A.
1079/788
1160/5 PAR 2
-066
186.74
185.85
208.59
45.53
534.9
108.23
456.00
410.47
-118
0.98 A.
346.35
1147/563
452.51
302.51
268.39
0.55 A.
-048
0.62 A.
-047
279.83
315.46
313.83
315.59
1160/6 #3
37/356
478.67
328.67
-004
0.70 A.
1160/6 #4
-006
1.11 A.
491.75
-071
1.13 A.
493.48
-062
1.13 A.
493.56
-060
1.13 A.
-010
0.52 A.
300
75
75.41
457/885
1160/5
100.24
87.53
102
901/945
1160/5 #1
-005
0.78 A.
0.70 A.
1.05 A
201.70
100.85
(415.29)
419.20
453.09
70.55
67.67
67.59
-002
1.02 A.
439.43
34
34.00
100.85
201.70
88.24
1.05 A
150
WHY TWO SOLID LINES ?
726/532
10
PT. -128
PT. 42.12 A.
S.R.