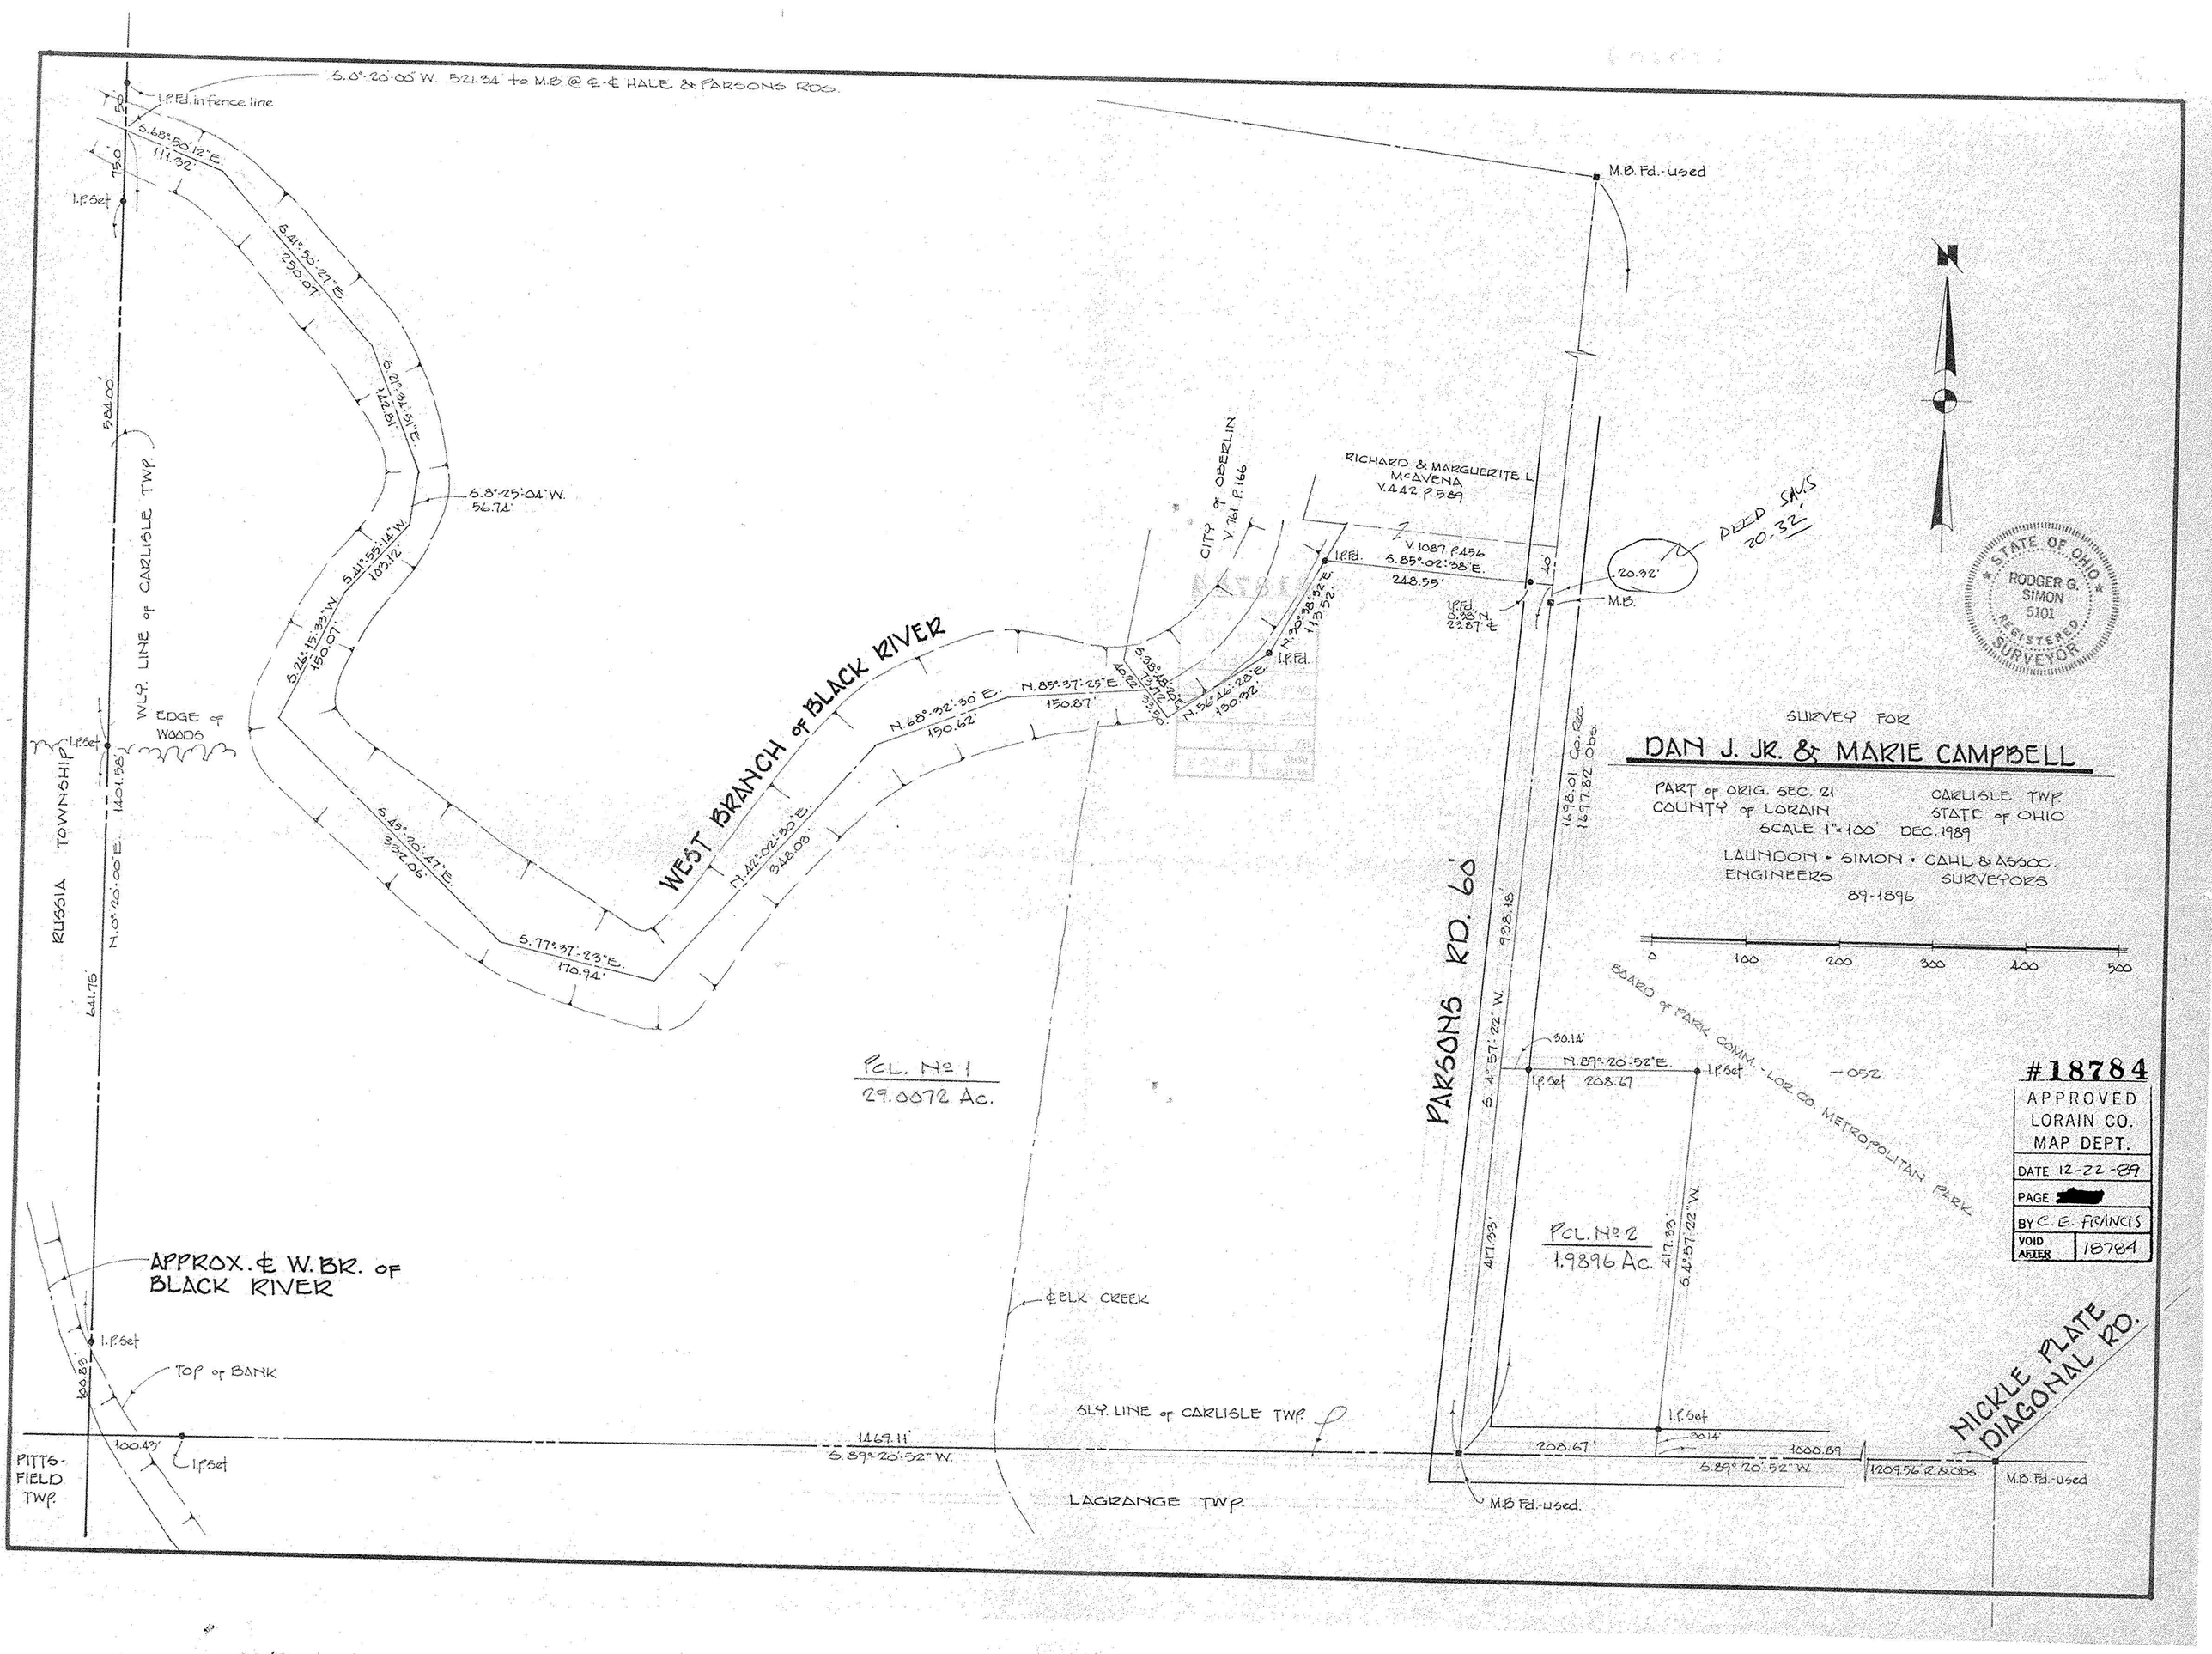

S.0°-20'-00" W. 521.34' to M.B. @ ℄-℄ HALE & PARSONS RDS.
I.P.Fd. in fence line
S.68°-50'-12" E. 111.32'
I.P.Set
S.41°-50'-27" E. 250.07'
S.21°-34'-51" E. 142.81'
S.8°-25'-04" W. 56.74'
S.41°-55'-14" W. 103.12'
S.26°-15'-33" W. 150.07'
S.45°-20'-47" E. 332.06'
S.77°-37'-23" E. 170.94'
N.42°-02'-30" E. 348.03'
N.68°-32'-30" E. 150.62'
N.85°-37'-25" E. 150.87'
N.56°-46'-28" E. 130.32'
N.30°-38'-32" E. 113.52'
WEST BRANCH of BLACK RIVER
CITY of OBERLIN V.761 P.166
RICHARD & MARGUERITE L. McAVENA V.442 P.589
V.1087 P.456
S.85°-02'-38" E. 248.55'
I.P.Fd.
I.P.Fd. 0.38' N. 23.87' ℄
M.B.
M.B. Fd.-used
DEED SAYS 20.32'
20.32'
40'
WLY. LINE of CARLISLE TWP.
584.00'
EDGE of WOODS
RUSSIA TOWNSHIP
N.0°-20'-00" E. 1401.58'
641.75'
PCL. No 1
29.0072 Ac.
PARSONS RD. 60'
1698.01 Co. Rec.
1697.82 Obs.
938.18'
S.4°-57'-22" W.
30.14'
N.89°-20'-52" E. 208.67'
I.P.Set
BOARD of PARK COMM. - LOR. CO. METROPOLITAN PARK
-052
PCL. No 2
1.9896 Ac.
417.33'
S.4°-57'-22" W.
APPROX. ℄ W. BR. of BLACK RIVER
℄ ELK CREEK
TOP of BANK
100.83'
100.43'
PITTS-FIELD TWP.
SLY. LINE of CARLISLE TWP.
1469.11'
S.89°-20'-52" W.
LAGRANGE TWP.
M.B. Fd.-used.
208.67'
30.14'
1000.89'
S.89°-20'-52" W.
1209.56' R. & Obs.
M.B. Fd.-used
NICKLE PLATE DIAGONAL RD.
STATE OF OHIO
RODGER G. SIMON
5101
REGISTERED SURVEYOR
SURVEY FOR
DAN J. JR. & MARIE CAMPBELL
PART of ORIG. SEC. 21
COUNTY of LORAIN
CARLISLE TWP.
STATE of OHIO
SCALE 1"=100' DEC. 1989
LAUNDON • SIMON • CAHL & ASSOC.
ENGINEERS SURVEYORS
89-1896
0 100 200 300 400 500
#18784
APPROVED LORAIN CO. MAP DEPT.
DATE 12-22-89
PAGE [redacted]
BY C. E. FRANCIS
VOID AFTER 18784