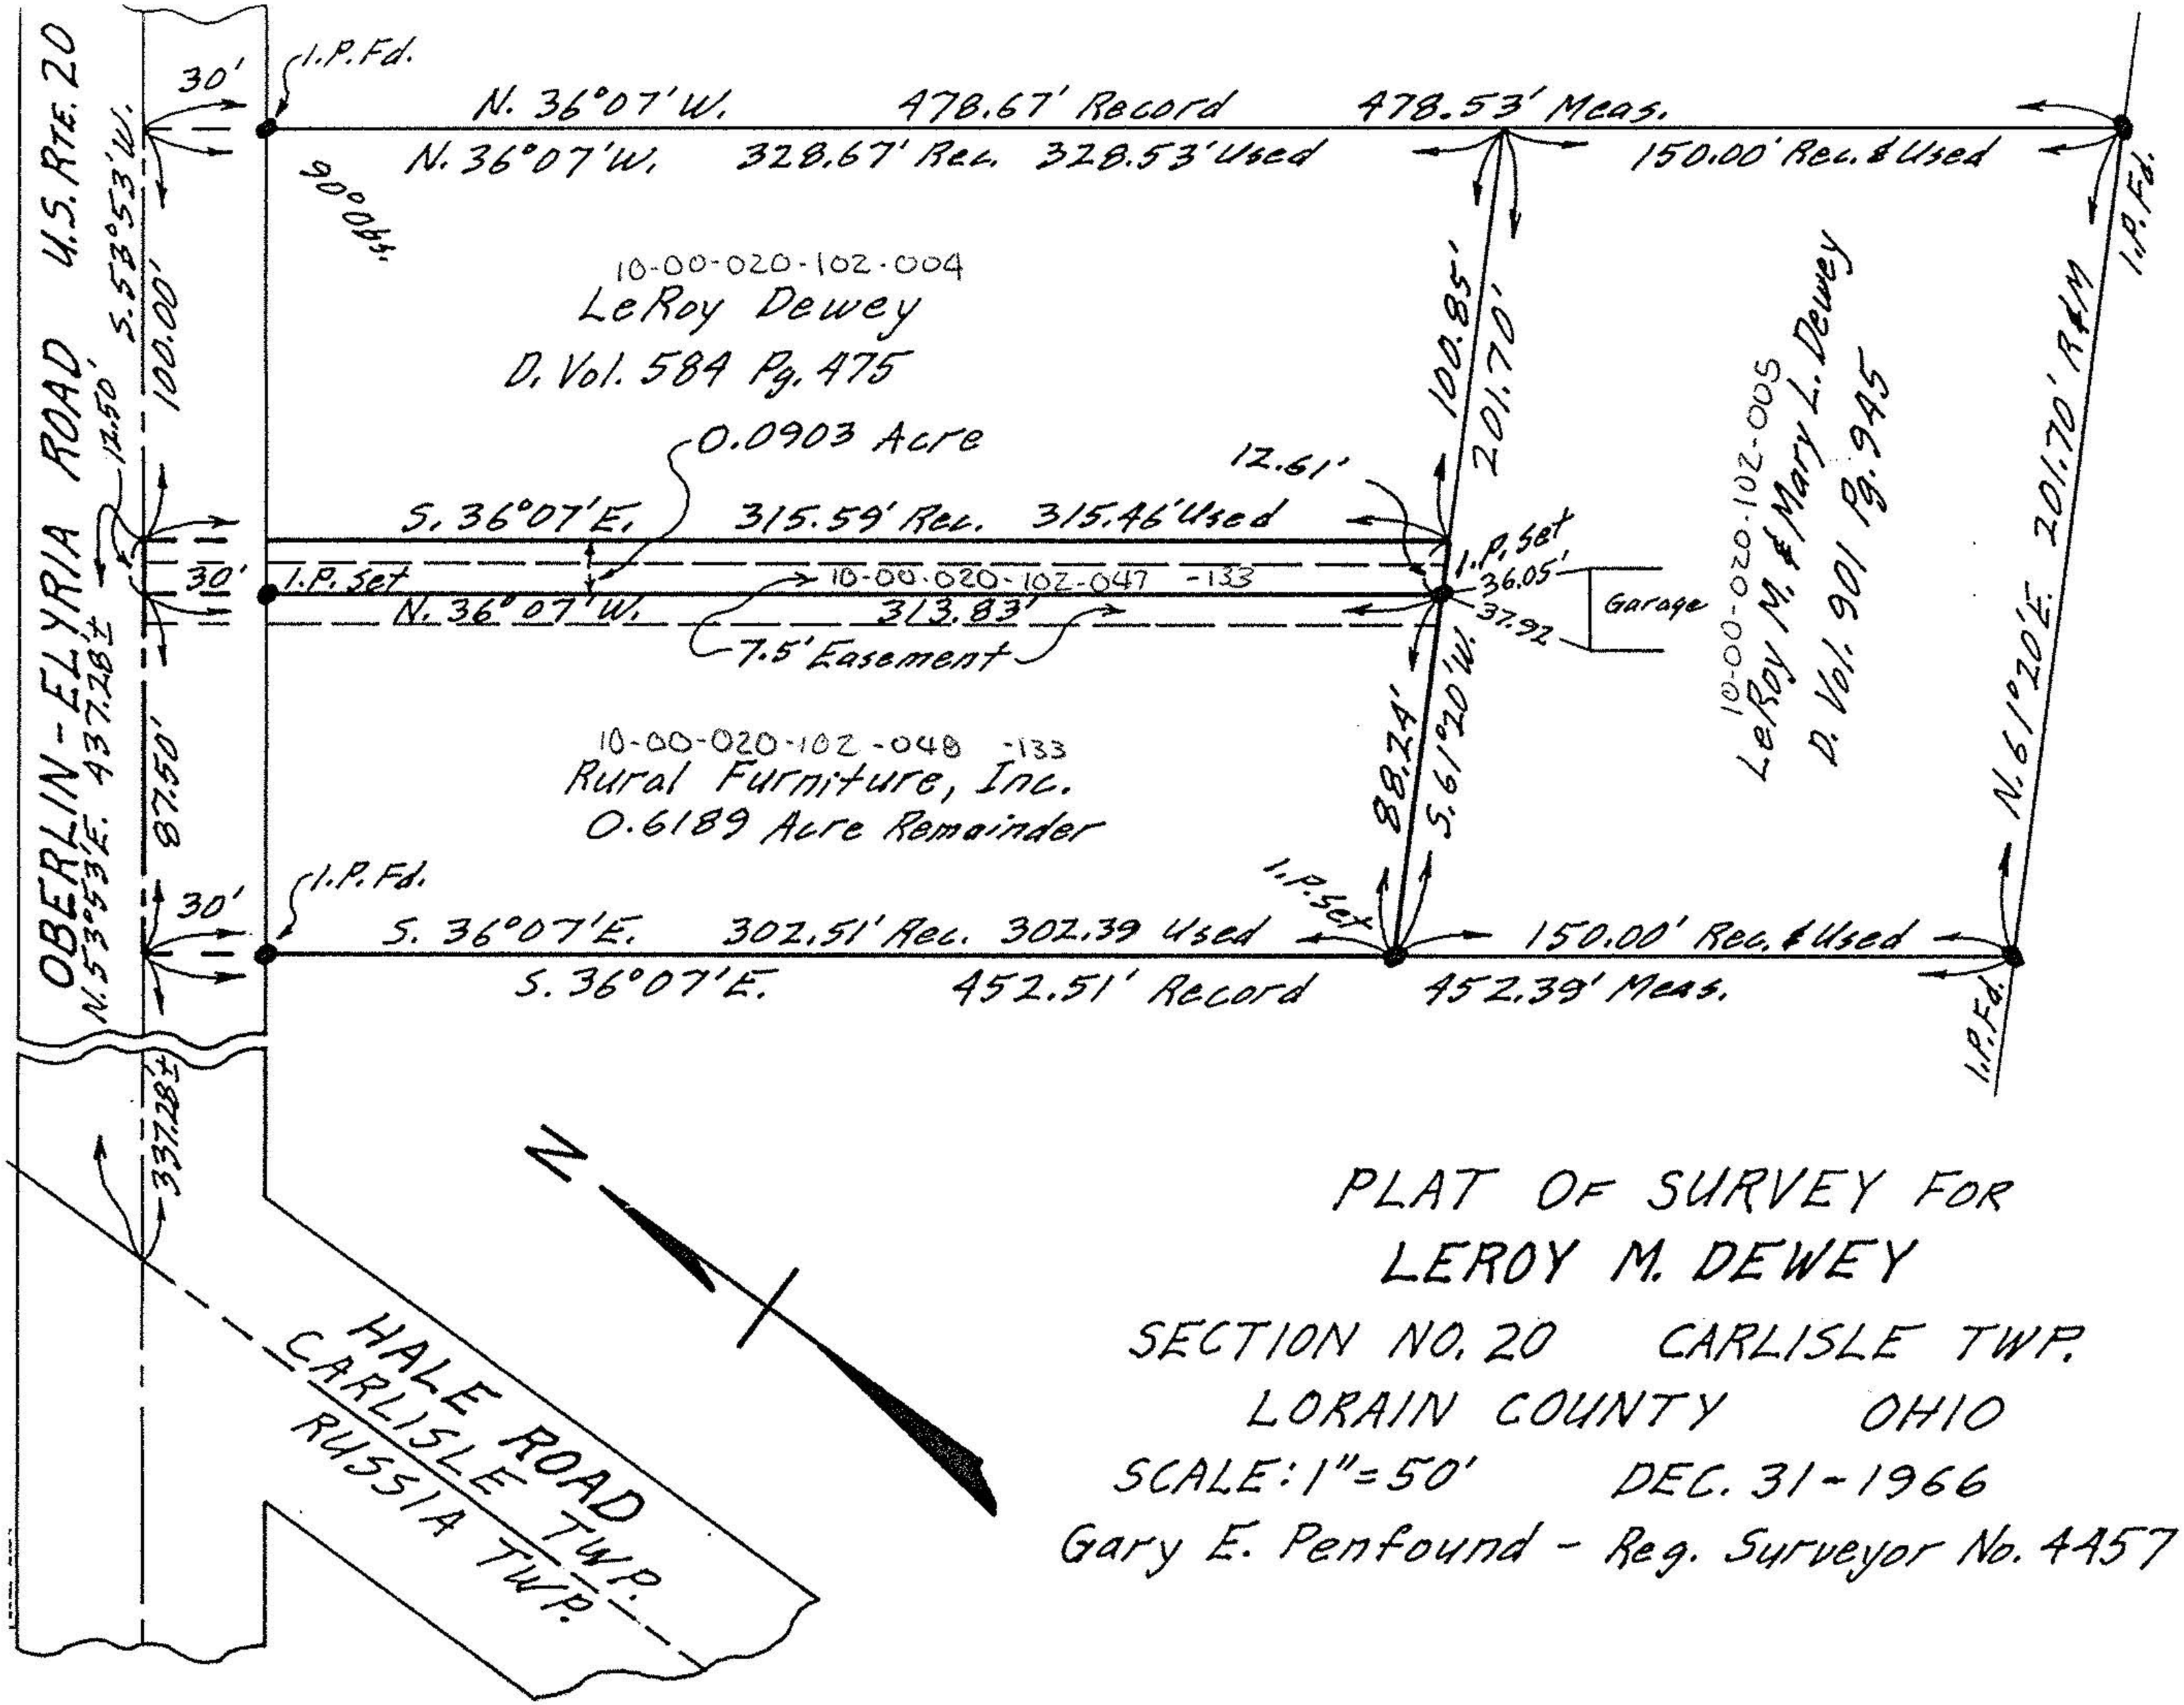

PLAT OF SURVEY FOR
LEROY M. DEWEY
SECTION NO. 20 CARLISLE TWP.
LORAIN COUNTY OHIO
SCALE: 1" = 50' DEC. 31 - 1966
Gary E. Penfound - Reg. Surveyor No. 4457