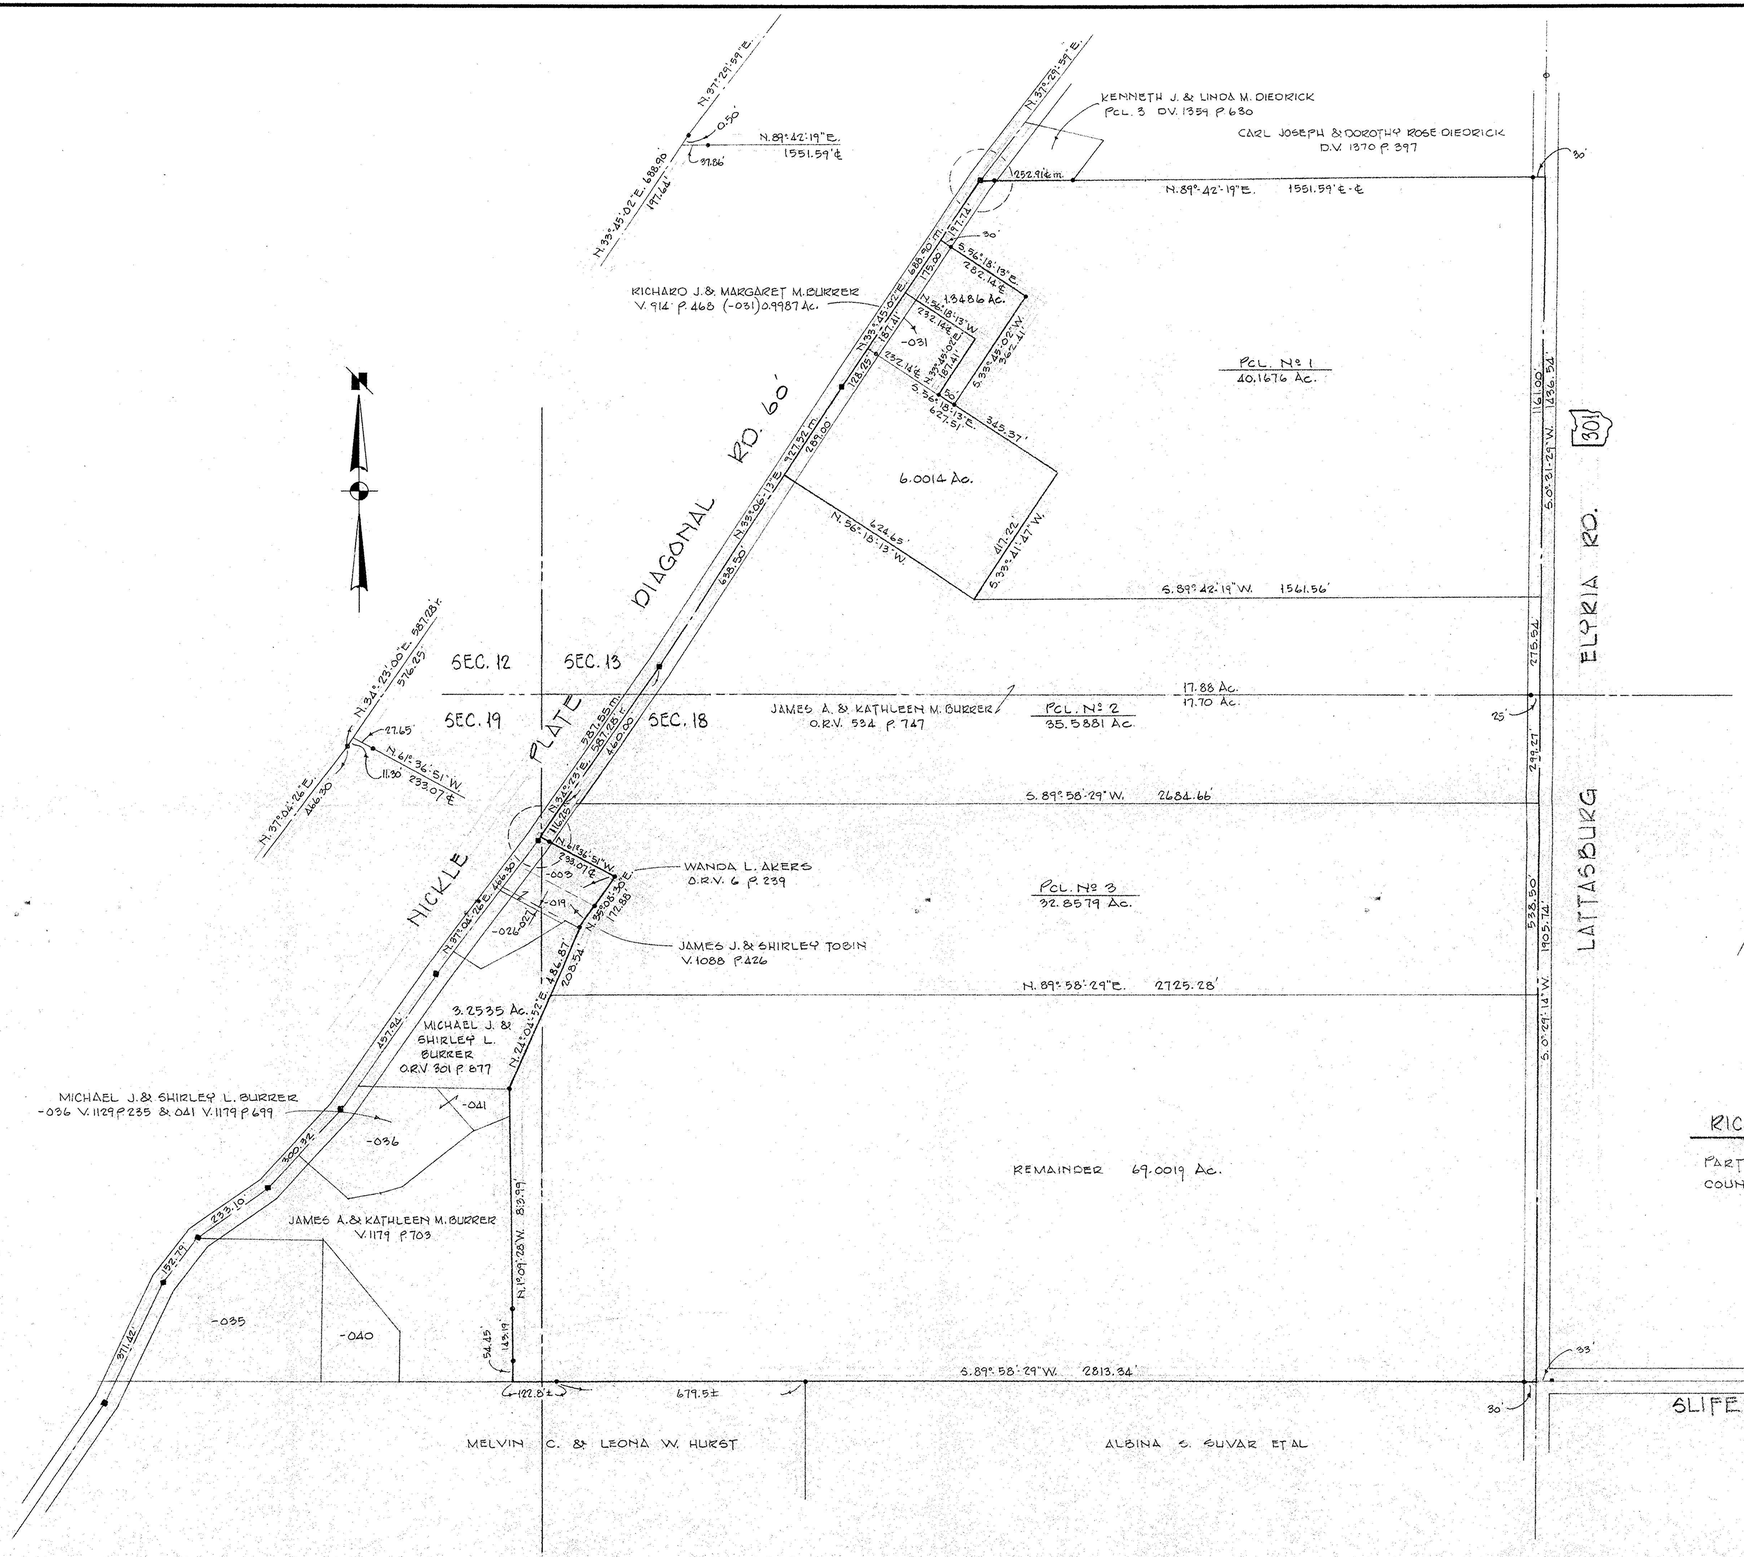

TOTAL ORIGINAL ACREAGE 177.6156 Ac.
- PCL. Nº 1 40.1676 Ac.
2-14-91 RMOR. 137.4480 Ac.
- PCL. Nº 2 35.5881 Ac.
1-29-92 RMOR. 101.8598 Ac.
- PCL. Nº 3 32.8579 Ac.
1-07-93 RMOR. 69.0019 Ac.

DENOTES MON. BOX W/IRON PIN FOUND SET BY CO. ENGRS. DEPT. - USED

DENOTES IRON PIN FOUND or SET

SURVEY FOR

RICHARD J. & MARGARET M. BURRER

PART OF ORIG. SECTIONS 12, 18 & 19 OF CARLISLE TWP
COUNTY OF LORAIN STATE OF OHIO
SCALE 1" = 200' JAN. 1991

LAUNDON • SIMON • CAHL & ASSOC.
ENGINEERS SURVEYORS
106 MIDDLE AVE. ELYRIA, OHIO 44035

JOB Nº 90-1987

STATE OF OHIO
RODGER G. SIMON
5101
REGISTERED SURVEYOR

REV. 1-07-93 PCL. 3 R.G.S.
REV. 1-30-92 PCL. 2 R.G.S.
REV. 2-14-91 PCL. 1 R.G.S.

20304
APPROVED
LORAIN CO.
MAP DEPT.
DATE
PAGE
BY
VOID
AKERS

258