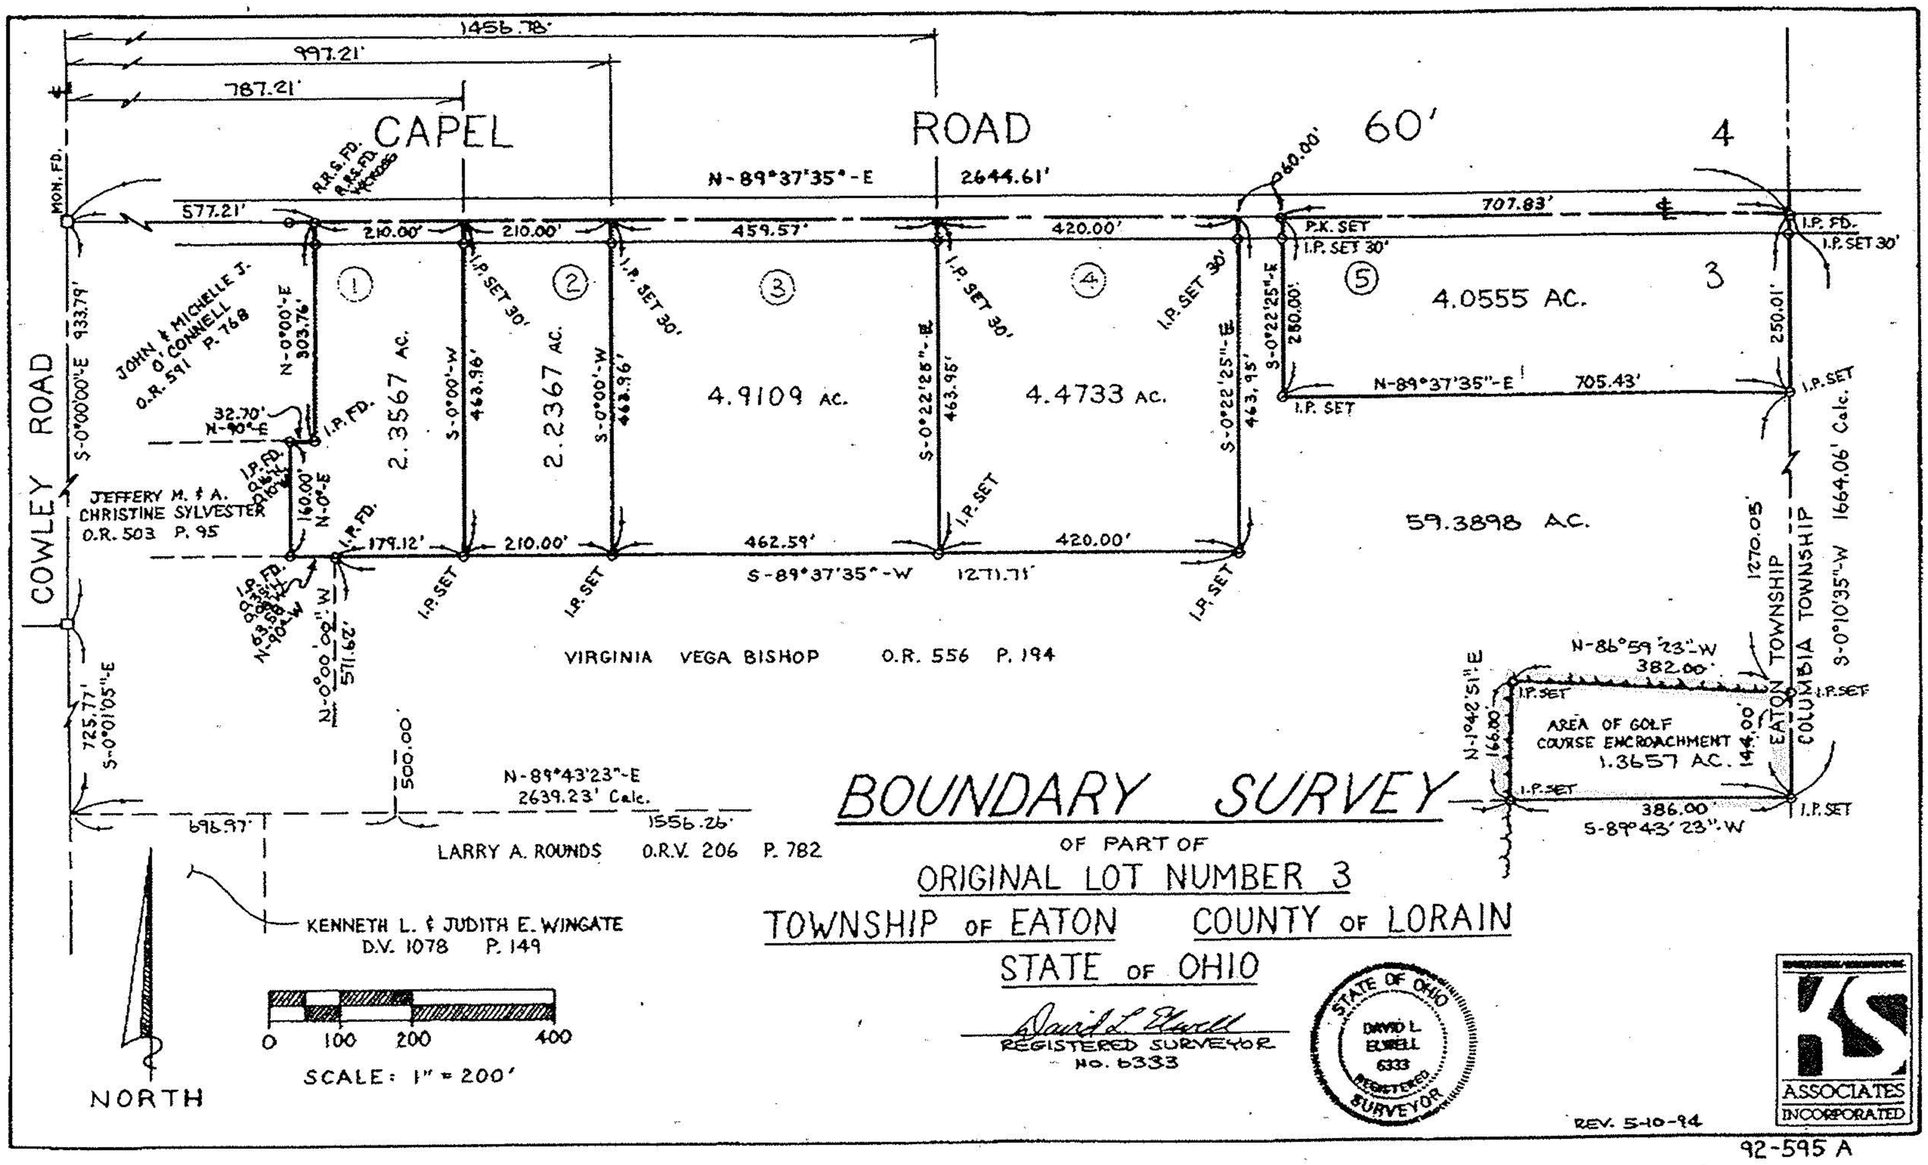

CAPEL ROAD 60'
COWLEY ROAD
N-89°37'35"-E 2644.61'
1456.78'
997.21'
787.21'
577.21'
707.83'
459.57'
420.00'
210.00'
4.0555 AC.
4.9109 AC.
4.4733 AC.
2.3567 AC.
2.2367 AC.
59.3898 AC.
JOHN & MICHELLE J. O'CONNELL O.R. 591 P. 768
JEFFERY M. & A. CHRISTINE SYLVESTER O.R. 503 P. 95
VIRGINIA VEGA BISHOP O.R. 556 P. 194
LARRY A. ROUNDS O.R.V. 206 P. 782
KENNETH L. & JUDITH E. WINGATE D.V. 1078 P. 149
AREA OF GOLF COURSE ENCROACHMENT 1.3657 AC.
EATON TOWNSHIP
COLUMBIA TOWNSHIP
S-0°10'35"-W 1664.06' Calc.
N-89°43'23"-E 2639.23' Calc.
S-89°37'35"-W 1271.71'
N-86°59'23"-W 382.00'
S-89°43'23"-W 386.00'
BOUNDARY SURVEY
OF PART OF
ORIGINAL LOT NUMBER 3
TOWNSHIP OF EATON COUNTY OF LORAIN
STATE OF OHIO
REGISTERED SURVEYOR No. 6333
STATE OF OHIO DAVID L. ELWELL 6333 REGISTERED SURVEYOR
SCALE: 1" = 200'
NORTH
REV. 5-10-94
KS ASSOCIATES INCORPORATED

92-595 A

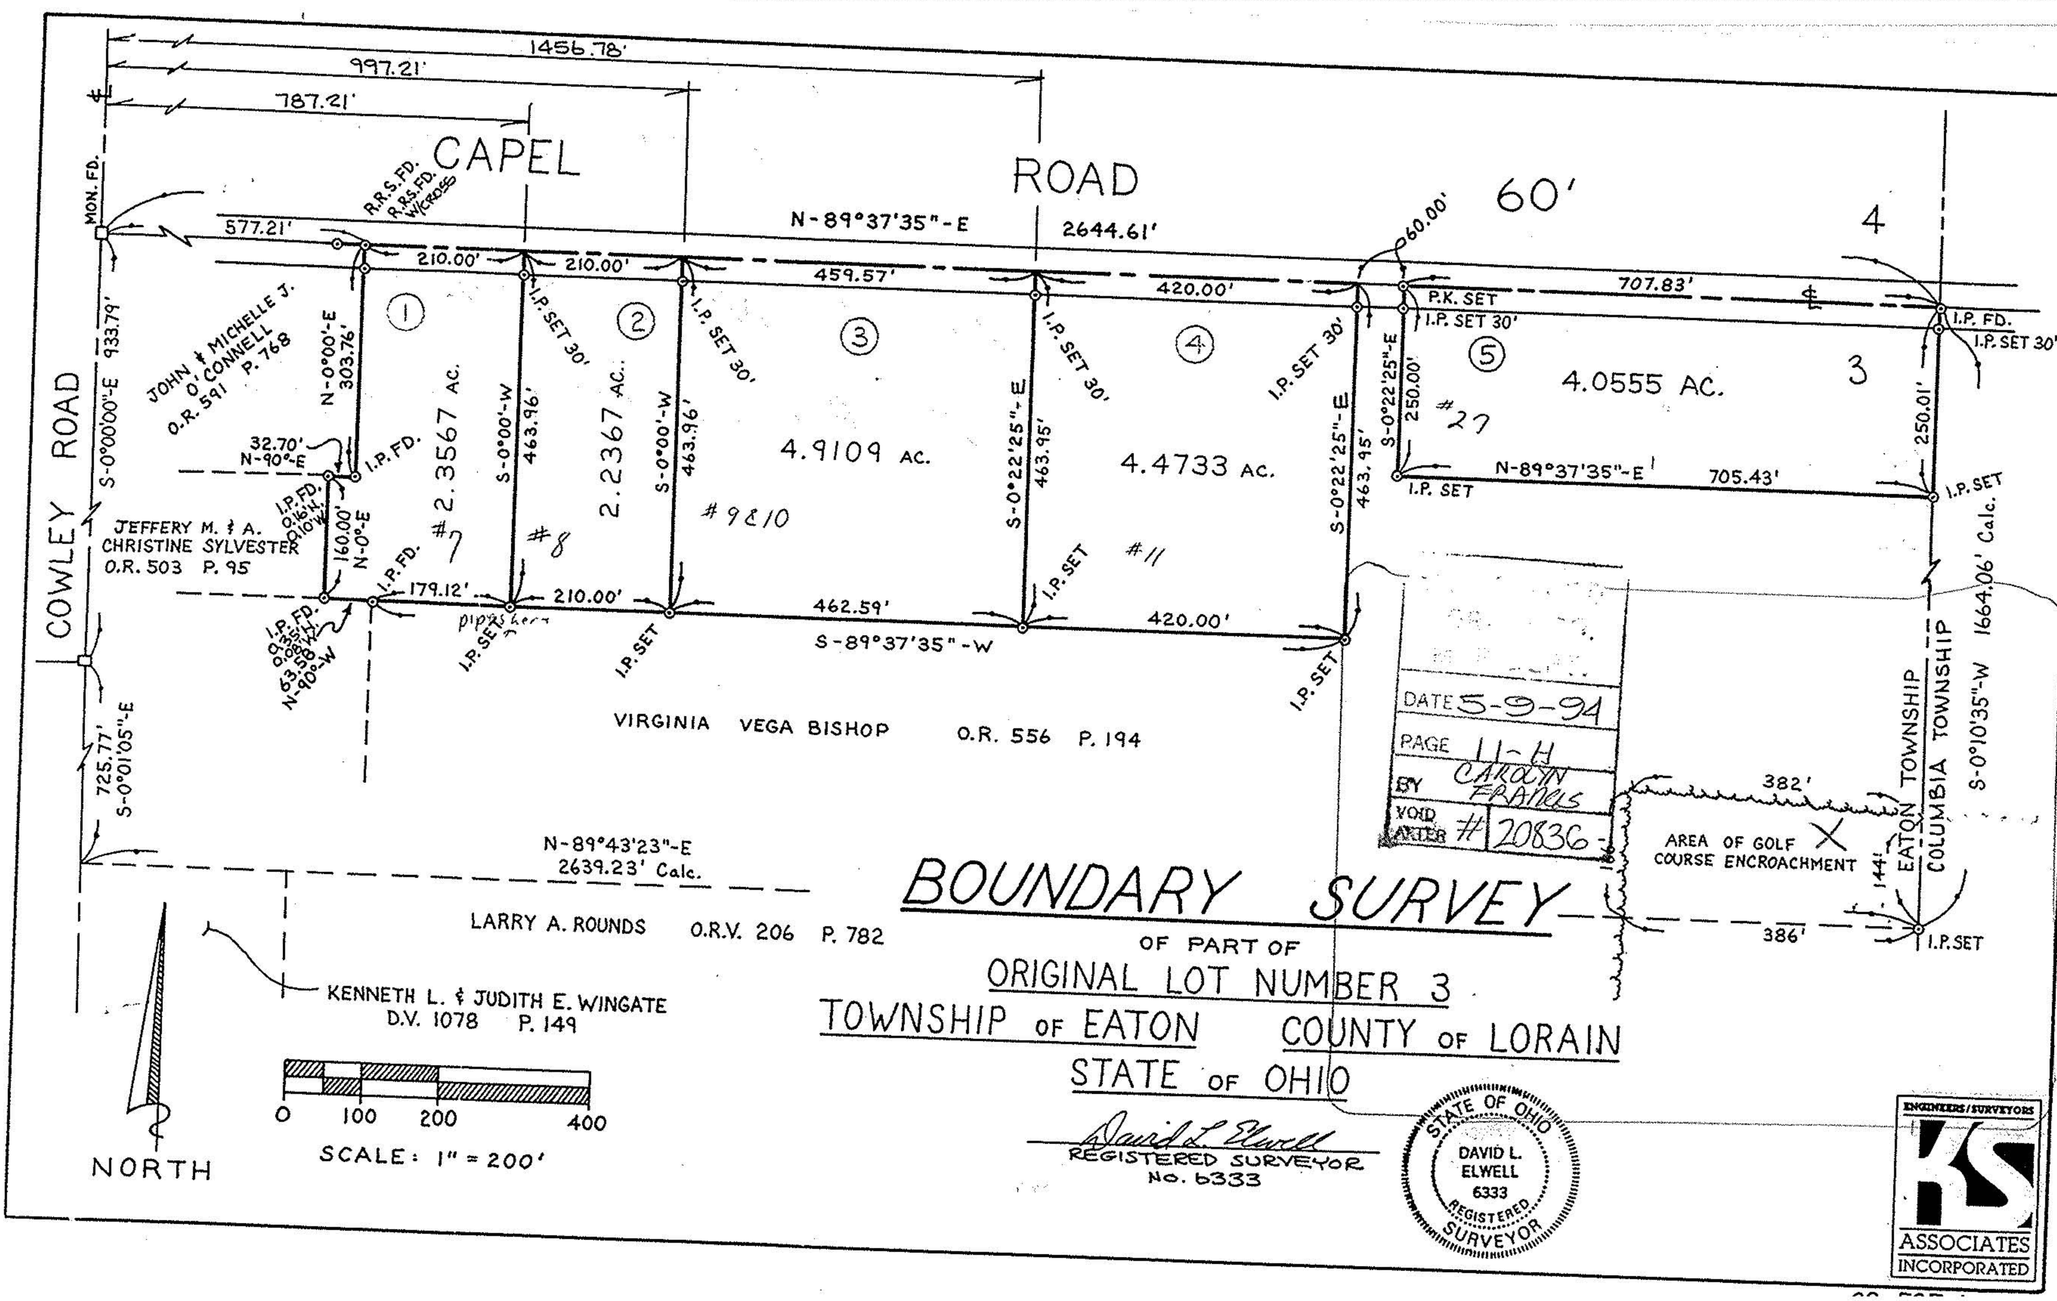

CAPEL ROAD 60'
COWLEY ROAD
N-89°37'35"-E 2644.61'
1456.78'
997.21'
787.21'
577.21'
707.83'
459.57'
420.00'
210.00'
4.0555 AC.
4.9109 AC.
4.4733 AC.
2.3567 AC.
2.2367 AC.
JOHN & MICHELLE J. O'CONNELL O.R. 591 P. 768
JEFFERY M. & A. CHRISTINE SYLVESTER O.R. 503 P. 95
VIRGINIA VEGA BISHOP O.R. 556 P. 194
LARRY A. ROUNDS O.R.V. 206 P. 782
KENNETH L. & JUDITH E. WINGATE D.V. 1078 P. 149
AREA OF GOLF COURSE ENCROACHMENT
EATON TOWNSHIP
COLUMBIA TOWNSHIP
S-0°10'35"-W 1664.06' Calc.
N-89°43'23"-E 2639.23' Calc.
S-89°37'35"-W
DATE 5-9-94
PAGE 11-H
BY CAROLYN FRANCIS
VOID AFTER # 20836
BOUNDARY SURVEY
OF PART OF
ORIGINAL LOT NUMBER 3
TOWNSHIP OF EATON COUNTY OF LORAIN
STATE OF OHIO
REGISTERED SURVEYOR No. 6333
STATE OF OHIO DAVID L. ELWELL 6333 REGISTERED SURVEYOR
SCALE: 1" = 200'
NORTH
ENGINEERS/SURVEYORS
KS ASSOCIATES INCORPORATED