


HAPONEK & ASSOCIATES, INC.



Engineers & Surveyors
34100 Center Ridge Road
NORTH RIDGEVILLE, OHIO 44039
(216) 327-4776 Lorain 288-4400

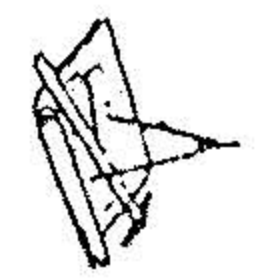

VACANT LAND



DATE: JAN. 1988
SCALE: 1"=100'

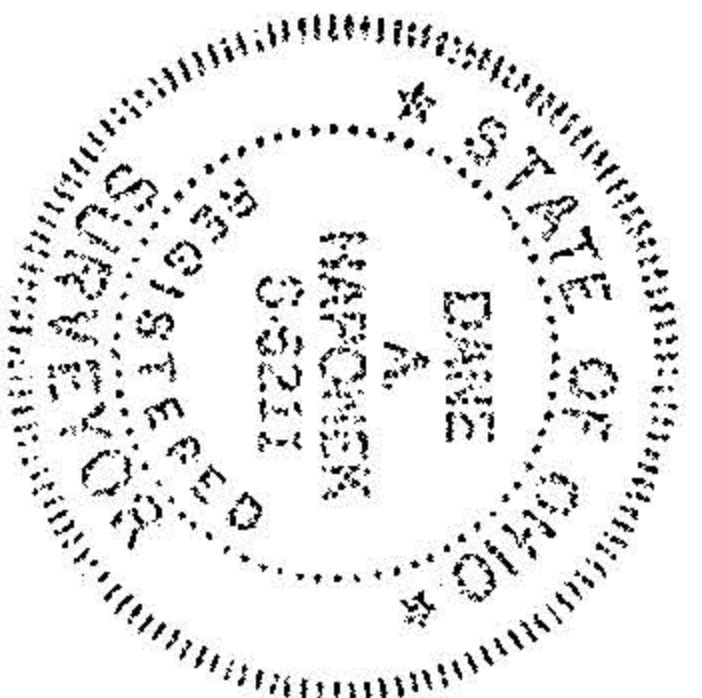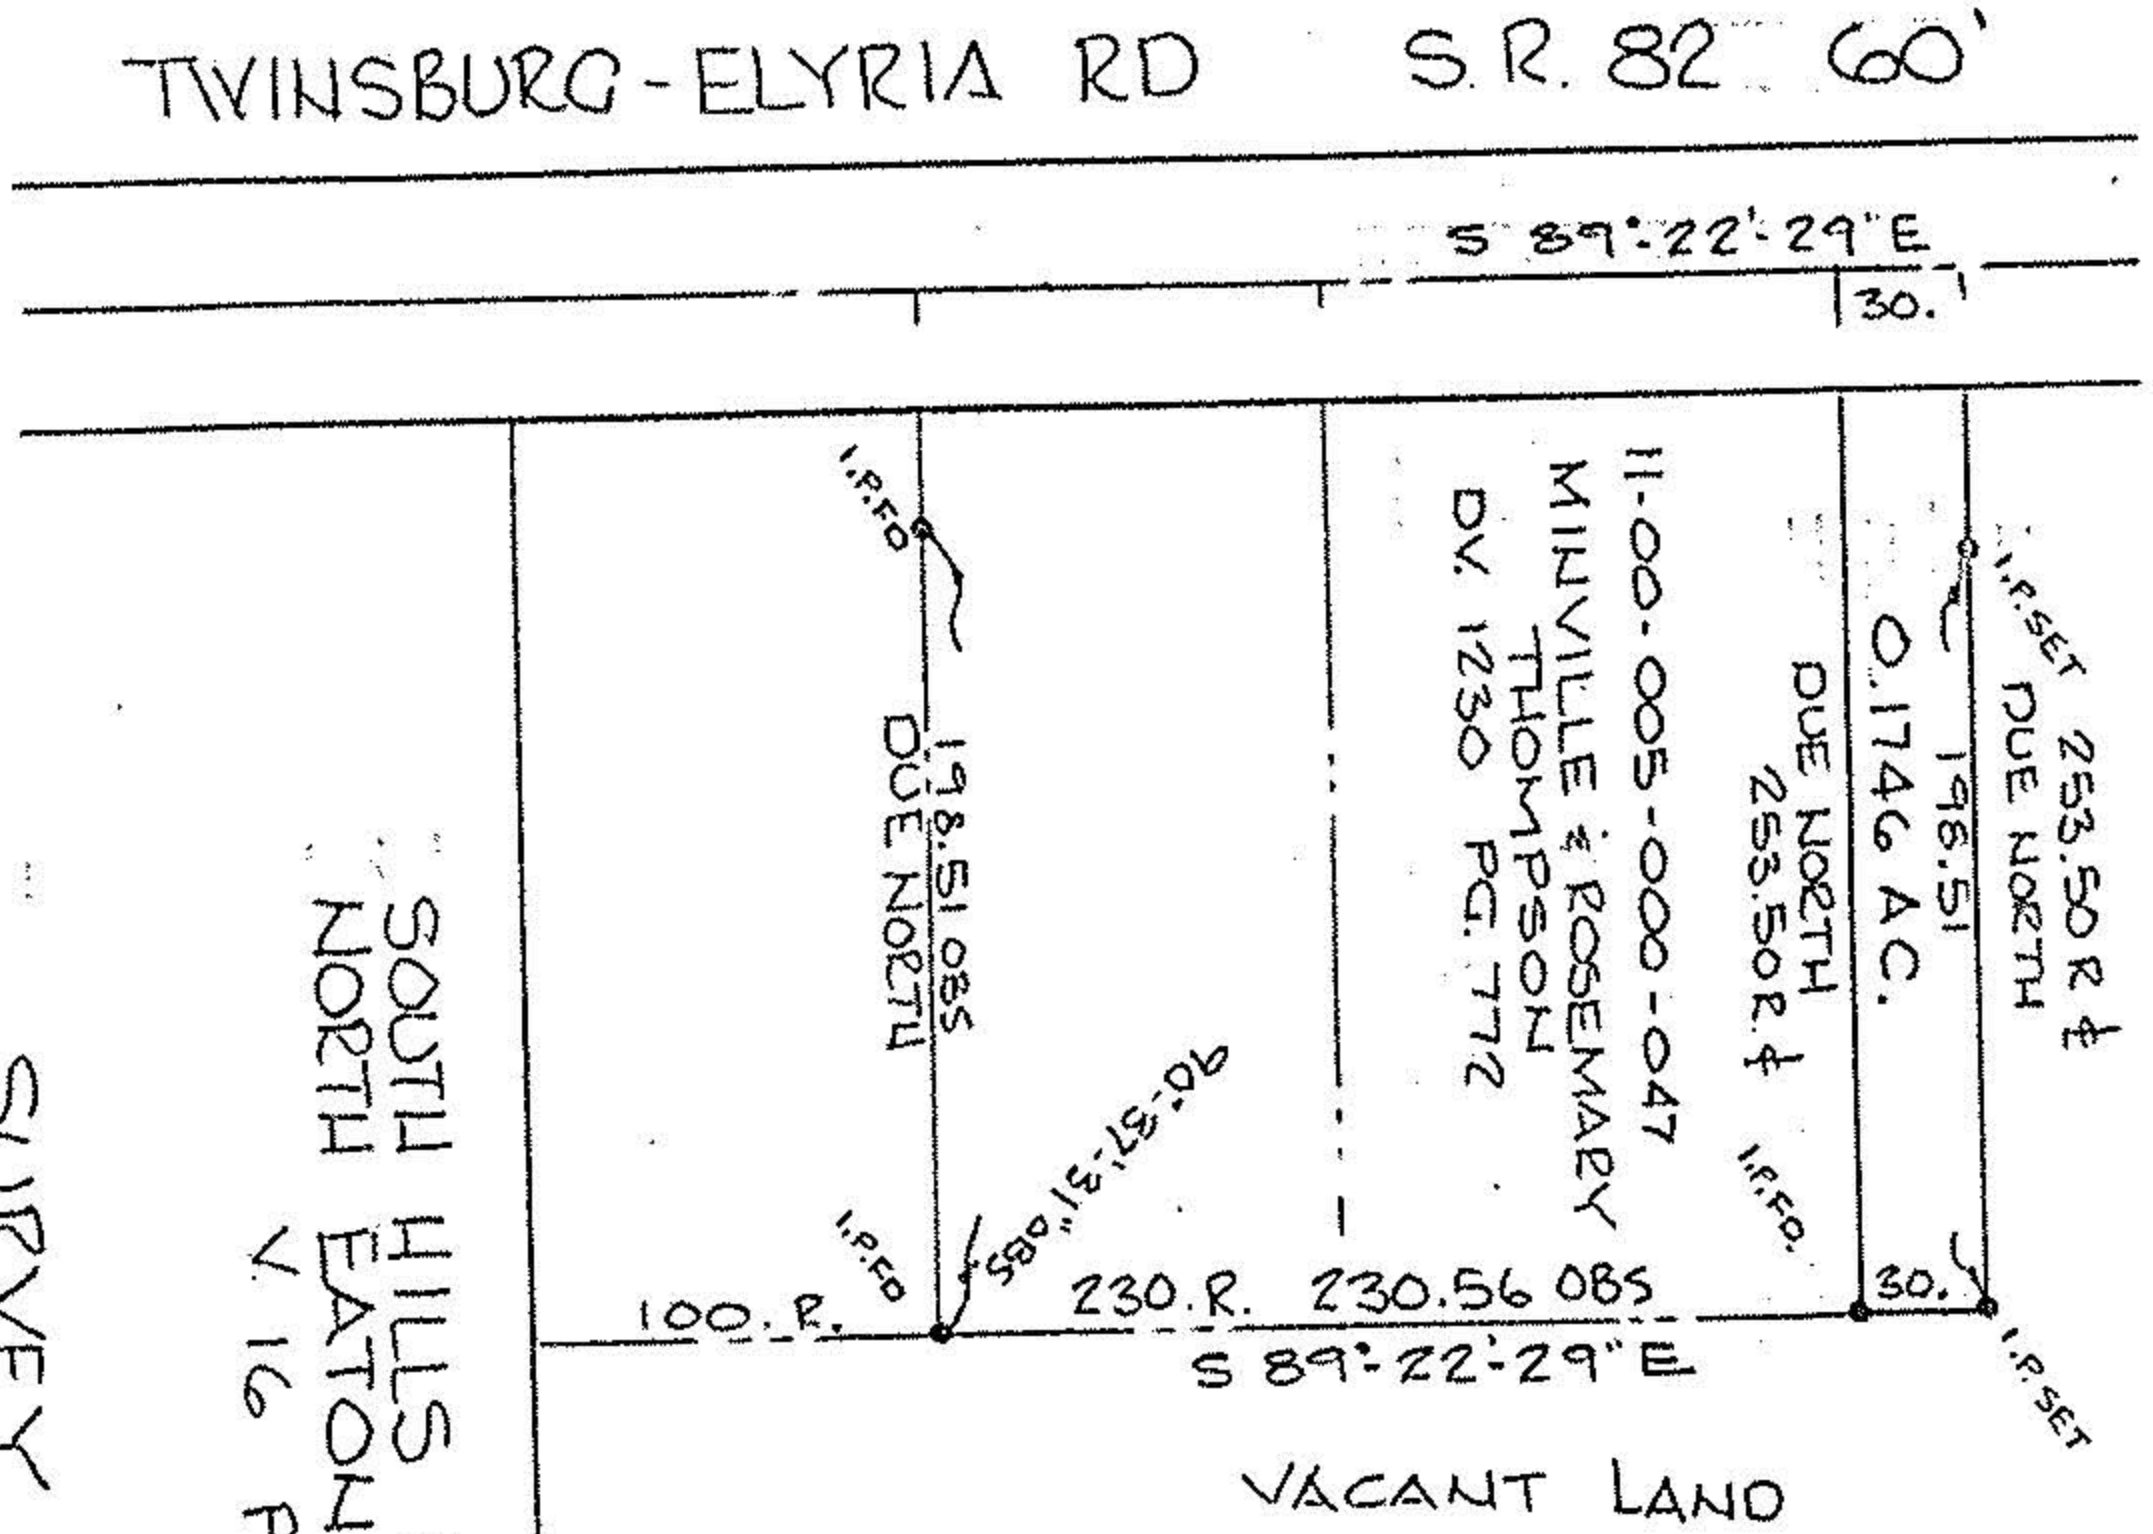

#18206

APPROVED
LORAIN CO.
MAP DEPT.
DATE 11-10-88
PAGE 11-H
BY T-McLain
VOID AFTER 18206

SURVEY
OF PART OF
ORIGINAL LOT NO. 5 EATON TWP.
TWP. OF EATON COUNTY OF OHIO
STATE OF OHIO

PREPARED FOR:
CARPENTER FARMS, INC. (ALLEN CARPENTER)
1794 BROKAW RD.
COLUMBIA STATION, O 44028