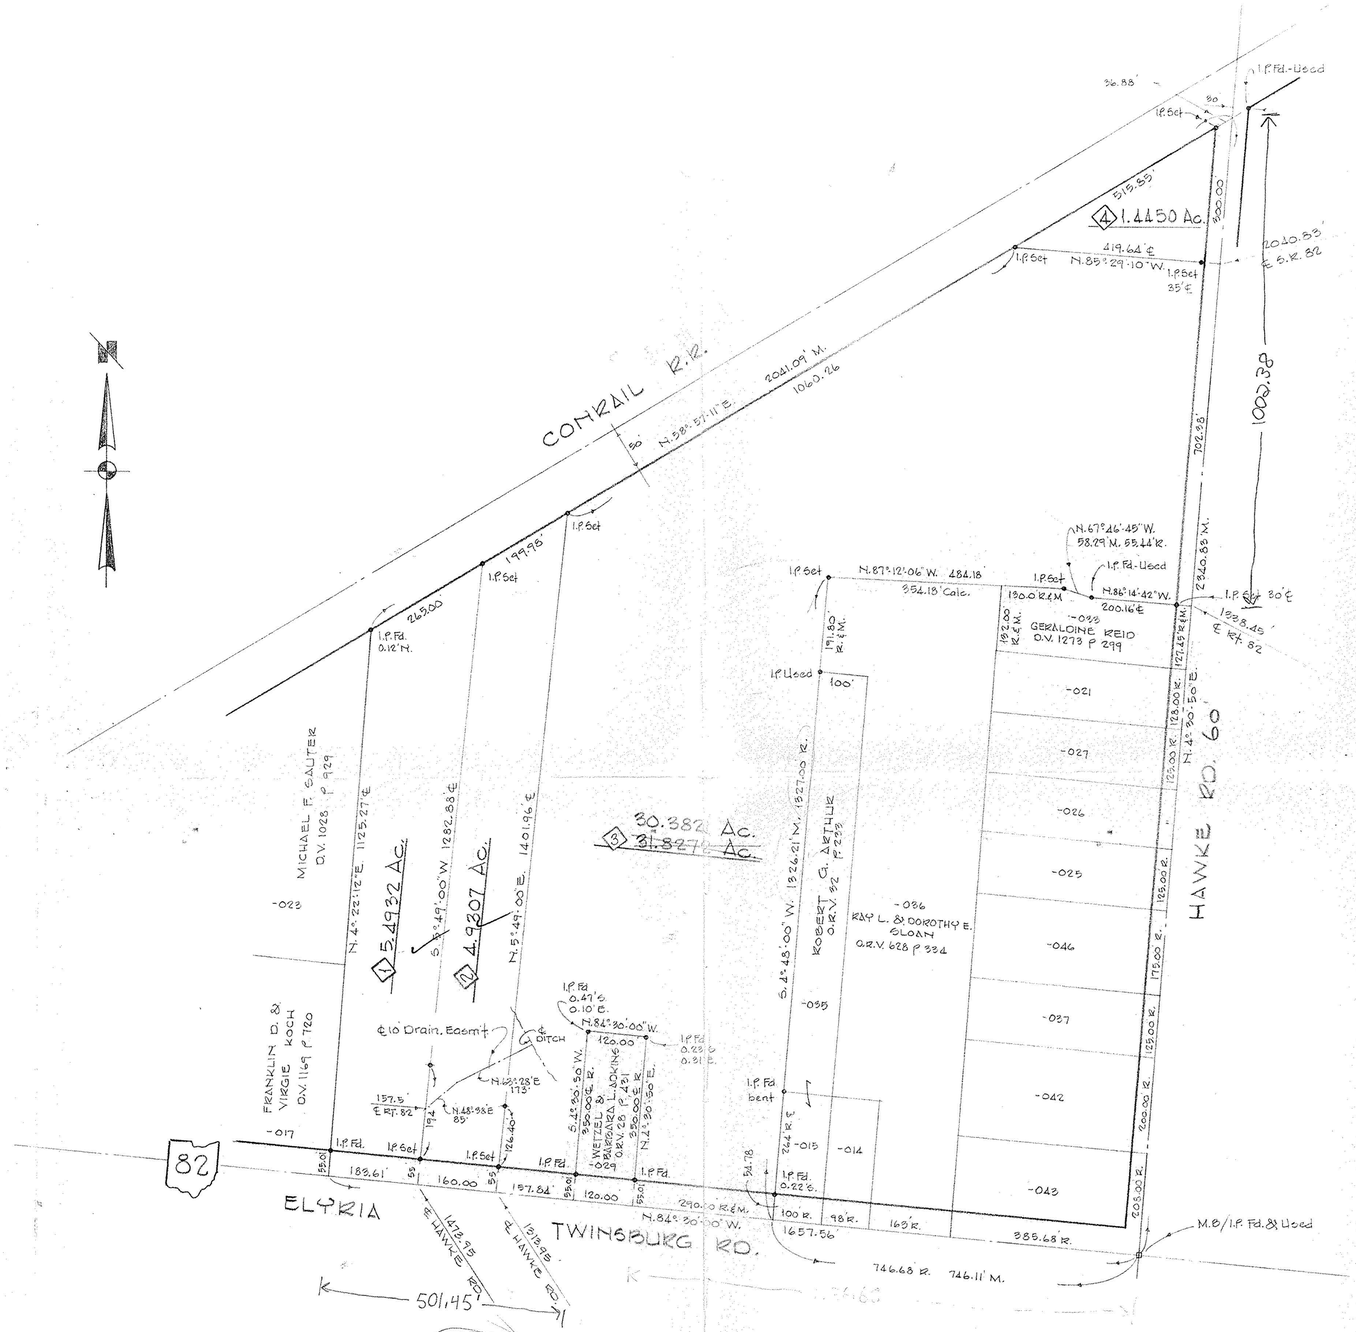

SURVEY FOR

CHRIS A. HAWKE - TRUSTEE

PART OF O.L. 6 TOWNSHIP OF EATON COUNTY OF LORAIN STATE OF OHIO

SCALE 1"=150' OCTOBER, 1995

LAUNDON • SIMON • CAHL & ASSOC.
LAND SURVEYORS
110 MIDDLE AVE.
ELYRIA, O. 44035

JOB No 95-2744
F.B. 235 P. 60, 61, 71 & 72

STATE OF OHIO
RODGER G. SIMON
5101
REGISTERED SURVEYOR

REV. 2-12-96 Add Pcl. No 4 Rev. acreage Pcl. No 3 R.G.S.
REV. 11-06-95 Add 10 Septic Drain Easem't. R.G.S.