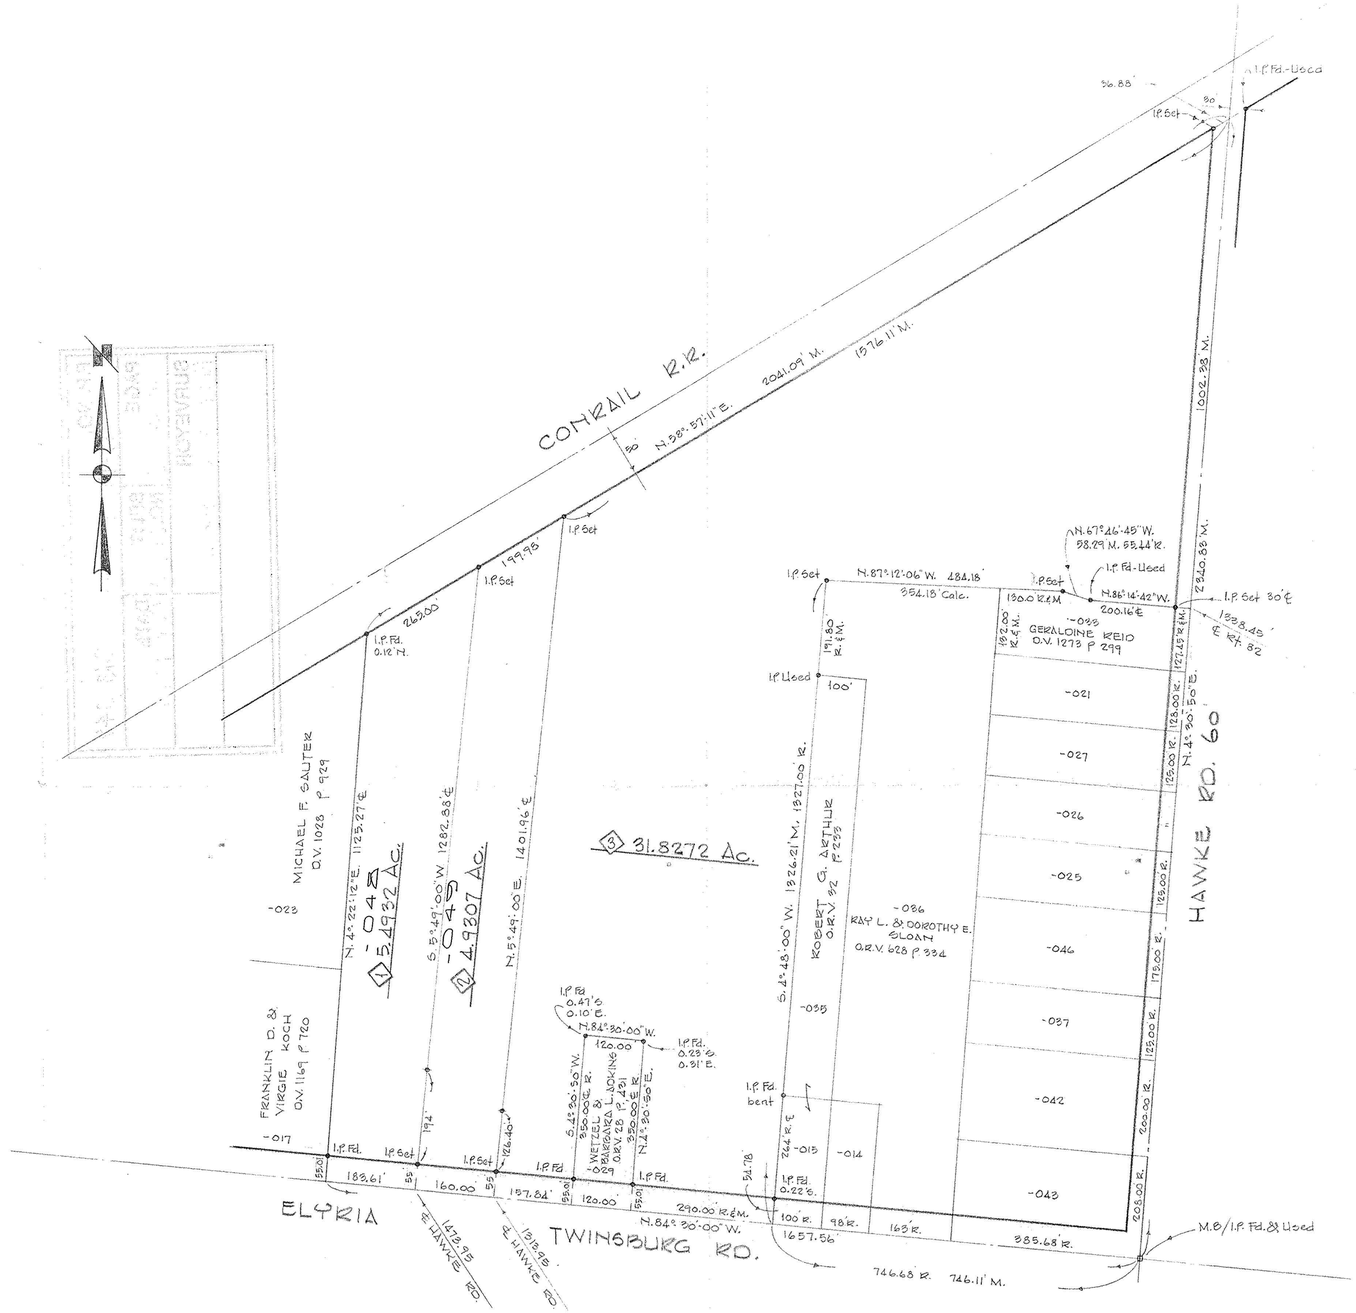

11-00-006-000

21570

APPROVED
LORAIN CO.
MAP DEPT

DATE 11-29-95

PAGE 11-00-006-B

BY CAROLYN FRANCIS

21570

STATE OF OHIO
RODGER G. SIMON
5101
REGISTERED SURVEYOR

SURVEY FOR

CHRIS M. HAWKE - TRUSTEE

PART OF O.L. 6 TOWNSHIP OF EATON COUNTY OF LORAIN STATE OF OHIO

SCALE 1"=150' OCTOBER, 1995

LAUNDON • SIMON • CAHL & ASSOC.
LAND SURVEYORS
110 MIDDLE AVE.
ELYRIA, O. 44035

JOB No. 95-2744
FB 233 P. 60, 61, 71 & 72