11-00-007-000-
8-7005-00-11

PLAT OF SURVEY

for
RICHARD A. AND SIGRID T. LOWE

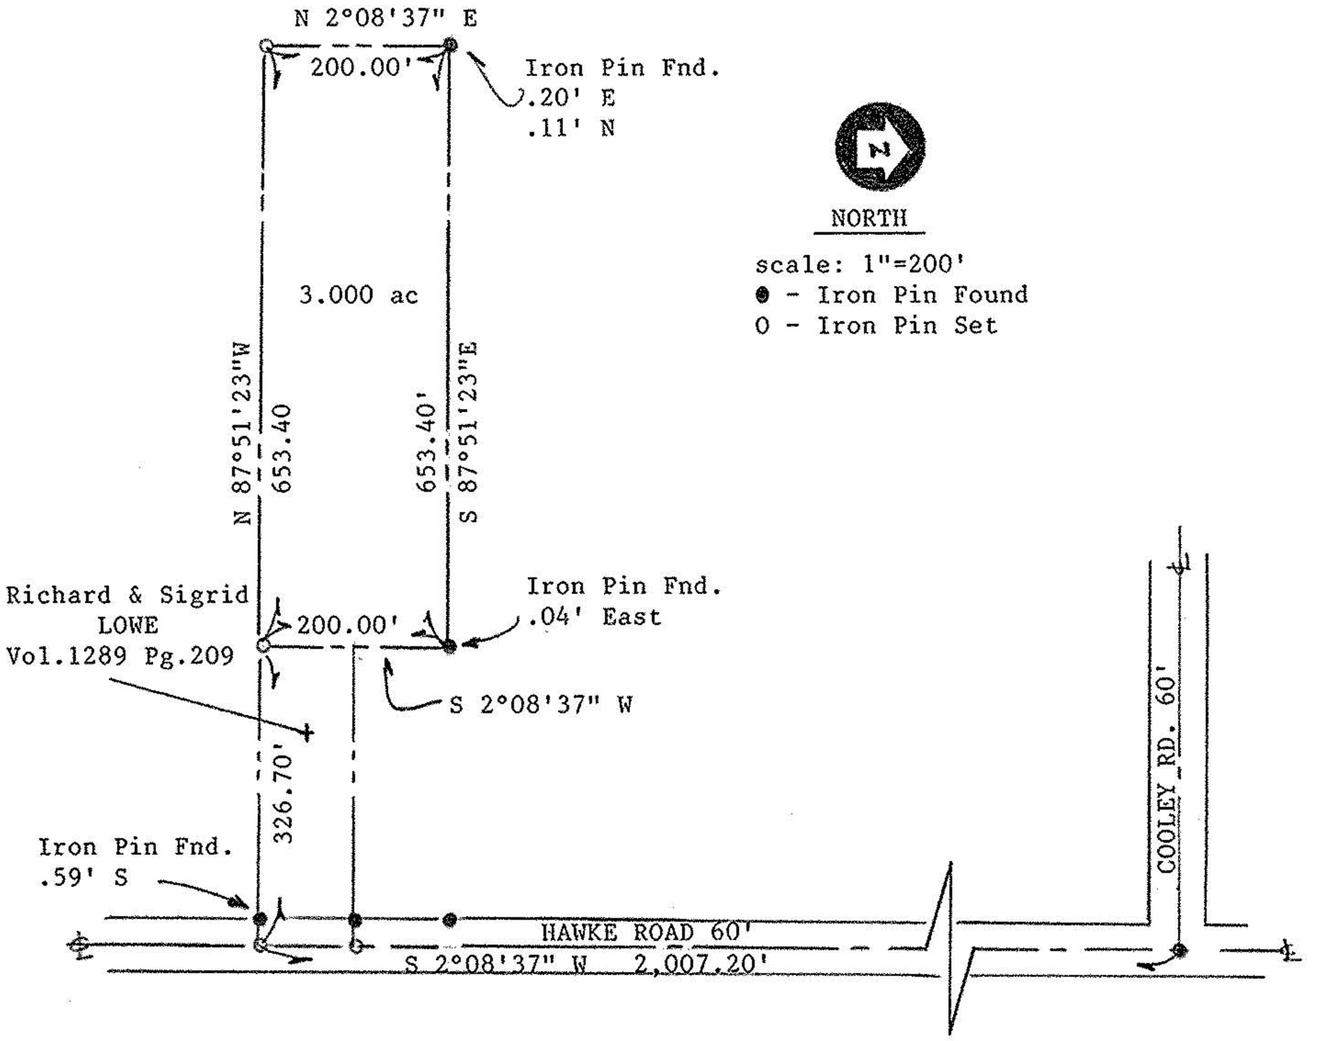

LEGAL DESCRIPTION

Situated in the township of Eaton, county of Lorain, and state of Ohio; and Being part of Org. Eaton Township Lot #7, Bounded and described as Follows:

Beginning at an iron pin found at the intersection of Cooley Rd.(60' wide) and Hawke Rd.(60' wide); thence S 2°08'37" W, along the centerline of said Hawke Rd., 2,007.20' to an iron pin set at the S.E. Cor. of Richard A. & Sigrid T. Lowe parcel as recorded in Lorain County Deed Records vol.1289 pg.209; thence N 87°51'23" W, along the southerly line of said Lowe's parcel, 326.70' to an iron pin set, said point also being the principal place of beginning:

1.) thence continueing N 87°51'23" W, 653.40' to an iron pin set;
2.) thence N 2°08'37" E, 200.00' to an iron pin found;
3.) thence S 87°51'23" E, 653.40' to an iron pin found;
4.) thence S 2°08'37" W, 200.00' to an iron pin set and the principal place of beginning, containing 3.00 acres of land

I hereby certify that this survey is correct to the best of my knowledge and belief.
Performed by me on November 17, 1987.

Randall W. Keller, P.S. #7005
State of Ohio

STATE OF OHIO
RANDALL W. KELLER
S-7005
REGISTERED PROFESSIONAL SURVEYOR

APPROVED
LORAIN CO.
MAP DEPT.
DATE
PAGE
BY
VOID AFTER

#17834
APPROVED
LORAIN CO.
MAP DEPT.
DATE 1-26-88
PAGE 11-00-007-8
BY Carol-Frances
VOID AFTER #17834

11-00-007-8
11-00-007-000