11-00-007-000-
11-00-014-000

11-00-014-B
11-00-007-A

11-00-007-A
11-00-014-B

MICHAEL F SAUTER

SITUATED IN THE TOWNSHIP OF EATON, COUNTY OF LOR AND STATE OF OHIO AND KNOWN AS BEING PART OF ORIGINAL EATON TOWNSHIP LOT NO. 14.

SCALE: 1" = 60' NOVEMBER 28, 1975

PREPARED BY:

PAUL A. FRANK & ASSOCIATES, INC.
ENGINEERING AND PLANNING CONSULTANTS
6315 PEARL ROAD PARMA HEIGHTS, OHIO 44130

CERTIFICATION

MONUMENTS WERE SET OR FOUND AS INDICATED HEREON DIMENSIONS ARE EXPRESSED IN FEET AND DECIMAL PARTS THEREOF. ALL OF WHICH I CERTIFY TO BE CORRECT.

Paul A. Frank

PAUL A FRANK REG OHIO SUR NO 4535

STATE OF OHIO
PAUL A. FRANK
4535
REGISTERED
PROFESSIONAL SURVEYOR

APR 27 1977

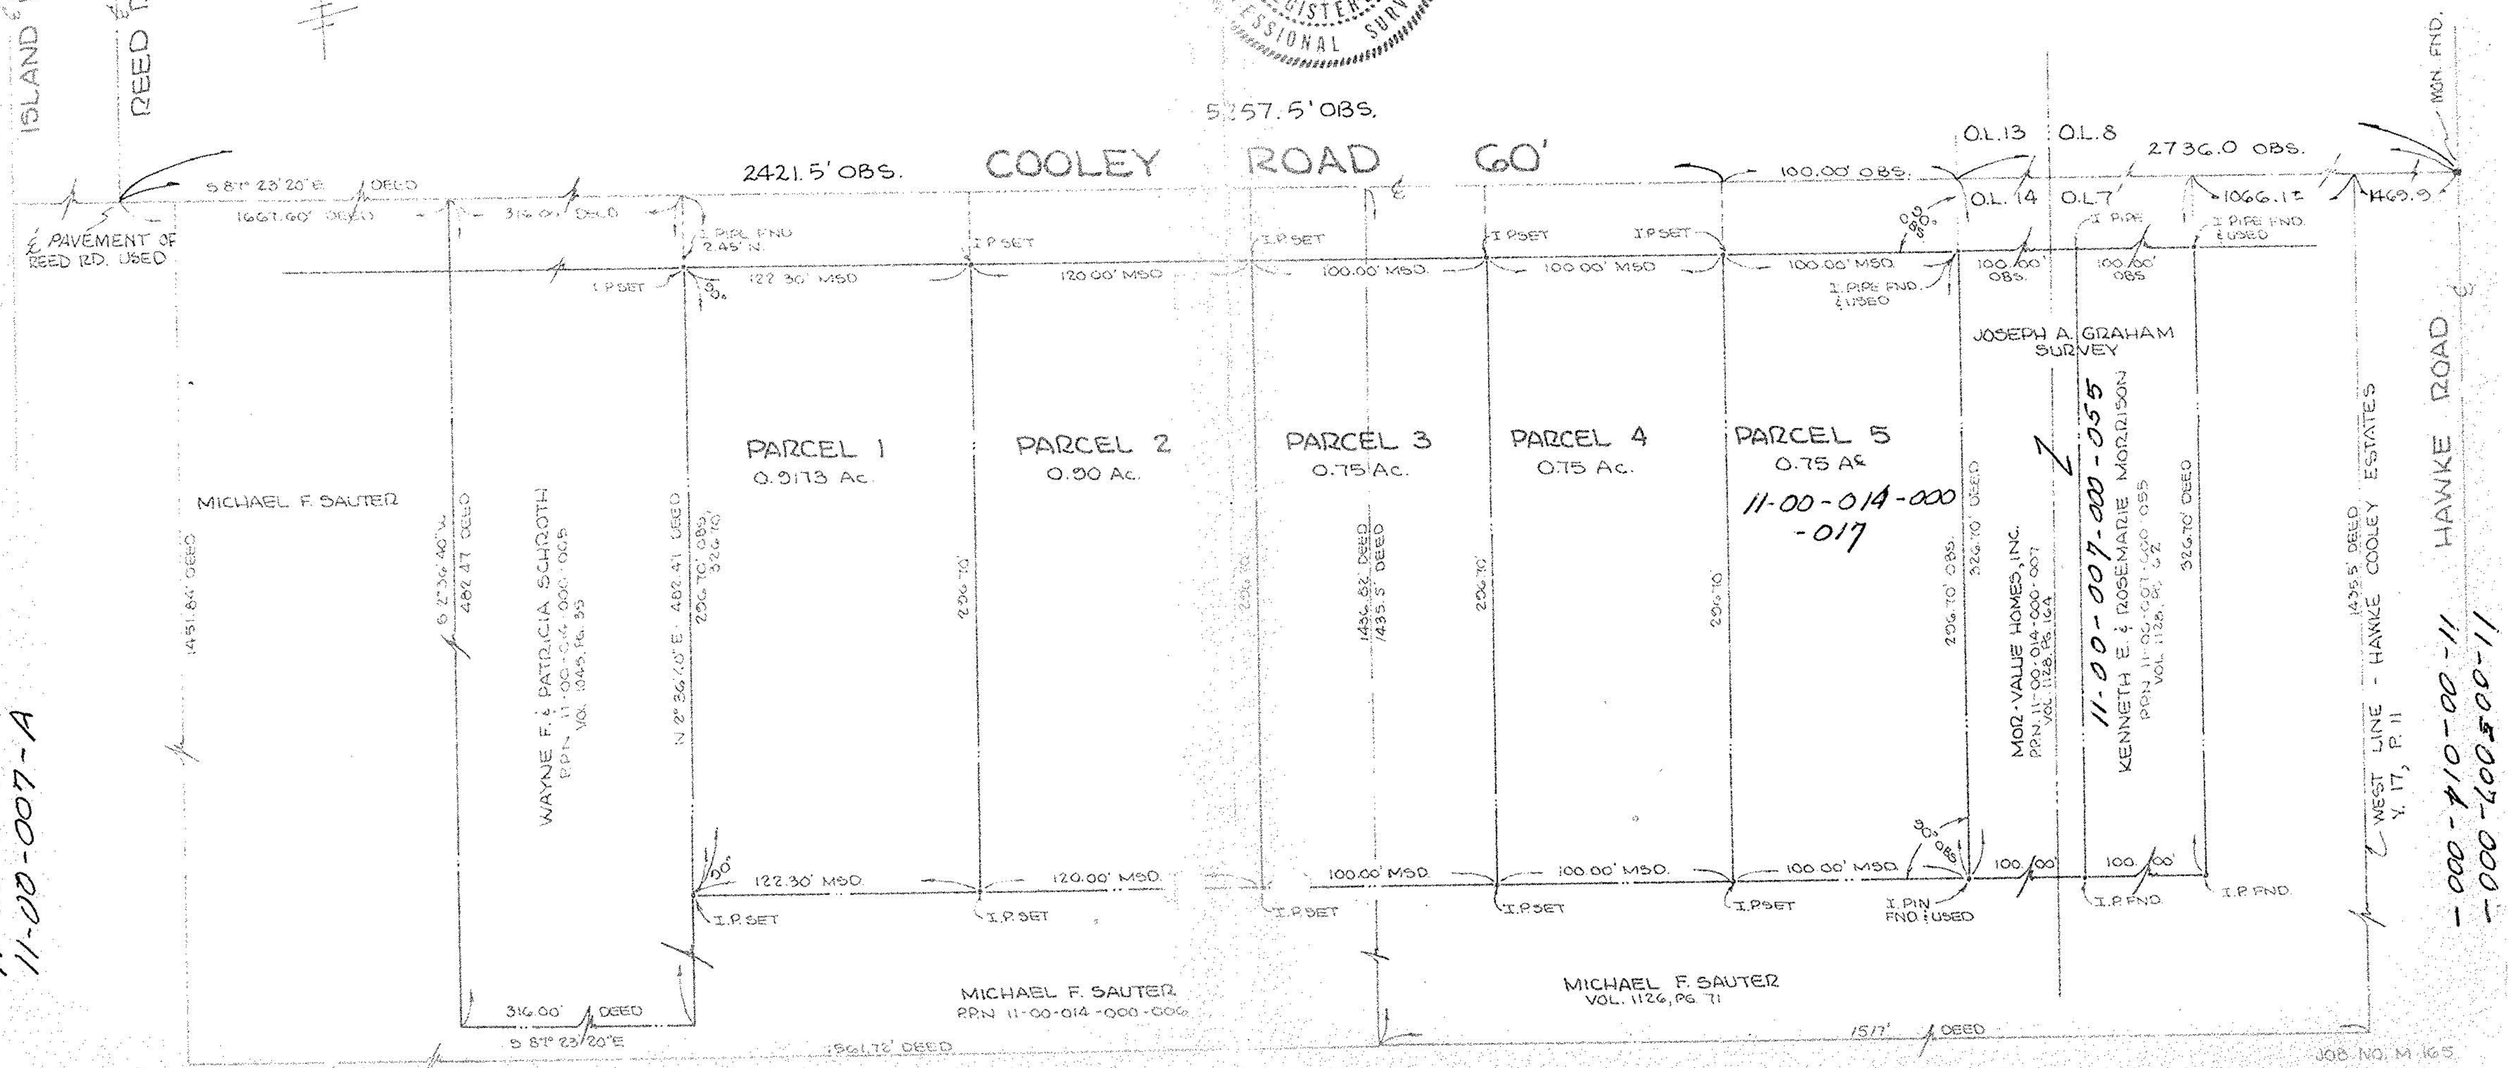

11-00-014-B
11-00-007-A

11-00-007-000-
11-00-014-000

JOB NO. M 165
REVISED: 4/14/77