19662
APPROVED
LORAIN CO.
MAP DEPT.
TYPE-INK-13
PLASTIC & PAPER
BY: PAK-KS
DATE: 1994-2

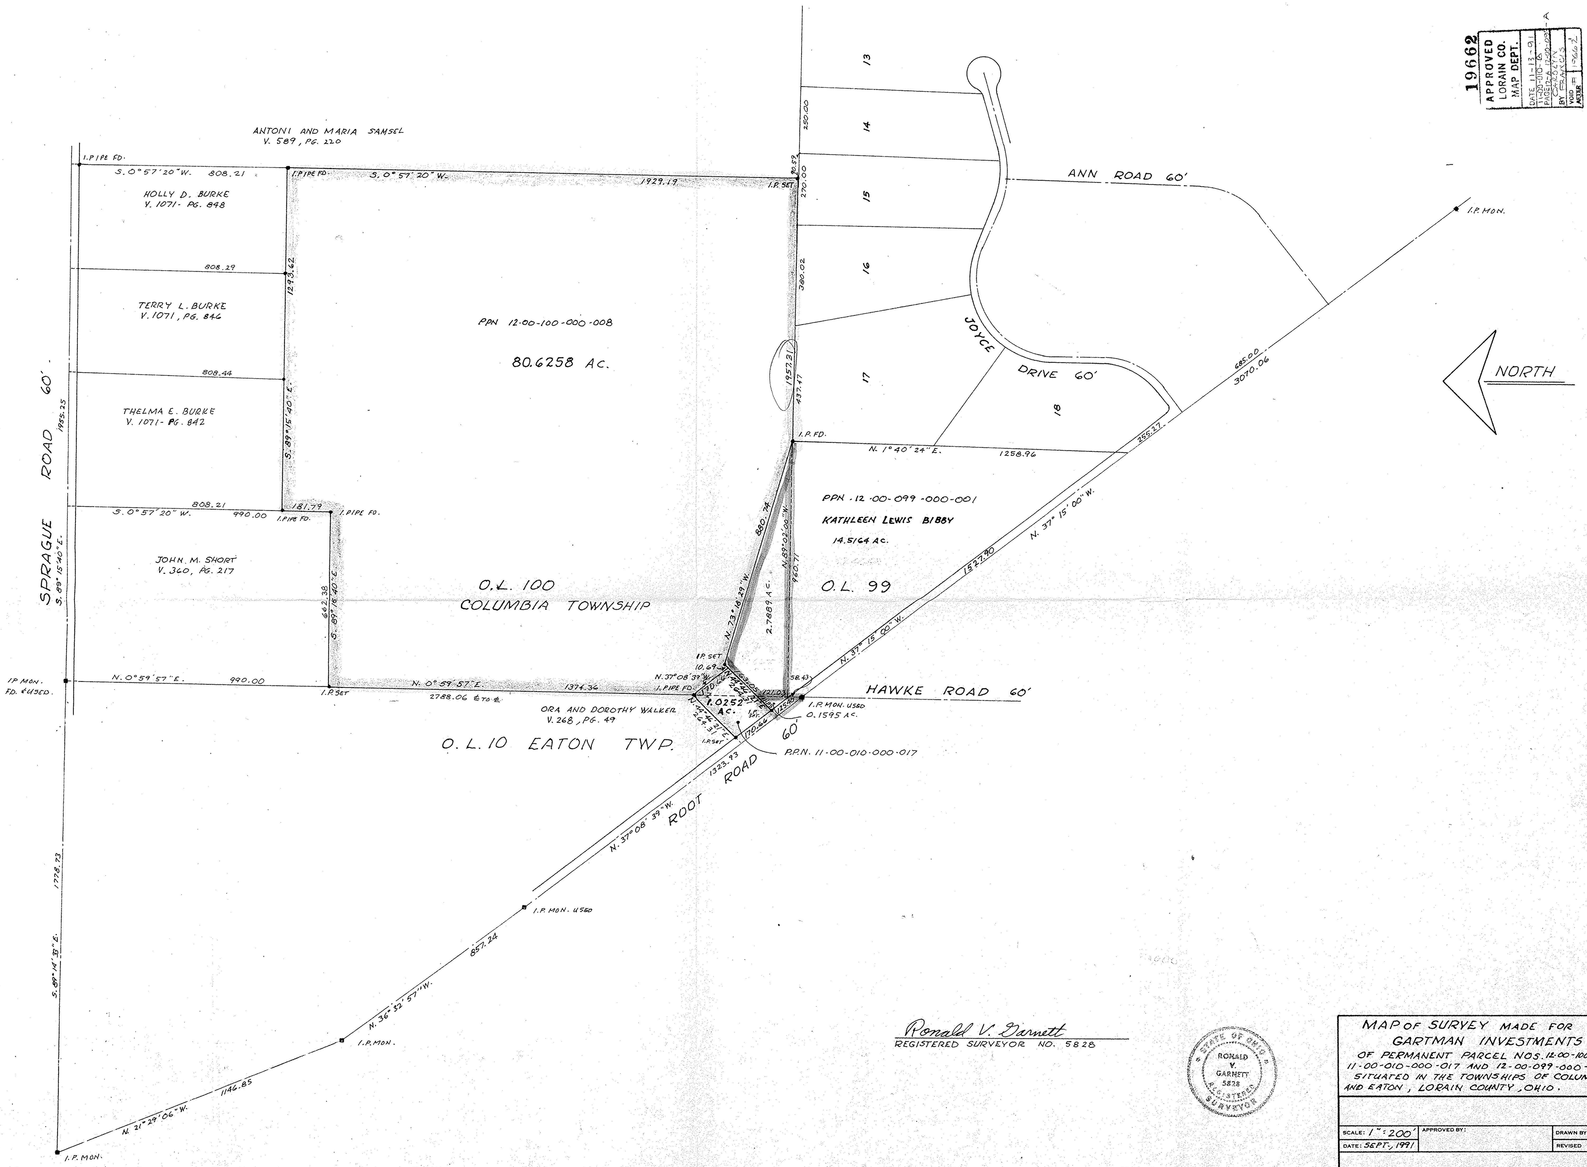

Ronald V. Garnett
REGISTERED SURVEYOR NO. 5828

STATE OF OHIO
RONALD V. GARNETT
5828
REGISTERED SURVEYOR

MAP OF SURVEY MADE FOR
GARTMAN INVESTMENTS
OF PERMANENT PARCEL NOS. 11-00-100-000-008
11-00-010-000-017 AND 12-00-099-000-001
SITUATED IN THE TOWNSHIPS OF COLUMBIA
AND EATON, LORAIN COUNTY, OHIO.

SCALE: 1" = 200'	APPROVED BY:	DRAWN BY RVG.
DATE: SEPT., 1991		REVISED
		DRAWING NUMBER

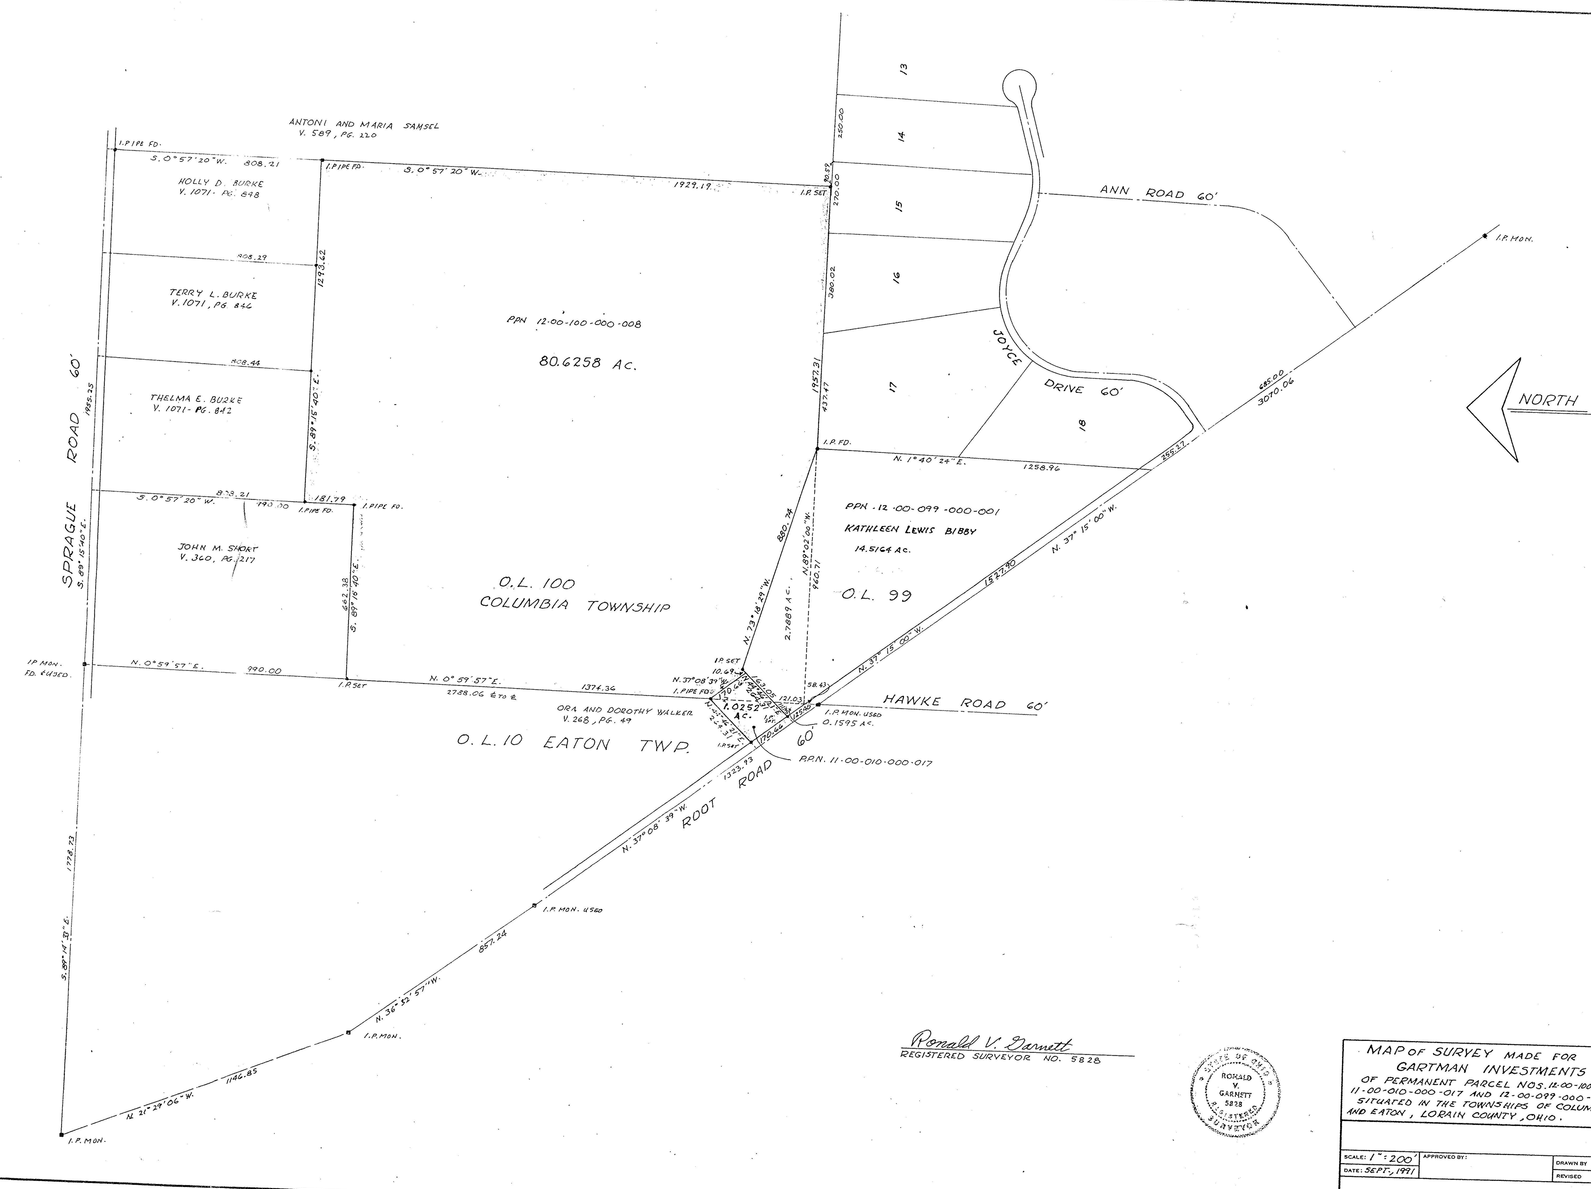

Ronald V. Garnett
REGISTERED SURVEYOR NO. 5828

STATE OF OHIO
RONALD V. GARNETT
5828
REGISTERED SURVEYOR

MAP OF SURVEY MADE FOR
GARTMAN INVESTMENTS
OF PERMANENT PARCEL NOS. 11-00-100-000-008
11-00-010-000-017 AND 12-00-099-000-001
SITUATED IN THE TOWNSHIPS OF COLUMBIA
AND EATON, LORAIN COUNTY, OHIO.

SCALE: 1" = 200'	APPROVED BY:	DRAWN BY RVG.
DATE: SEPT., 1991		REVISED
		DRAWING NUMBER