PREPARED FOR:
MR. CARMINE CICCOTOSTO

30 0 30 90

Scale 1" = 30 ft

File name: C:/95123/DWG/95123

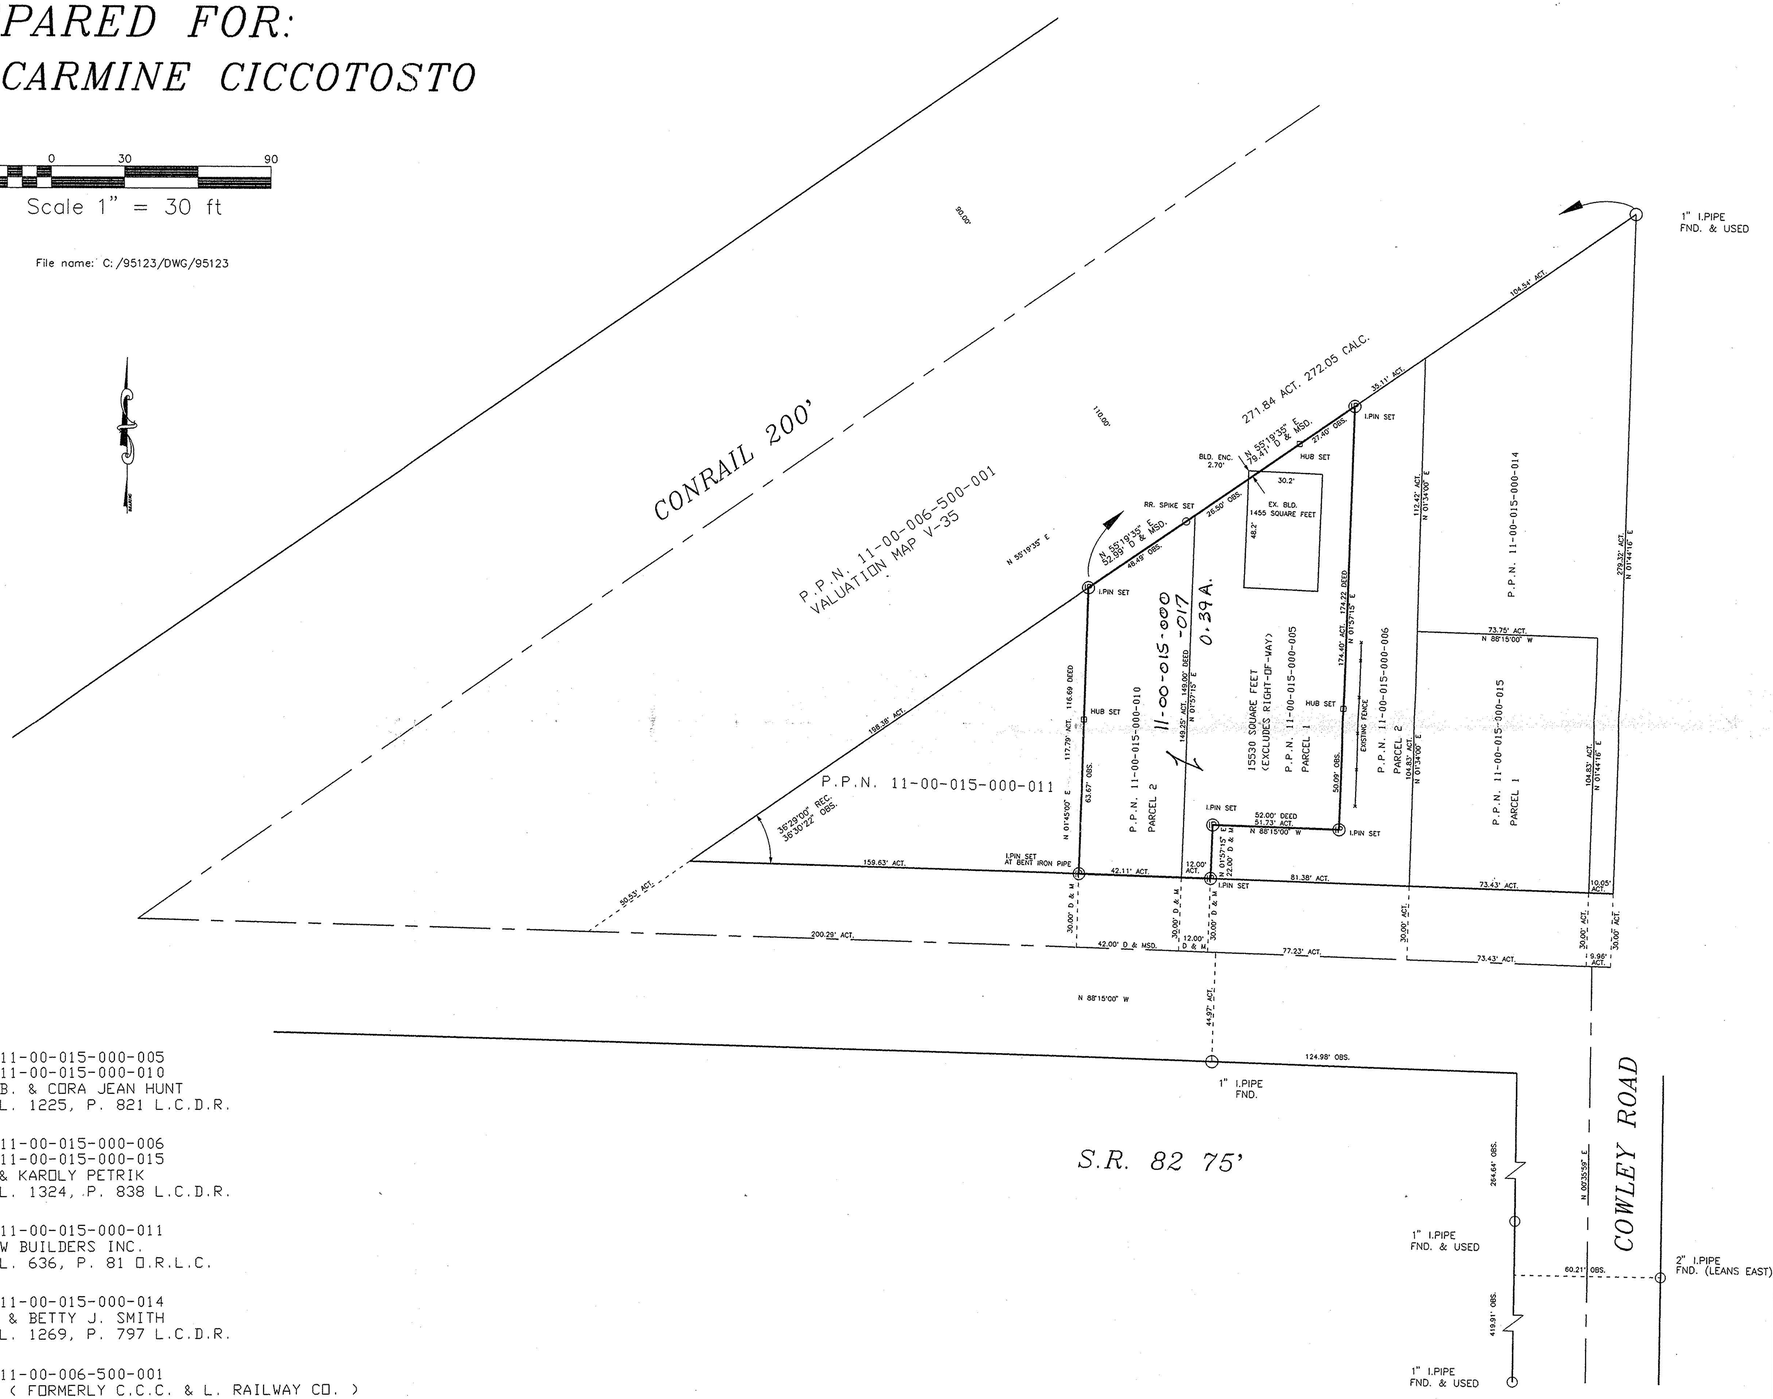

P.P.N. 11-00-015-000-005
P.P.N. 11-00-015-000-010
THOMAS B. & CORA JEAN HUNT
DEED VOL. 1225, P. 821 L.C.D.R.

P.P.N. 11-00-015-000-006
P.P.N. 11-00-015-000-015
JOSEPH & KAROLY PETRIK
DEED VOL. 1324, P. 838 L.C.D.R.

P.P.N. 11-00-015-000-011
LONGVIEW BUILDERS INC.
DEED VOL. 636, P. 81 O.R.L.C.

P.P.N. 11-00-015-000-014
RAYMOND & BETTY J. SMITH
DEED VOL. 1269, P. 797 L.C.D.R.

P.P.N. 11-00-006-500-001
CONRAIL (FORMERLY C.C.C. & L. RAILWAY CO.)
DEED VOL. 38, P. 62 L.C.D.R.

#21743

APPROVED
LORAIN CO.
MAP DEPT.
DATE 4-23-96
PAGE 11-00-015-B
BY
VOID AFTER 21743

DISTANCES ARE SHOWN IN FEET AND DECIMAL PARTS THEREOF.

BEARINGS ARE BASED ON AN ASSUMED MERIDIAN AND ARE INTENDED TO INDICATE ANGLES ONLY.

I HEREBY STATE THIS TO BE A TRUE AND ACCURATE SURVEY TO THE BEST OF MY KNOWLEDGE, INFORMATION AND BELIEF.

STATE OF OHIO
DANIEL LAUX 7087
REGISTERED PROFESSIONAL SURVEYOR

BOUNDARY SURVEY

Situated in the Township of Eaton, County of Lorain and State of Ohio and being part of Original Eaton Township Lot 15

Scale: 1"=30' September 7, 1995

Work Order 95123 SHEET 1 OF 1

ZARANEC & LAUX, INC. PROFESSIONAL LAND SURVEYORS 12573 CHILLICOTHE ROAD CHESTERLAND, OHIO (216) 729-1190