THOMAS SIMON & ASSOCIATES, INC.
PROFESSIONAL LAND SURVEYORS

COBBLESTONE CORNER PROFESSIONAL CENTER
39049 CENTER RIDGE ROAD
NORTH RIDGEVILLE, OHIO 44039
(440) 327-2925
FAX 327-2964

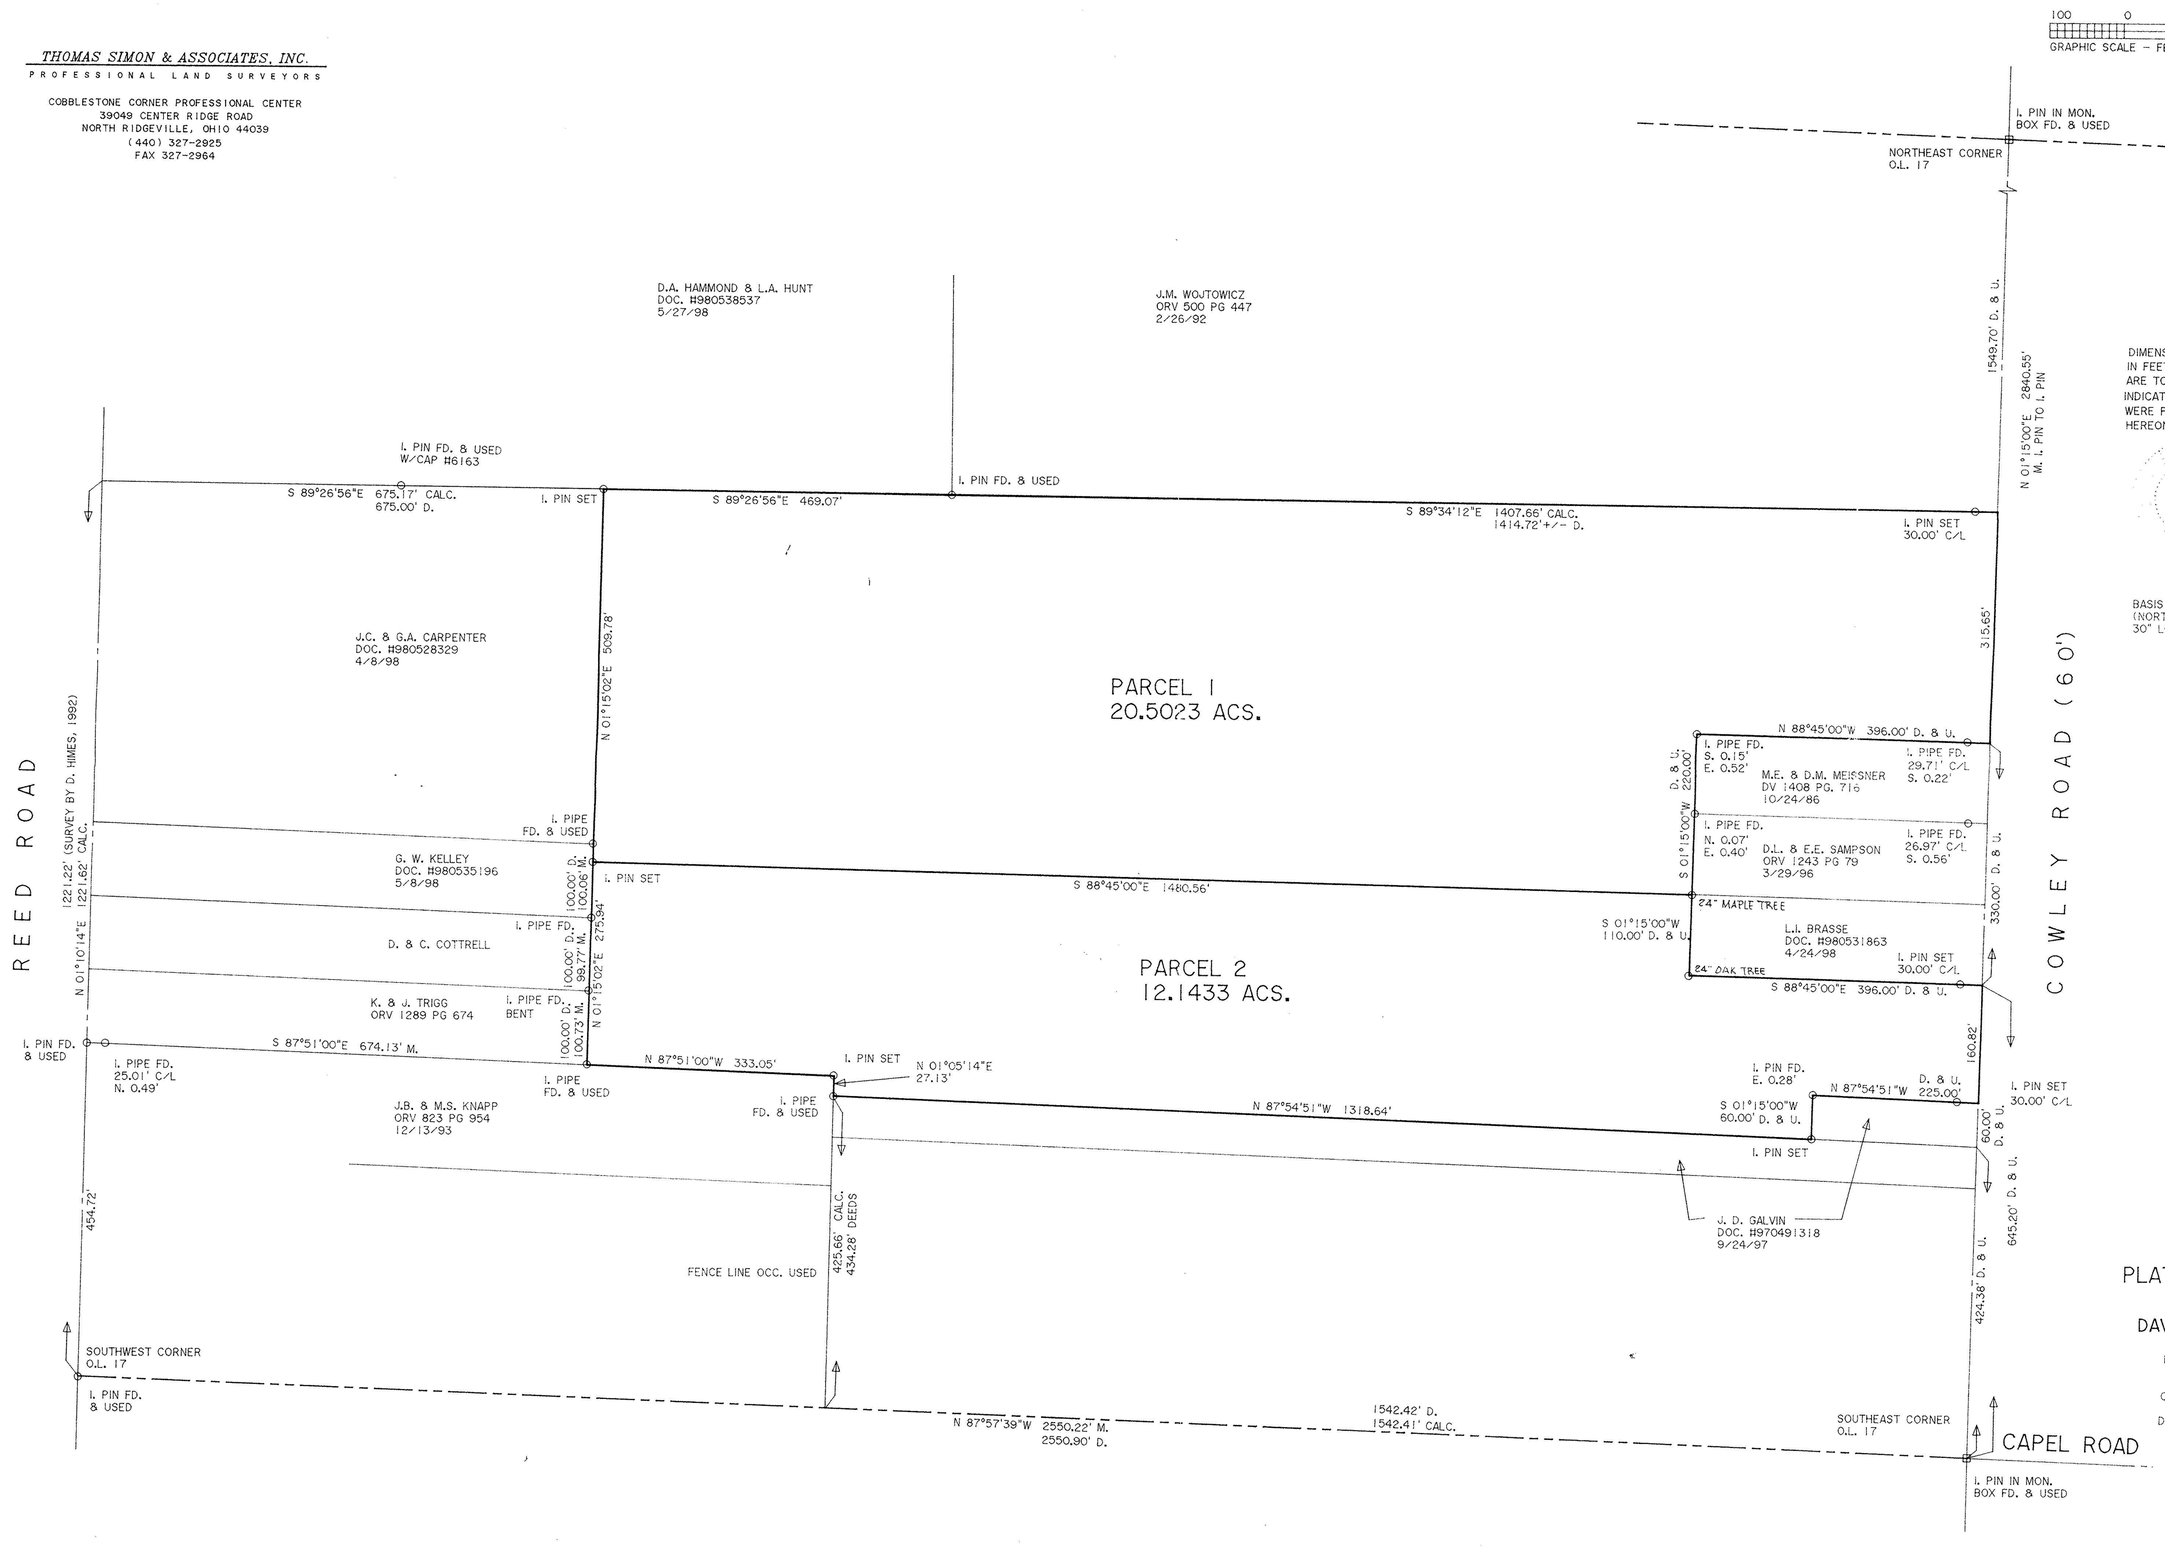

DIMENSIONS SHOWN ON THIS PLAT ARE EXPRESSED IN FEET AND DECIMAL PARTS THEREOF, ALL BEARINGS ARE TO AN ASSUMED MERIDIAN AND ARE USED TO INDICATE ANGLES ONLY. PERMANENT MONUMENTS WERE FOUND OR SET AT ALL POINTS INDICATED HEREON, ALL OF WHICH I CERTIFY TO BE CORRECT.

THOMAS A. SIMON
REG. PROFESSIONAL SURVEYOR
NO. S-7775

BASIS OF BEARINGS IS THE CENTERLINE OF COWLEY ROAD (NORTH 01°15'00" EAST). IRON PINS SET ARE 5/8" DIA. 30" LONG WITH PLASTIC CAPS "T. SIMON, S-7775".

00681
APPROVED
DATE 3-5-01
PAGE 11-H
BY J HATFIELD
#01-00681

PLAT OF SURVEY & SPLIT
FOR
DAVID L. & EVA E. SAMPSON

BEING KNOWN AS PART OF ORIGINAL EATON TOWNSHIP LOT NO. 17

COUNTY OF LORAIN STATE OF OHIO

DECEMBER, 2000 SCALE: 1" = 100'

JOB NO. 2000-061