11-00-024-000-1

#17526

LAUNDON · SIMON · CAHL & ASSOC. INC.
CONSULTING ENGINEERS & SURVEYORS
219 COURT ST. ELYRIA, OHIO 44035

SURVEY FOR:
ROBERT C. & DEBRA K. CRIGGER

Orig. Lot 24	City of	Date JUNE 2 '87 Scale 1"=200
Orig. Sec	Village of	Dwn. by R G S. Chkd. by C.J.
Tract	County of LORAIN	Job No. 87-1606 F.B.
Township of EATON	State of OHIO	Printed JUN 30 1987

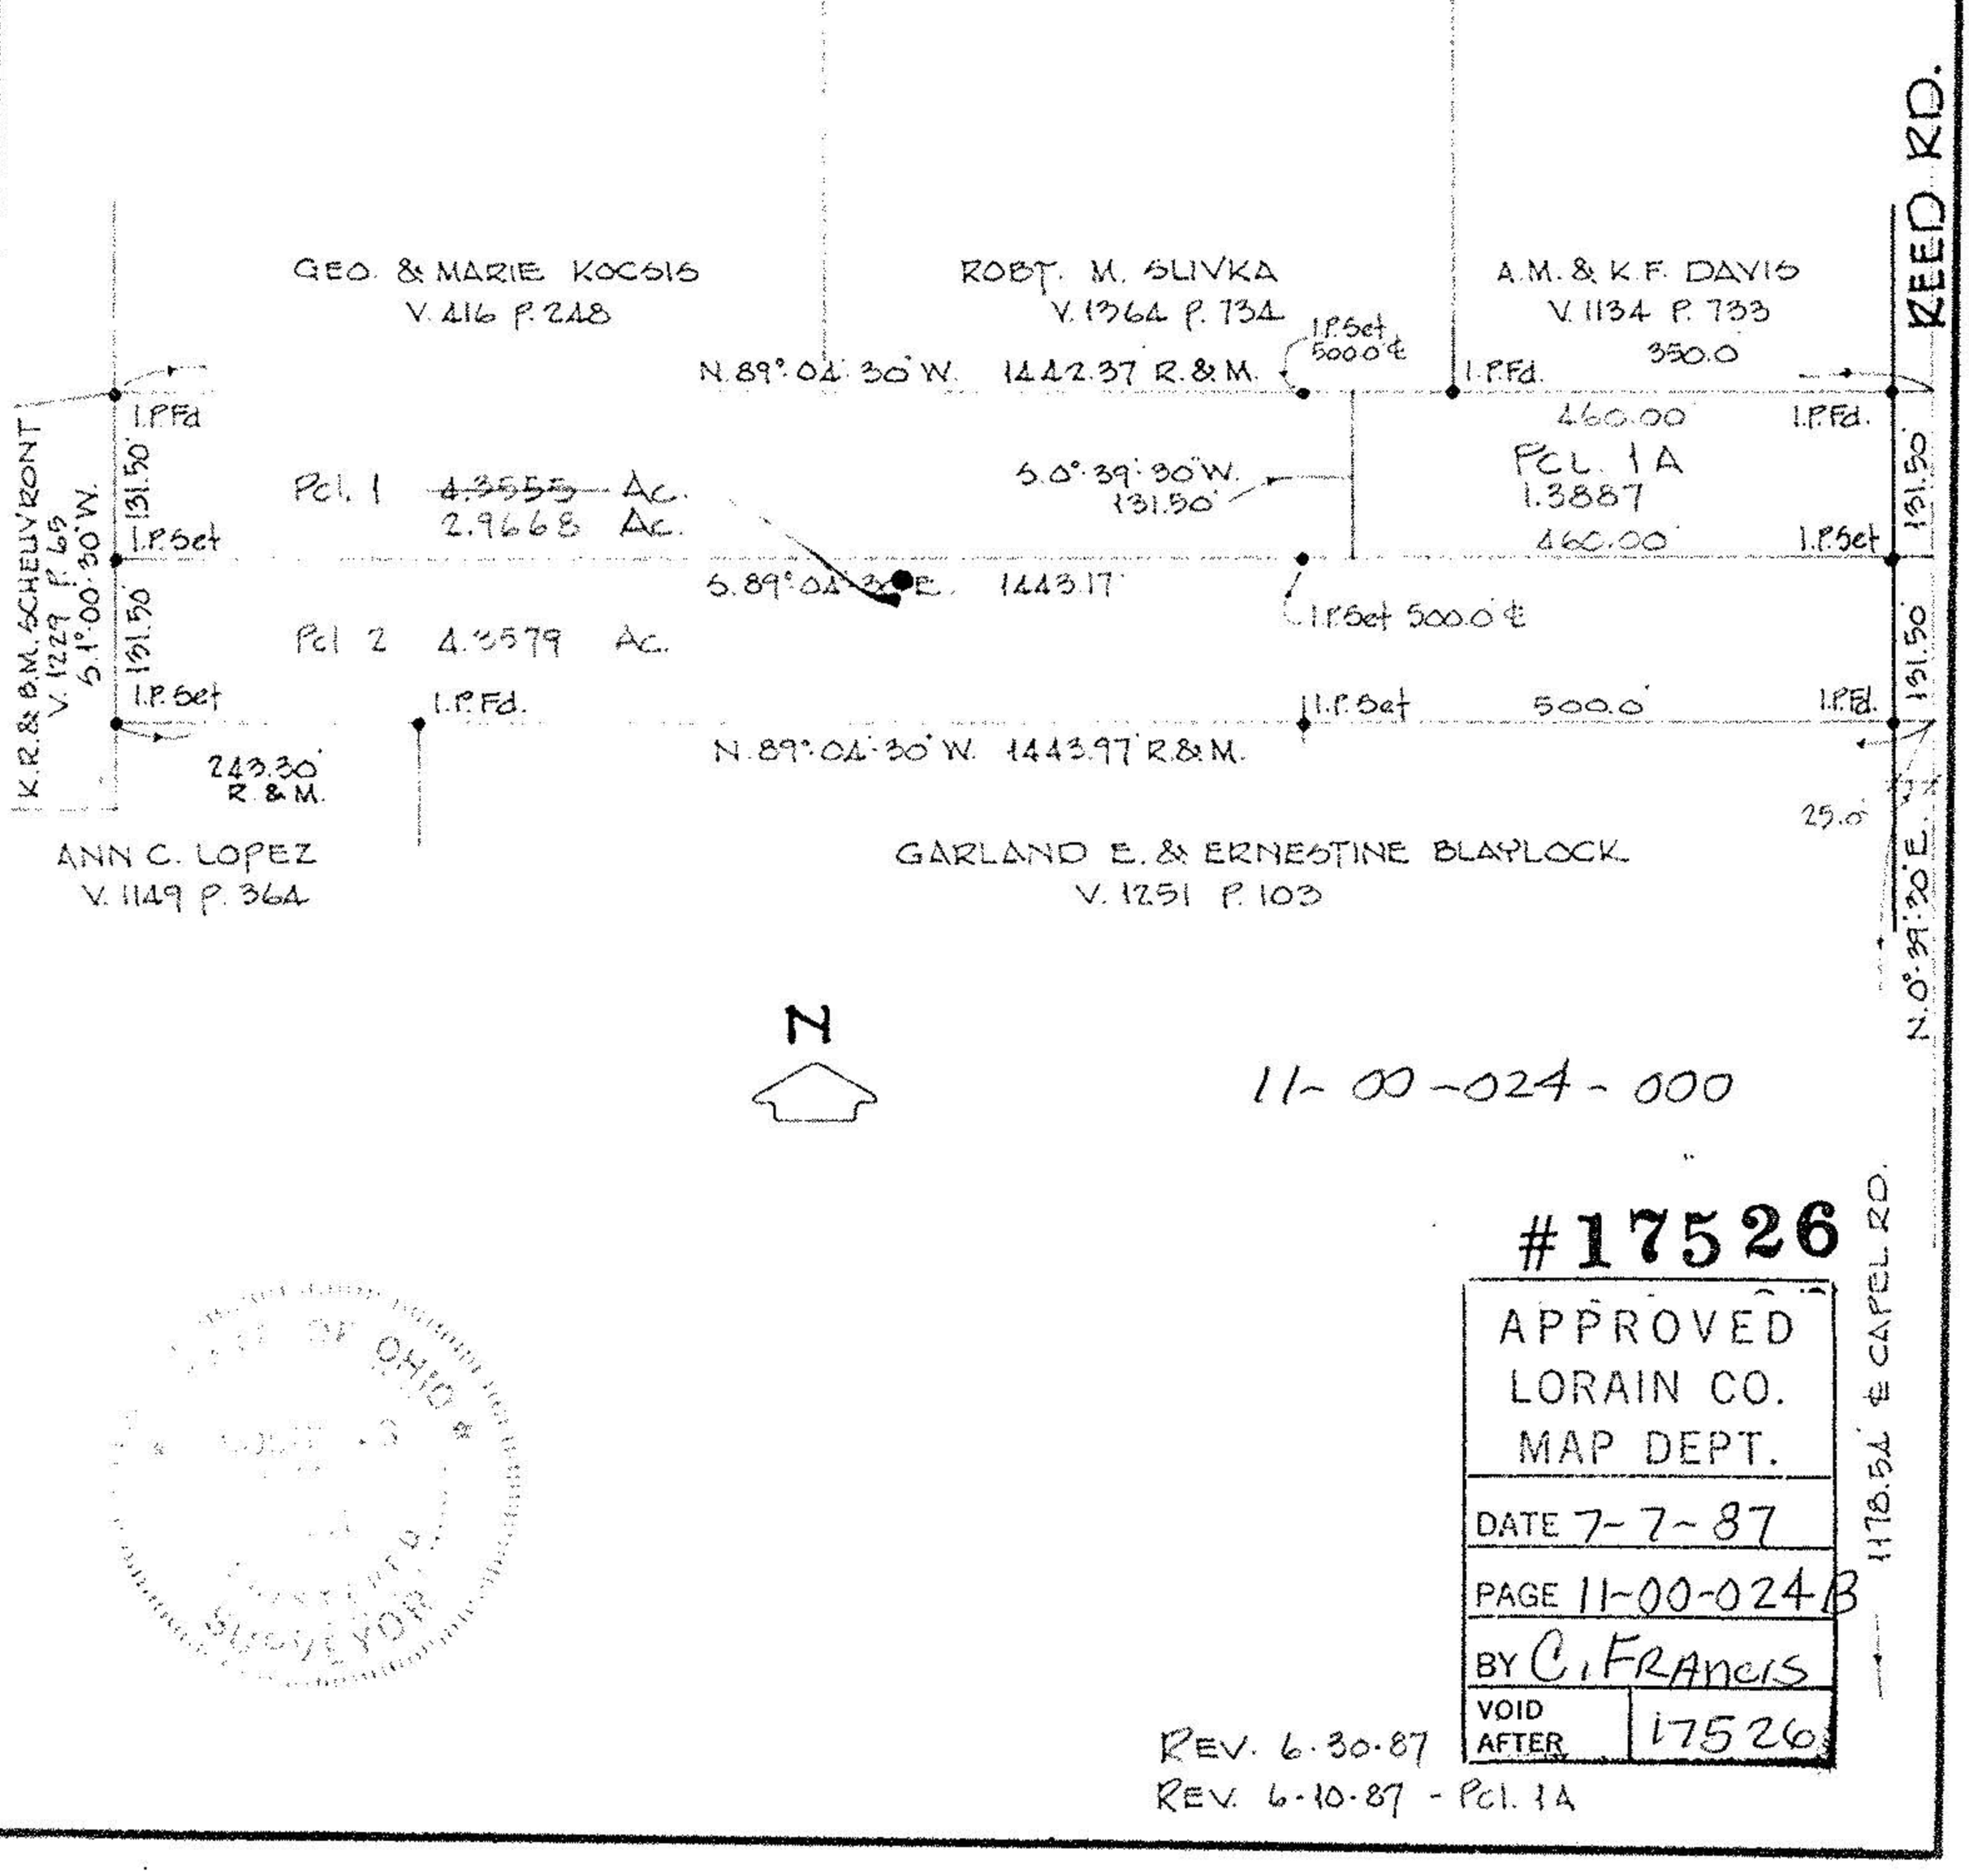

N

11-00-024-000

#17526

APPROVED
LORAIN CO.
MAP DEPT.
DATE 7-7-87
PAGE 11-00-024B
BY C. FRANCIS
VOID AFTER 17526

REV. 6-30-87
REV. 6-10-87 - Pcl. 1A

11-00-024-B