PLAT FOR GARY H. & HAZEL M. PIERCE
PART OF ORIGINAL LOTS 24 & 25
EATON TOWNSHIP, LORAIN COUNTY
STATE OF OHIO

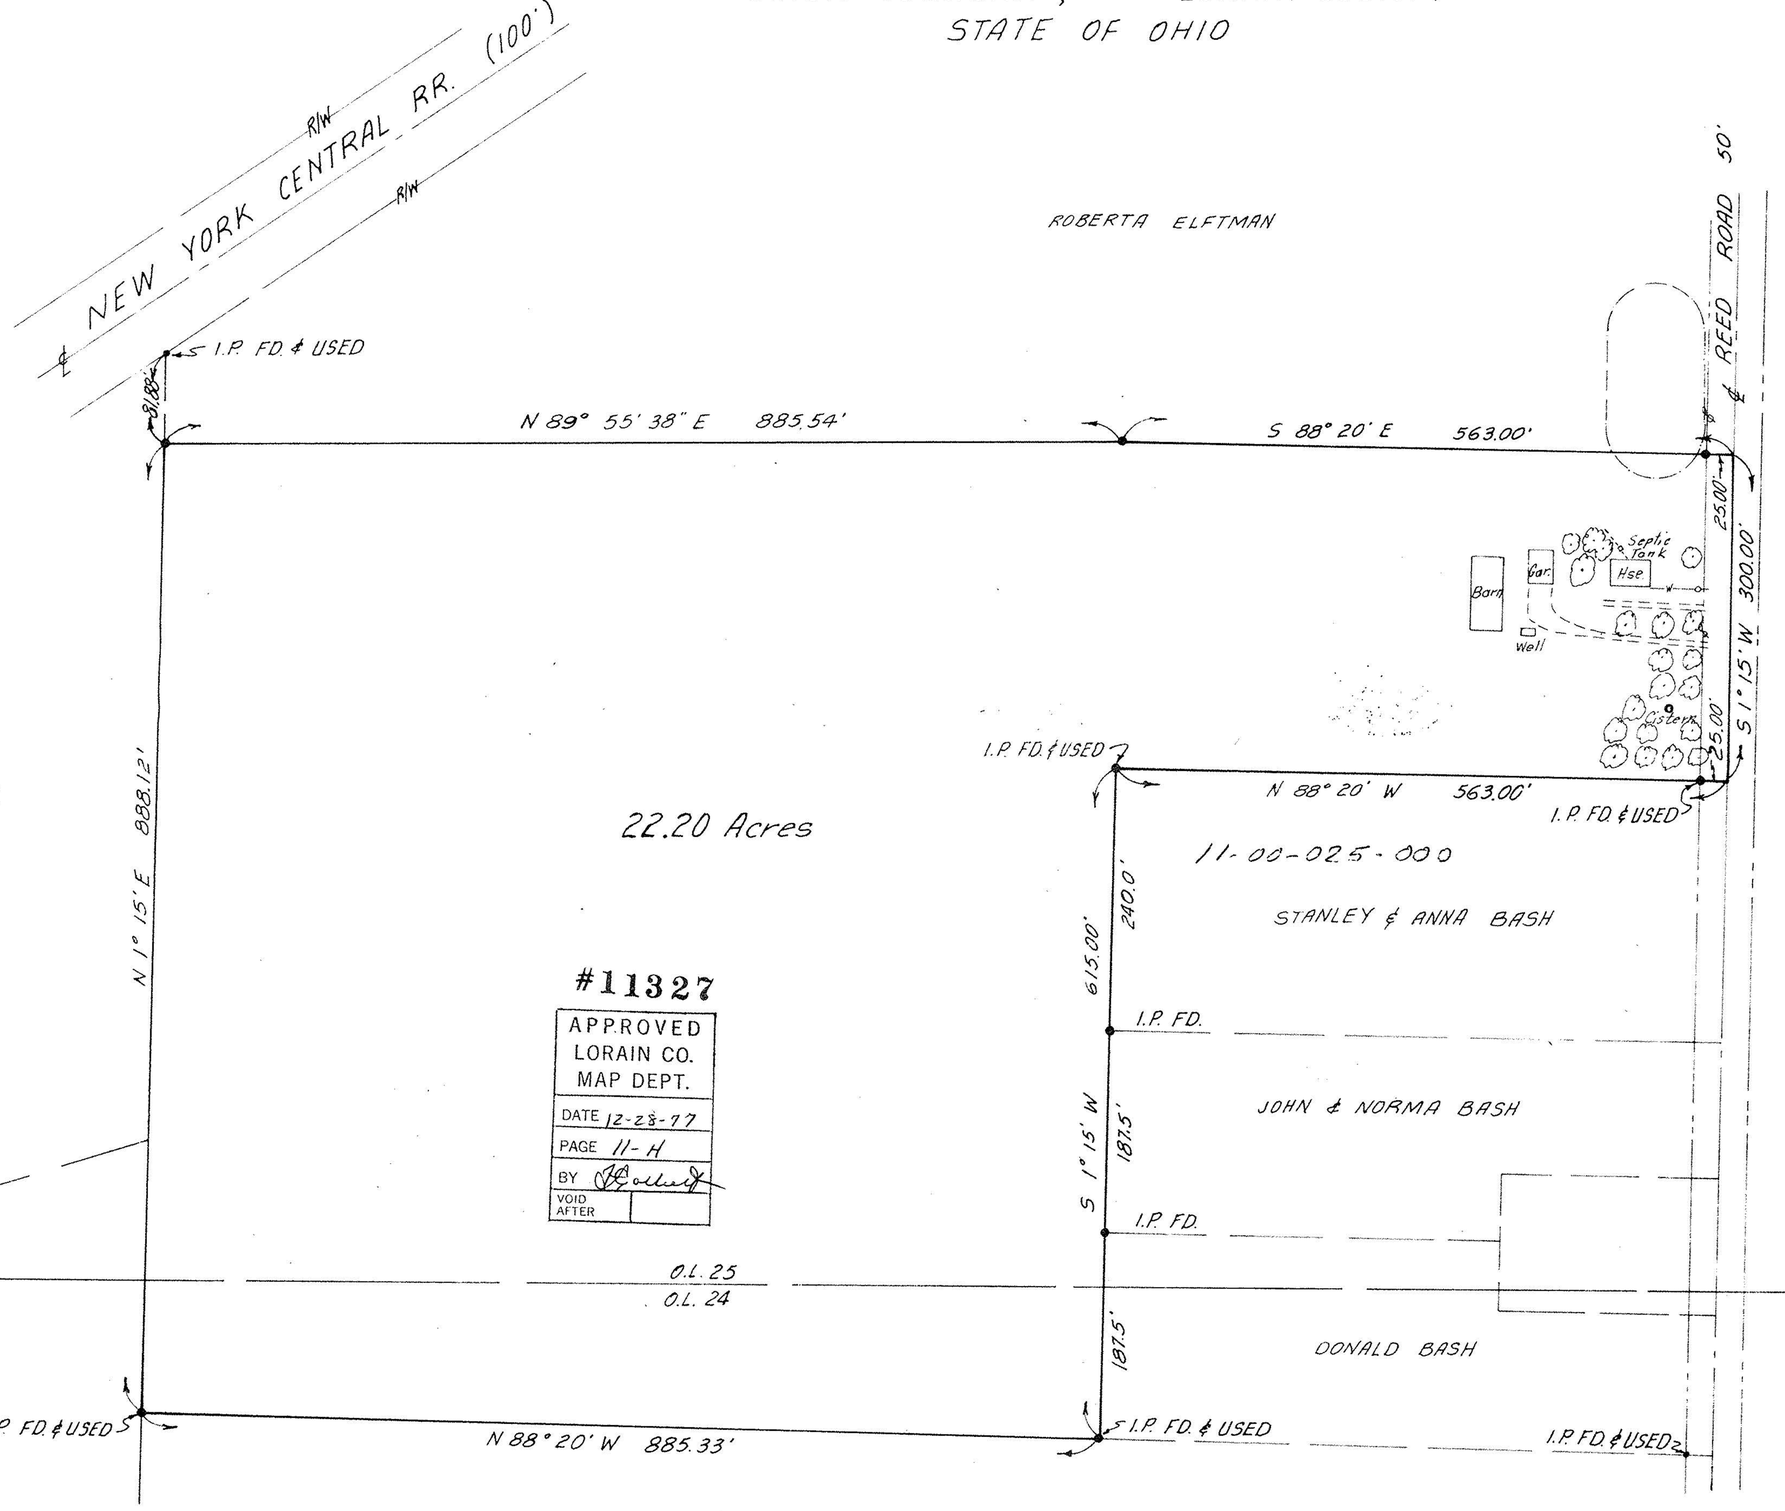

SCALE: 1"=100'

IRON PINS SET OR FOUND AT ALL POINTS INDICATED THUS •. DIMENSIONS ARE EXPRESSED IN FEET AND DECIMAL PARTS THEREOF, ALL OF WHICH I CERTIFY TO BE CORRECT.

Raymond W Hass
RAYMOND W. HASS (S-5152)

#11327

APPROVED LORAIN CO. MAP DEPT.
DATE 12-28-77
PAGE 11-H
BY
VOID AFTER

11-00-024-011-H
025