KLEINOEDER · SCHMIDT and ASSOCIATES

ENGINEERS — SURVEYORS — CONSULTANTS in LAND PLANNING

ELYRIA · NORWALK · MEDINA OHIO

SURVEY

Sublot(s) _____

Subd'n _____

Township EATON

Orig. Lot(s) 50

County of LORAIN

Corporation _____

Tract _____

Sec. _____

State of Ohio

11-00-050

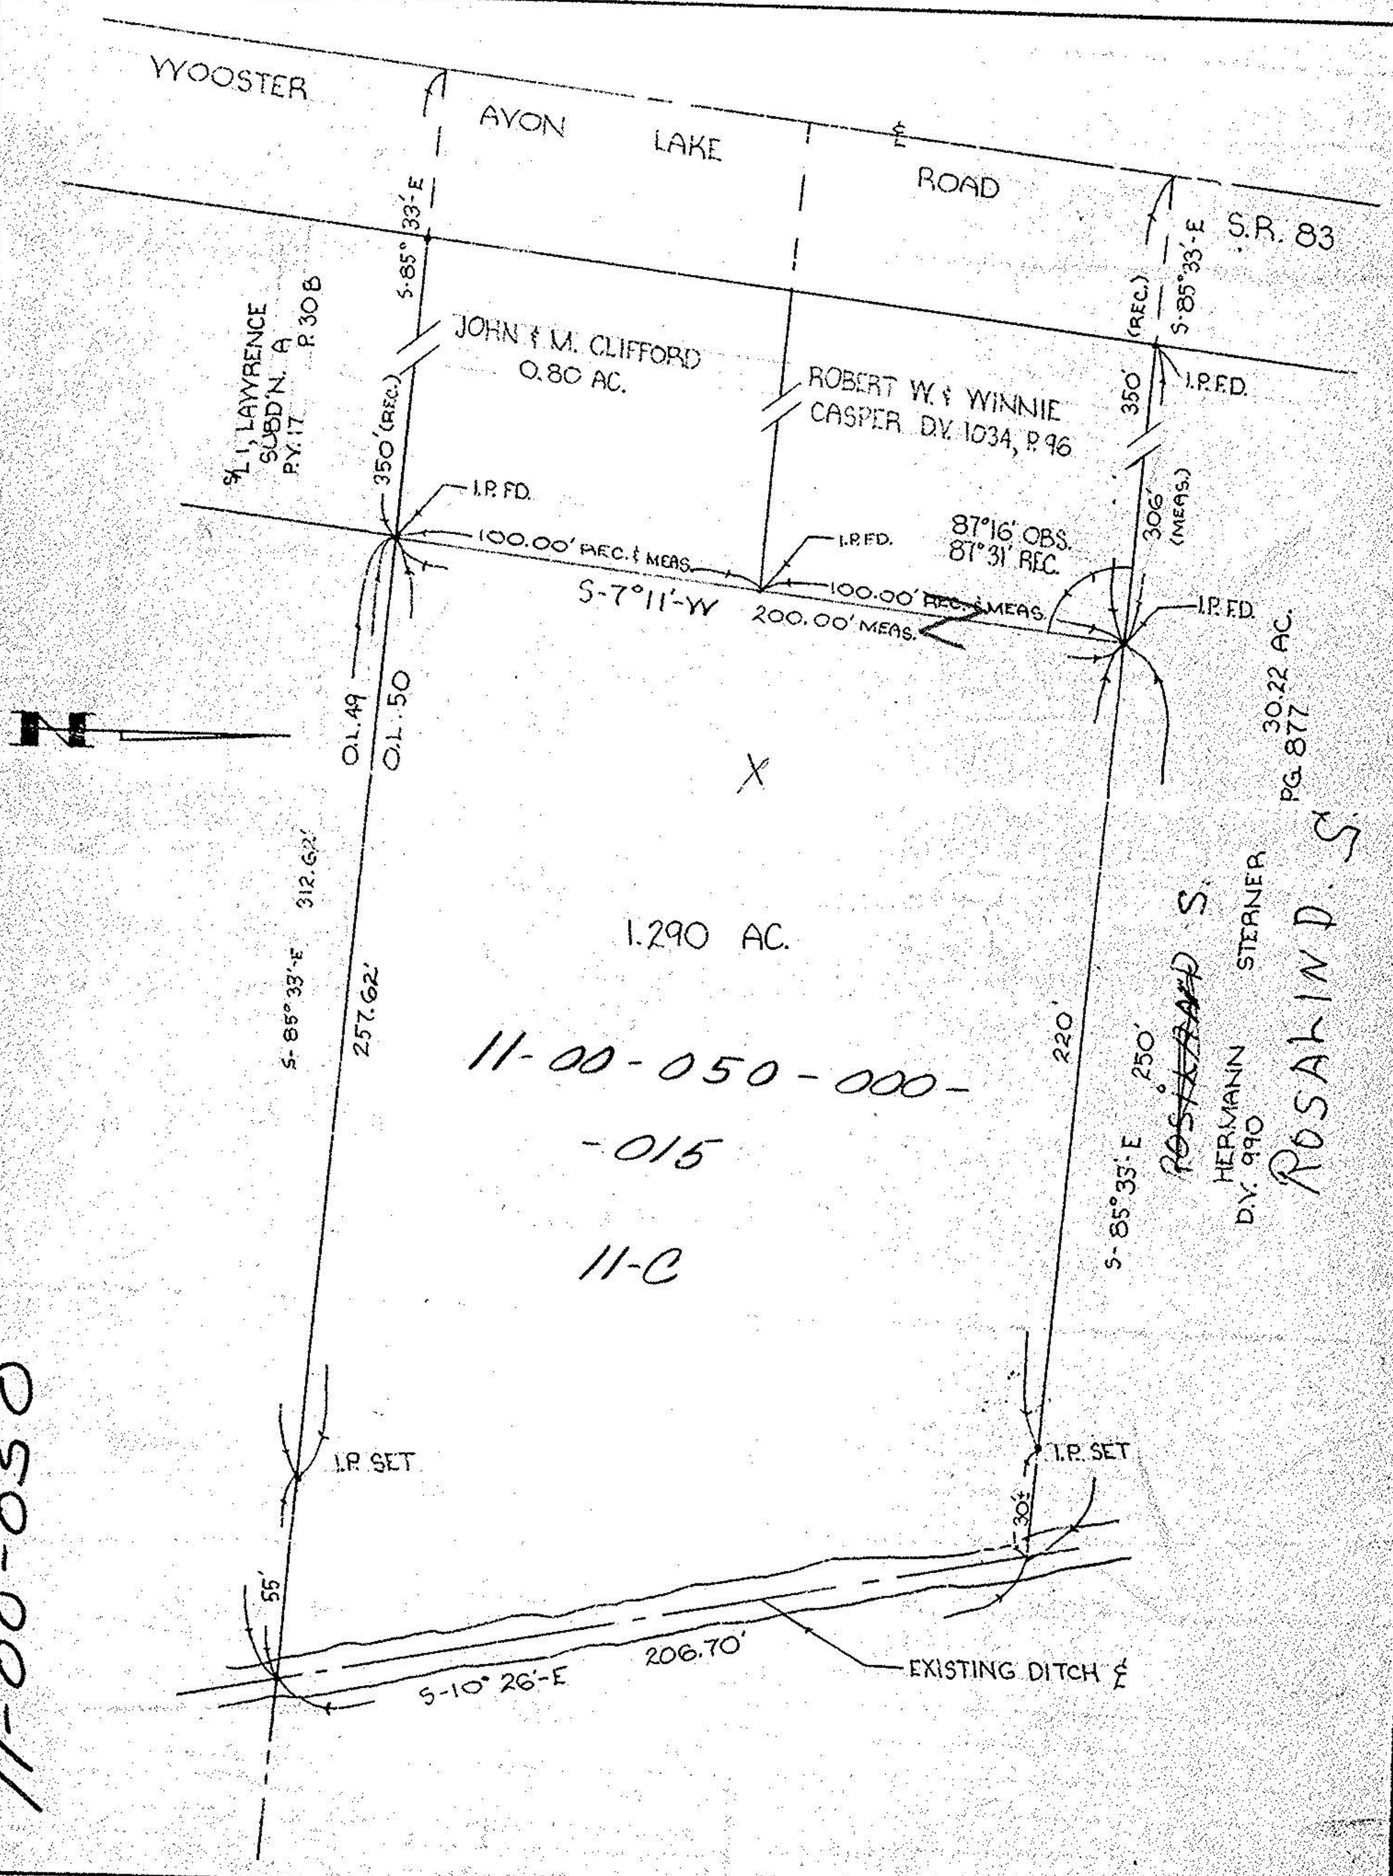

11-00-050

Prepared for: HERMANN STERNER

Scale: 1"=50'	Date: 7-22-75	Dr. by: M.T.M.	Job No 75-149