



11-00-049

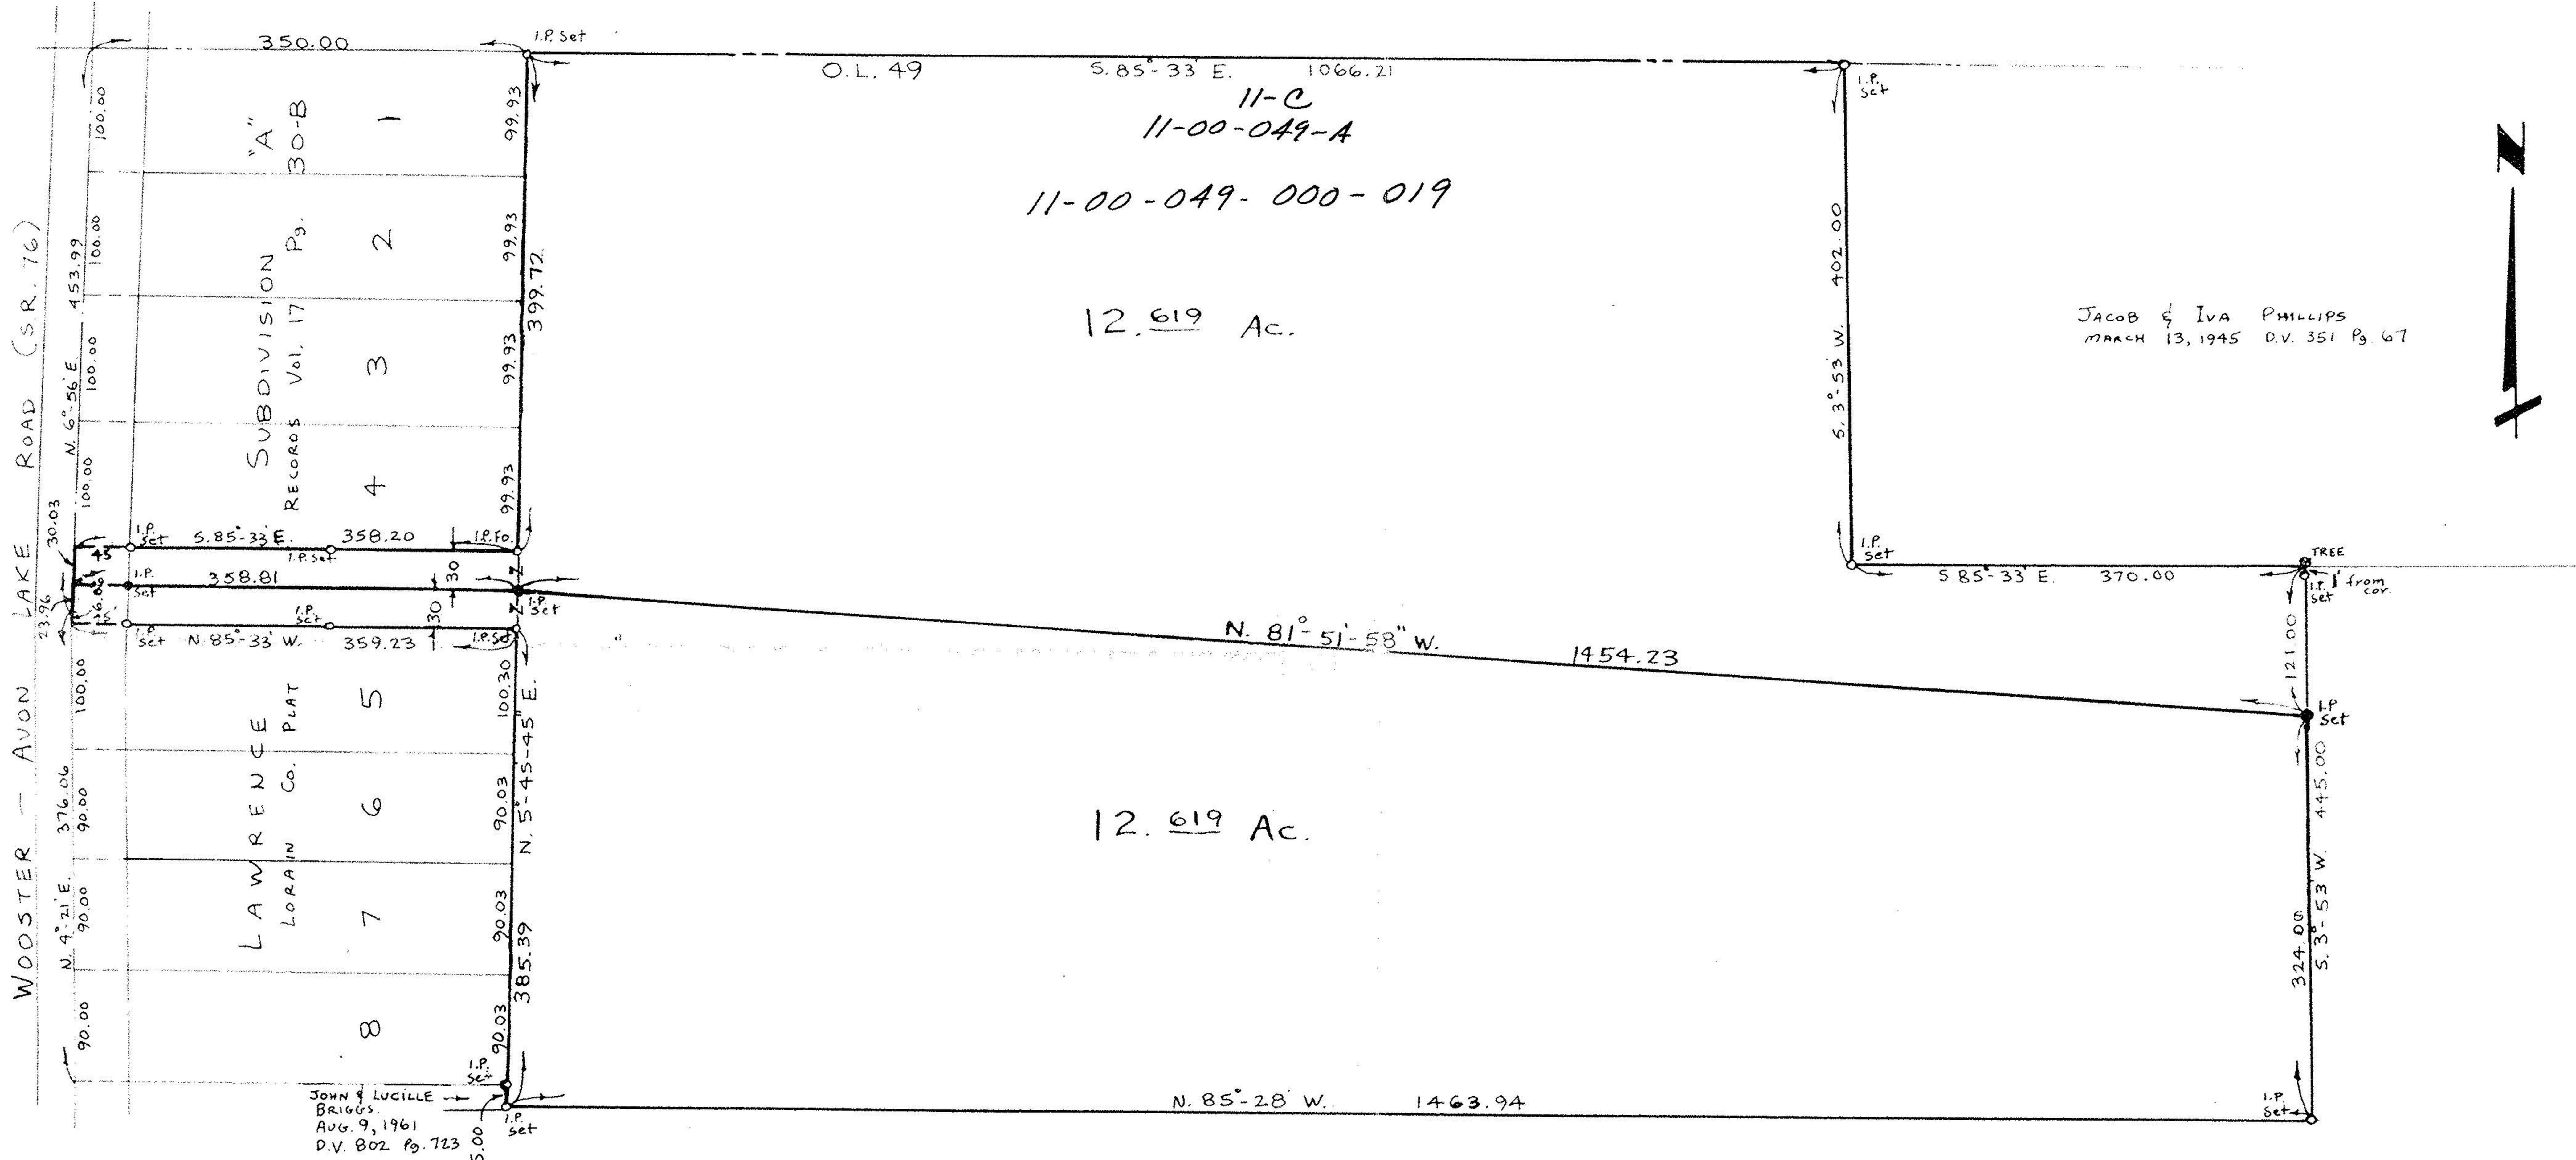

JACOB & IVA PHILLIPS  
MARCH 13, 1945 D.V. 351 Pg. 67

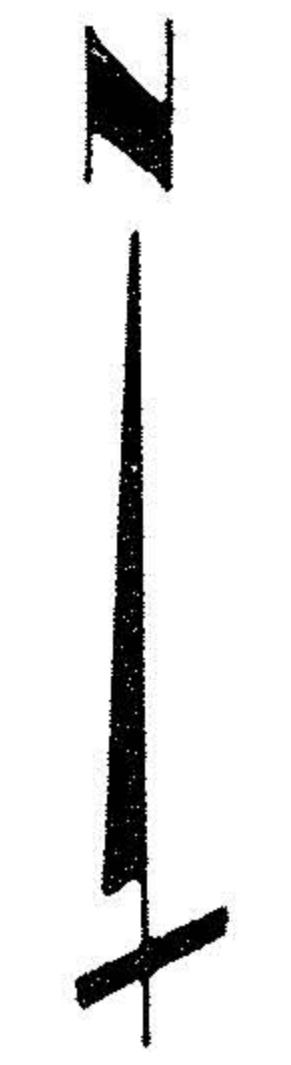

SURVEY OF LAND IN ORIGINAL LOT NO. 49,  
EATON TOWNSHIP, LORAIN COUNTY, OHIO FOR  
FREDERICK E. & HELEN V. LAWRENCE.

RICHARD W. & HELEN J. GLASCOE  
D.V. 925 Pg. 317 APRIL 26, 1966

ELYRIA, OHIO  
LAUNDON, HOFFMAN & SIMON - REG. ENG. & SURVEYORS  
SCALE 1" = 100'  
APRIL 30, 1970

11-00-049