LAUNDON . SIMON . CAHL & ASSOC. INC.
CONSULTING ENGINEERS & SURVEYORS
219 COURT ST. ELYRIA, OHIO 44035

SURVEY FOR THE:

EATON TOWNSHIP TRUSTEES

Orig. Lot 45	City of	Date SEPT. 12, 1986 Scale 1"=100'
Orig. Sec	Village of	Dwn. by R.G.S. Chkd. by C.J.
Tract	County of LORAIN	Job No. 86-1528 F.B.
Township of EATON	State of OHIO	Printed

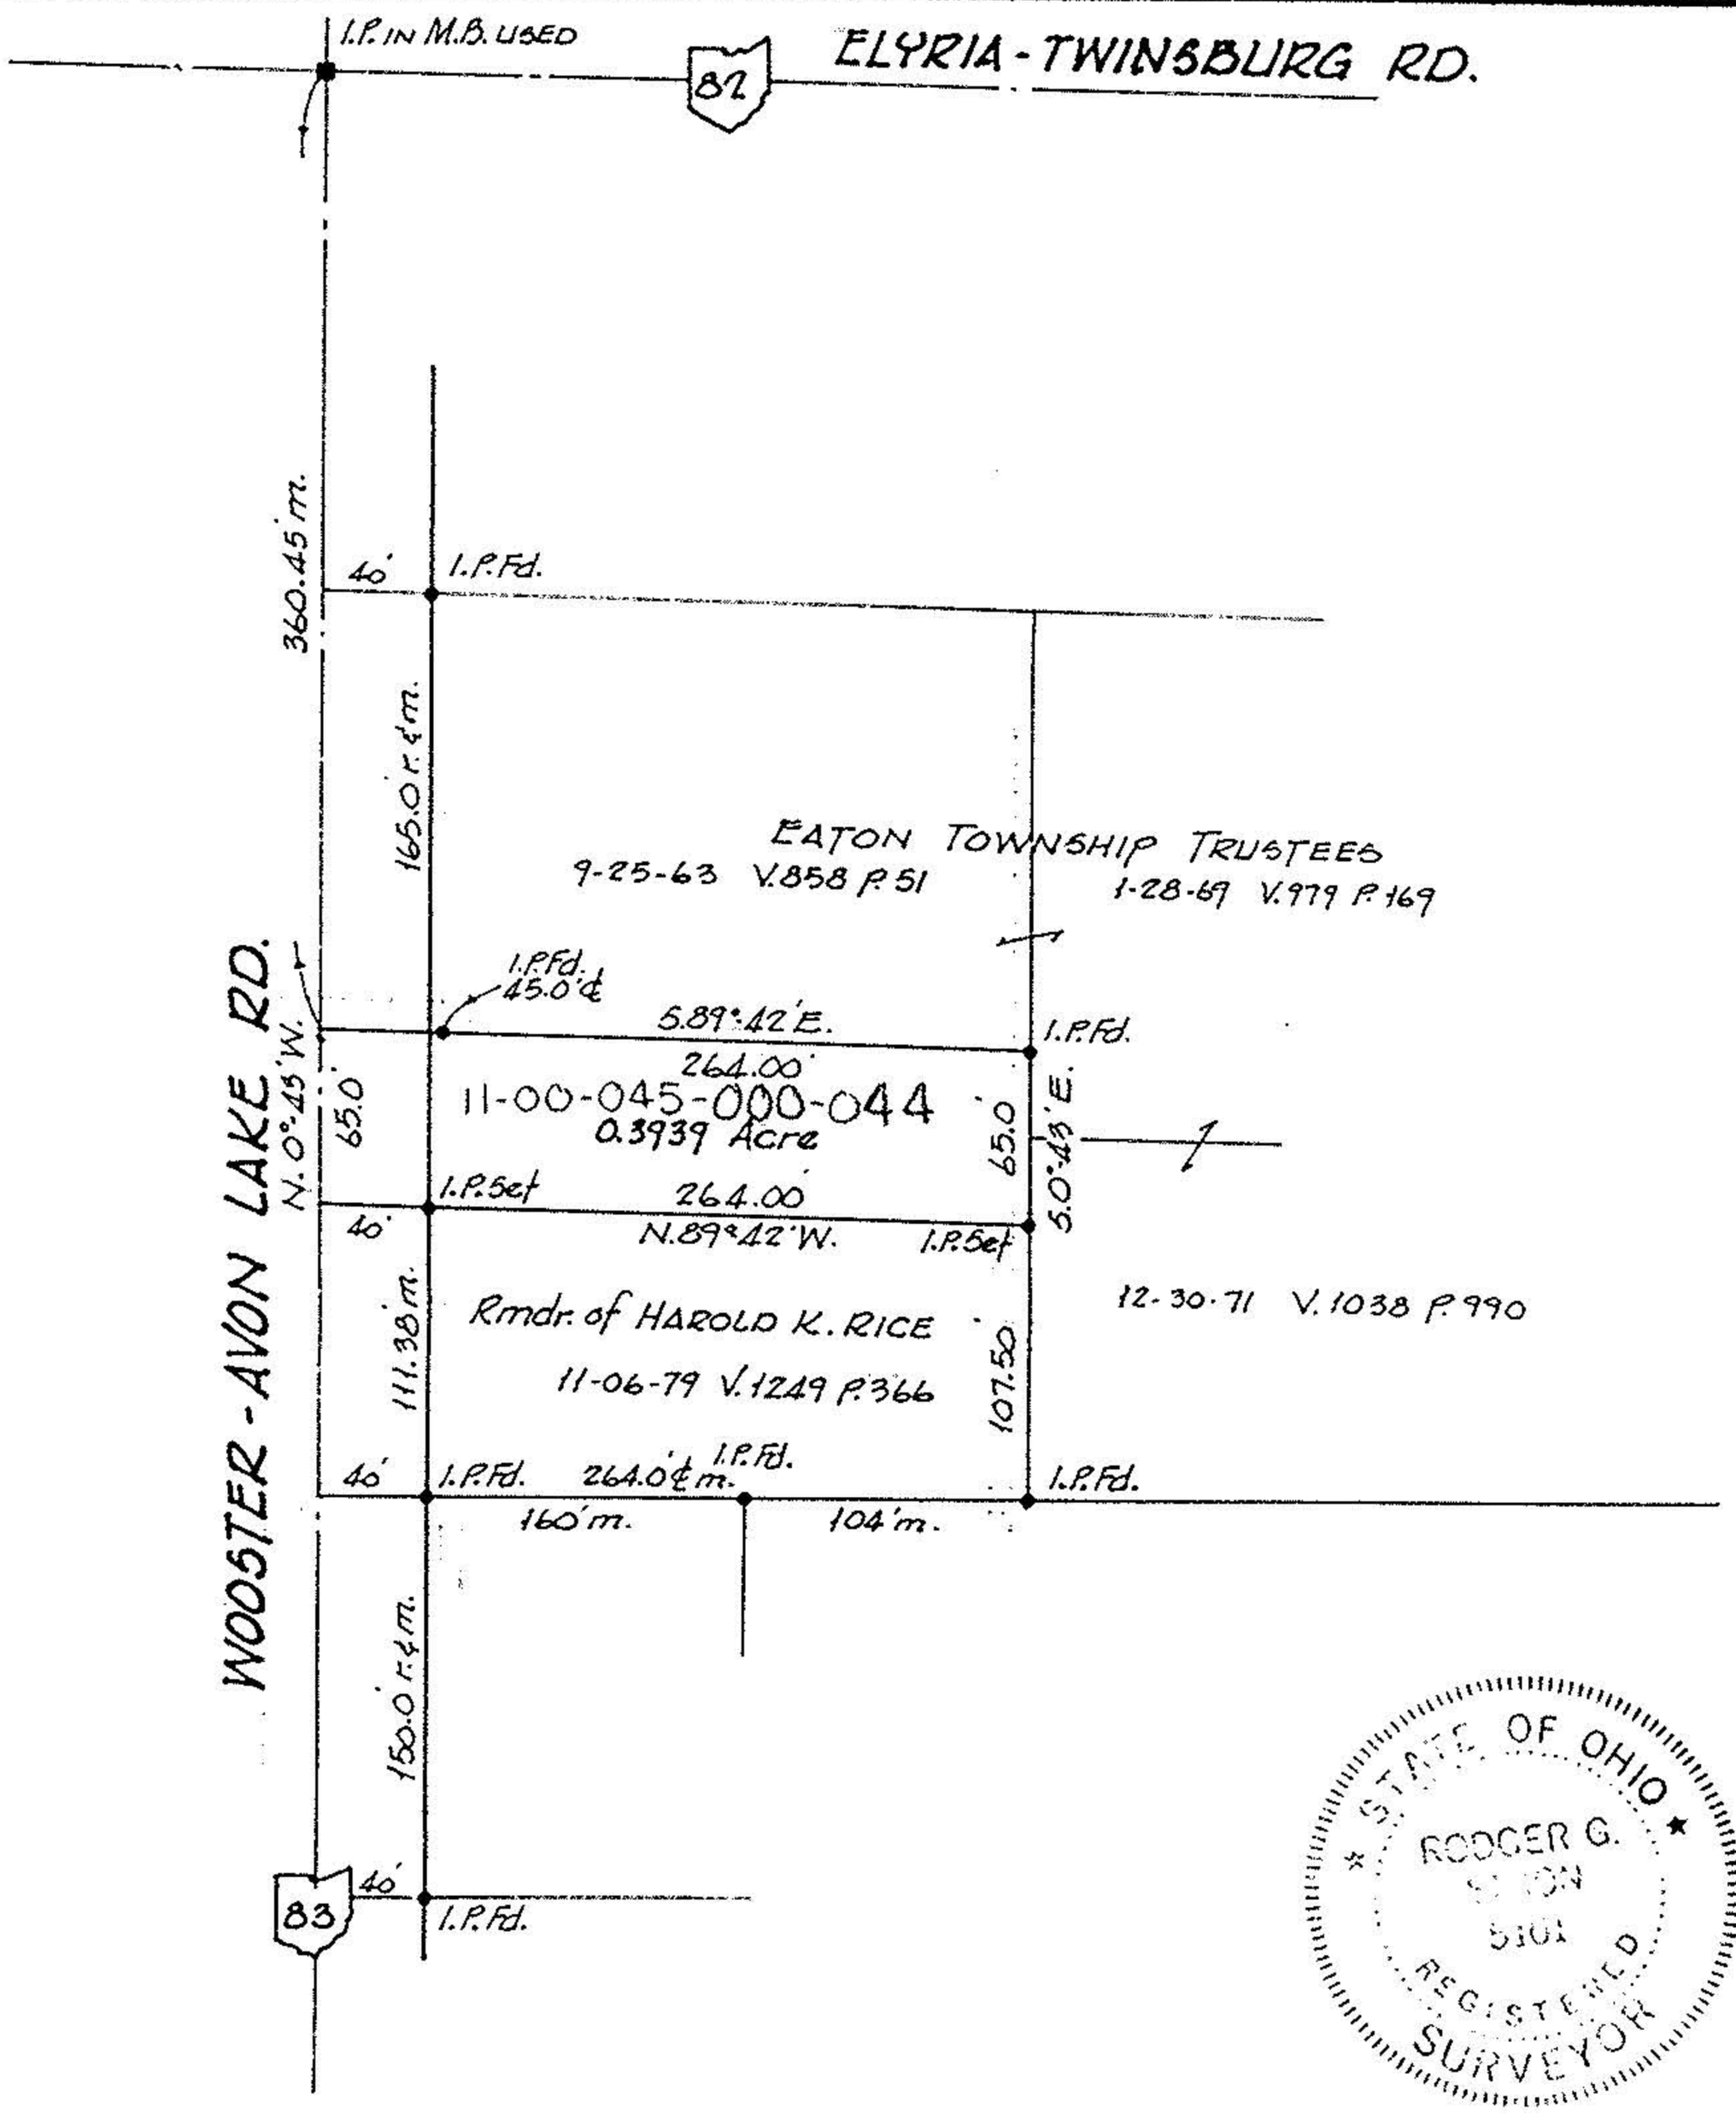

STATE OF OHIO
ROGER G. SIMON
5101
REGISTERED SURVEYOR