

John T Zitello  
OR 2 Pg 649

Leland Purkee  
OL 47  
OL 34

1.777 Acres

Michael & Mona Sauter  
OR 495 Pg 76

Remainder by Auditor  
22.541 Acres

Richard & Pamela Pierce

James & Mary Dove  
OR 47 Pg 472

OL 34

0.346 Acre  
Total 1.303 Acres  
0.090 Acres

THIS ACRES TO BE  
CORRECTED TO

0.08 Acres Perce  
ON MAP and deed

(PER J. POZYWAK PHONE CALL)


-040 Terry Spriesterbach  
Remainder by Auditor  
0.958 Acre

- iron pipes fd
- iron pipes set
- Monument boxes

Parcel Splits

Map of Survey for  
Mike Sauter  
Part of Original Lot 34  
Eaton Township  
Lorain County Ohio  
Scale as noted Sept 1992  
1.777 Ac parcel Nov 92 Oct 92

John Pozywak  
Reg Surveyor  
5292

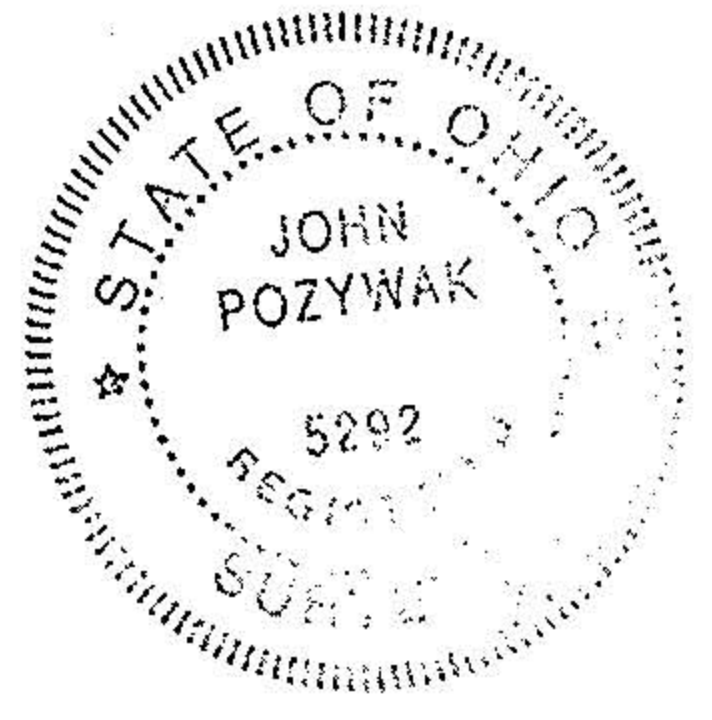

20244

APPROVED LORAIN CO. MAP DEPT.	
DATE	2-10-93
PAGE	11-C
BY	CAROLYN FRANCIS
VOID AFTER	# 20244