11-00-031
11-C

11-00-031-000

PLAT OF SURVEYS FOR KATHERINE C. WHITTY

ORIGINAL LOT 31 - EATON TOWNSHIP
LORAIN COUNTY OHIO
SCALE: 1"=100' OCT. 19-1963
Gary E. Penfound Reg. Surveyor No. 4457
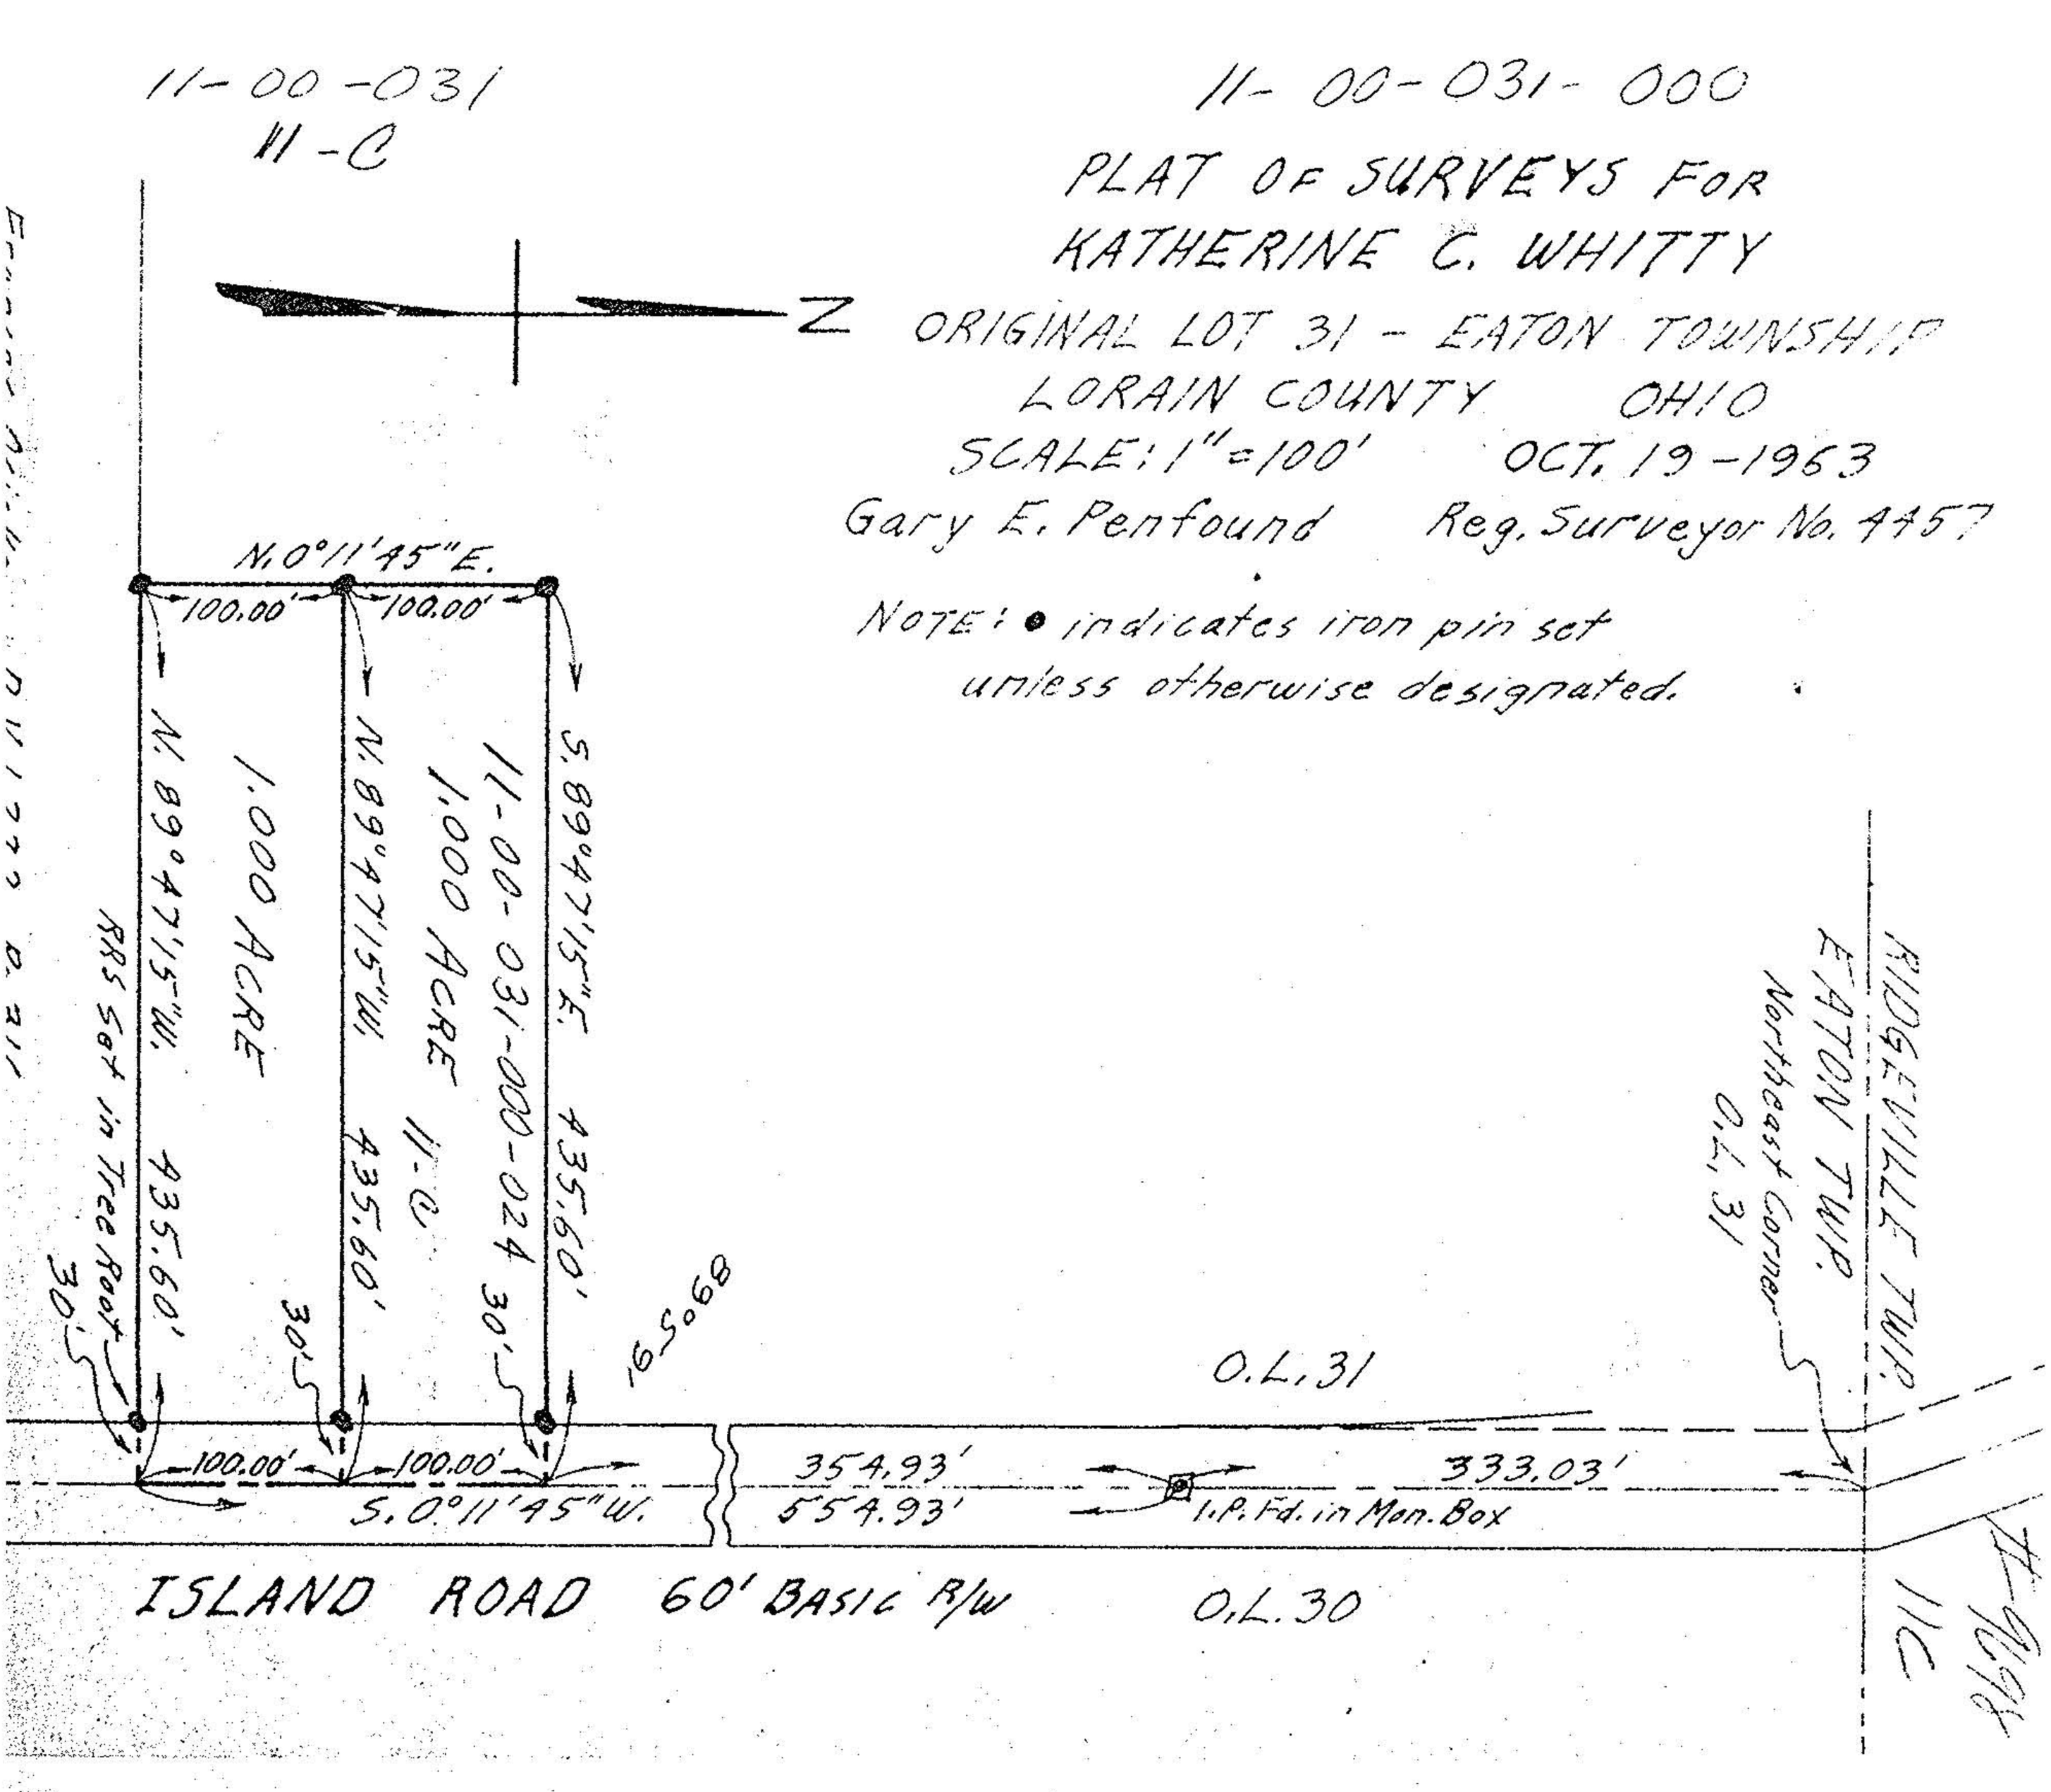
NOTE: ● indicates iron pin set unless otherwise designated.